

21

20

19

18

17

16

15


14

13

12

11

Ath. Ofnaskrá, sjá teikningu nr. 8R-25

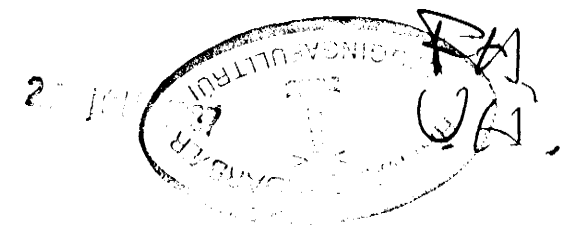

Fj.	Heiti	Hl.nr.	Taika nr.	Efni	Ath.
Dags	Leibrétting	Dags		Leibrétting	
Breyting					
7 4 '87 BREYTT TIL SAMR VANDANL PÍPUL					
<b>VERKFRÆDISTOFA</b> <b>GUDMUNDAR &amp; KRISTJANS</b> Laufasvegur 19 Sími 14425				Máv.	Verkt. JGE.
				1:50	Teikn. GS.
					Yfirf.
					Samþ.
<b>KIRKJA VÍÐISTAÐASÓKNAR</b> GRUNNMYND HÆÐAR OFNA- OG HREINLÆTISLAGNIR				Dagbok nr. <b>TEIKNING NR</b> <b>8R-20A</b>	Verkt. blöð af