


GRUNNPLAN  
 KLASS 1:50

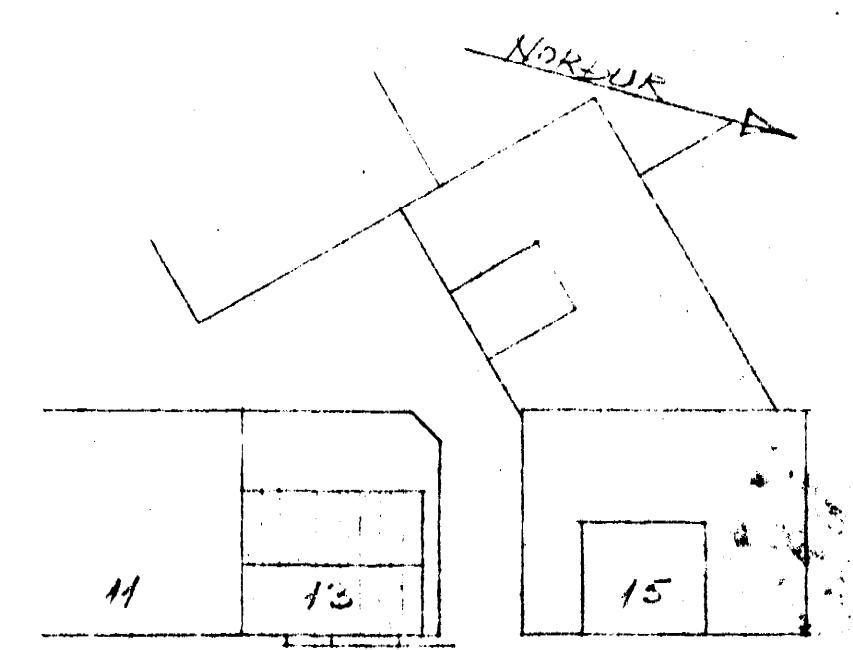

GARDAVEGUR  
 - AFSÖUMYND  
 KLASS 1:500  
 HAFNARFJARDARBER  
 4. nóv. 1971  
 BYGGINGARULLTRÚNN

GARDAVEGUR 13  
 SKOPLÖGN I GRUNNI

Bl. 2

Hafnarfjarðar 4. ágúst 1971  
 Þórunn Torgersen

BREYTT 1. OKT. 1971, Þ. J.