




Samþykki þann

09 JAN. 2001

Byggingatulltrúinn í Hafnarfirði
F.h. Kristján Þórarinnsson

KJP

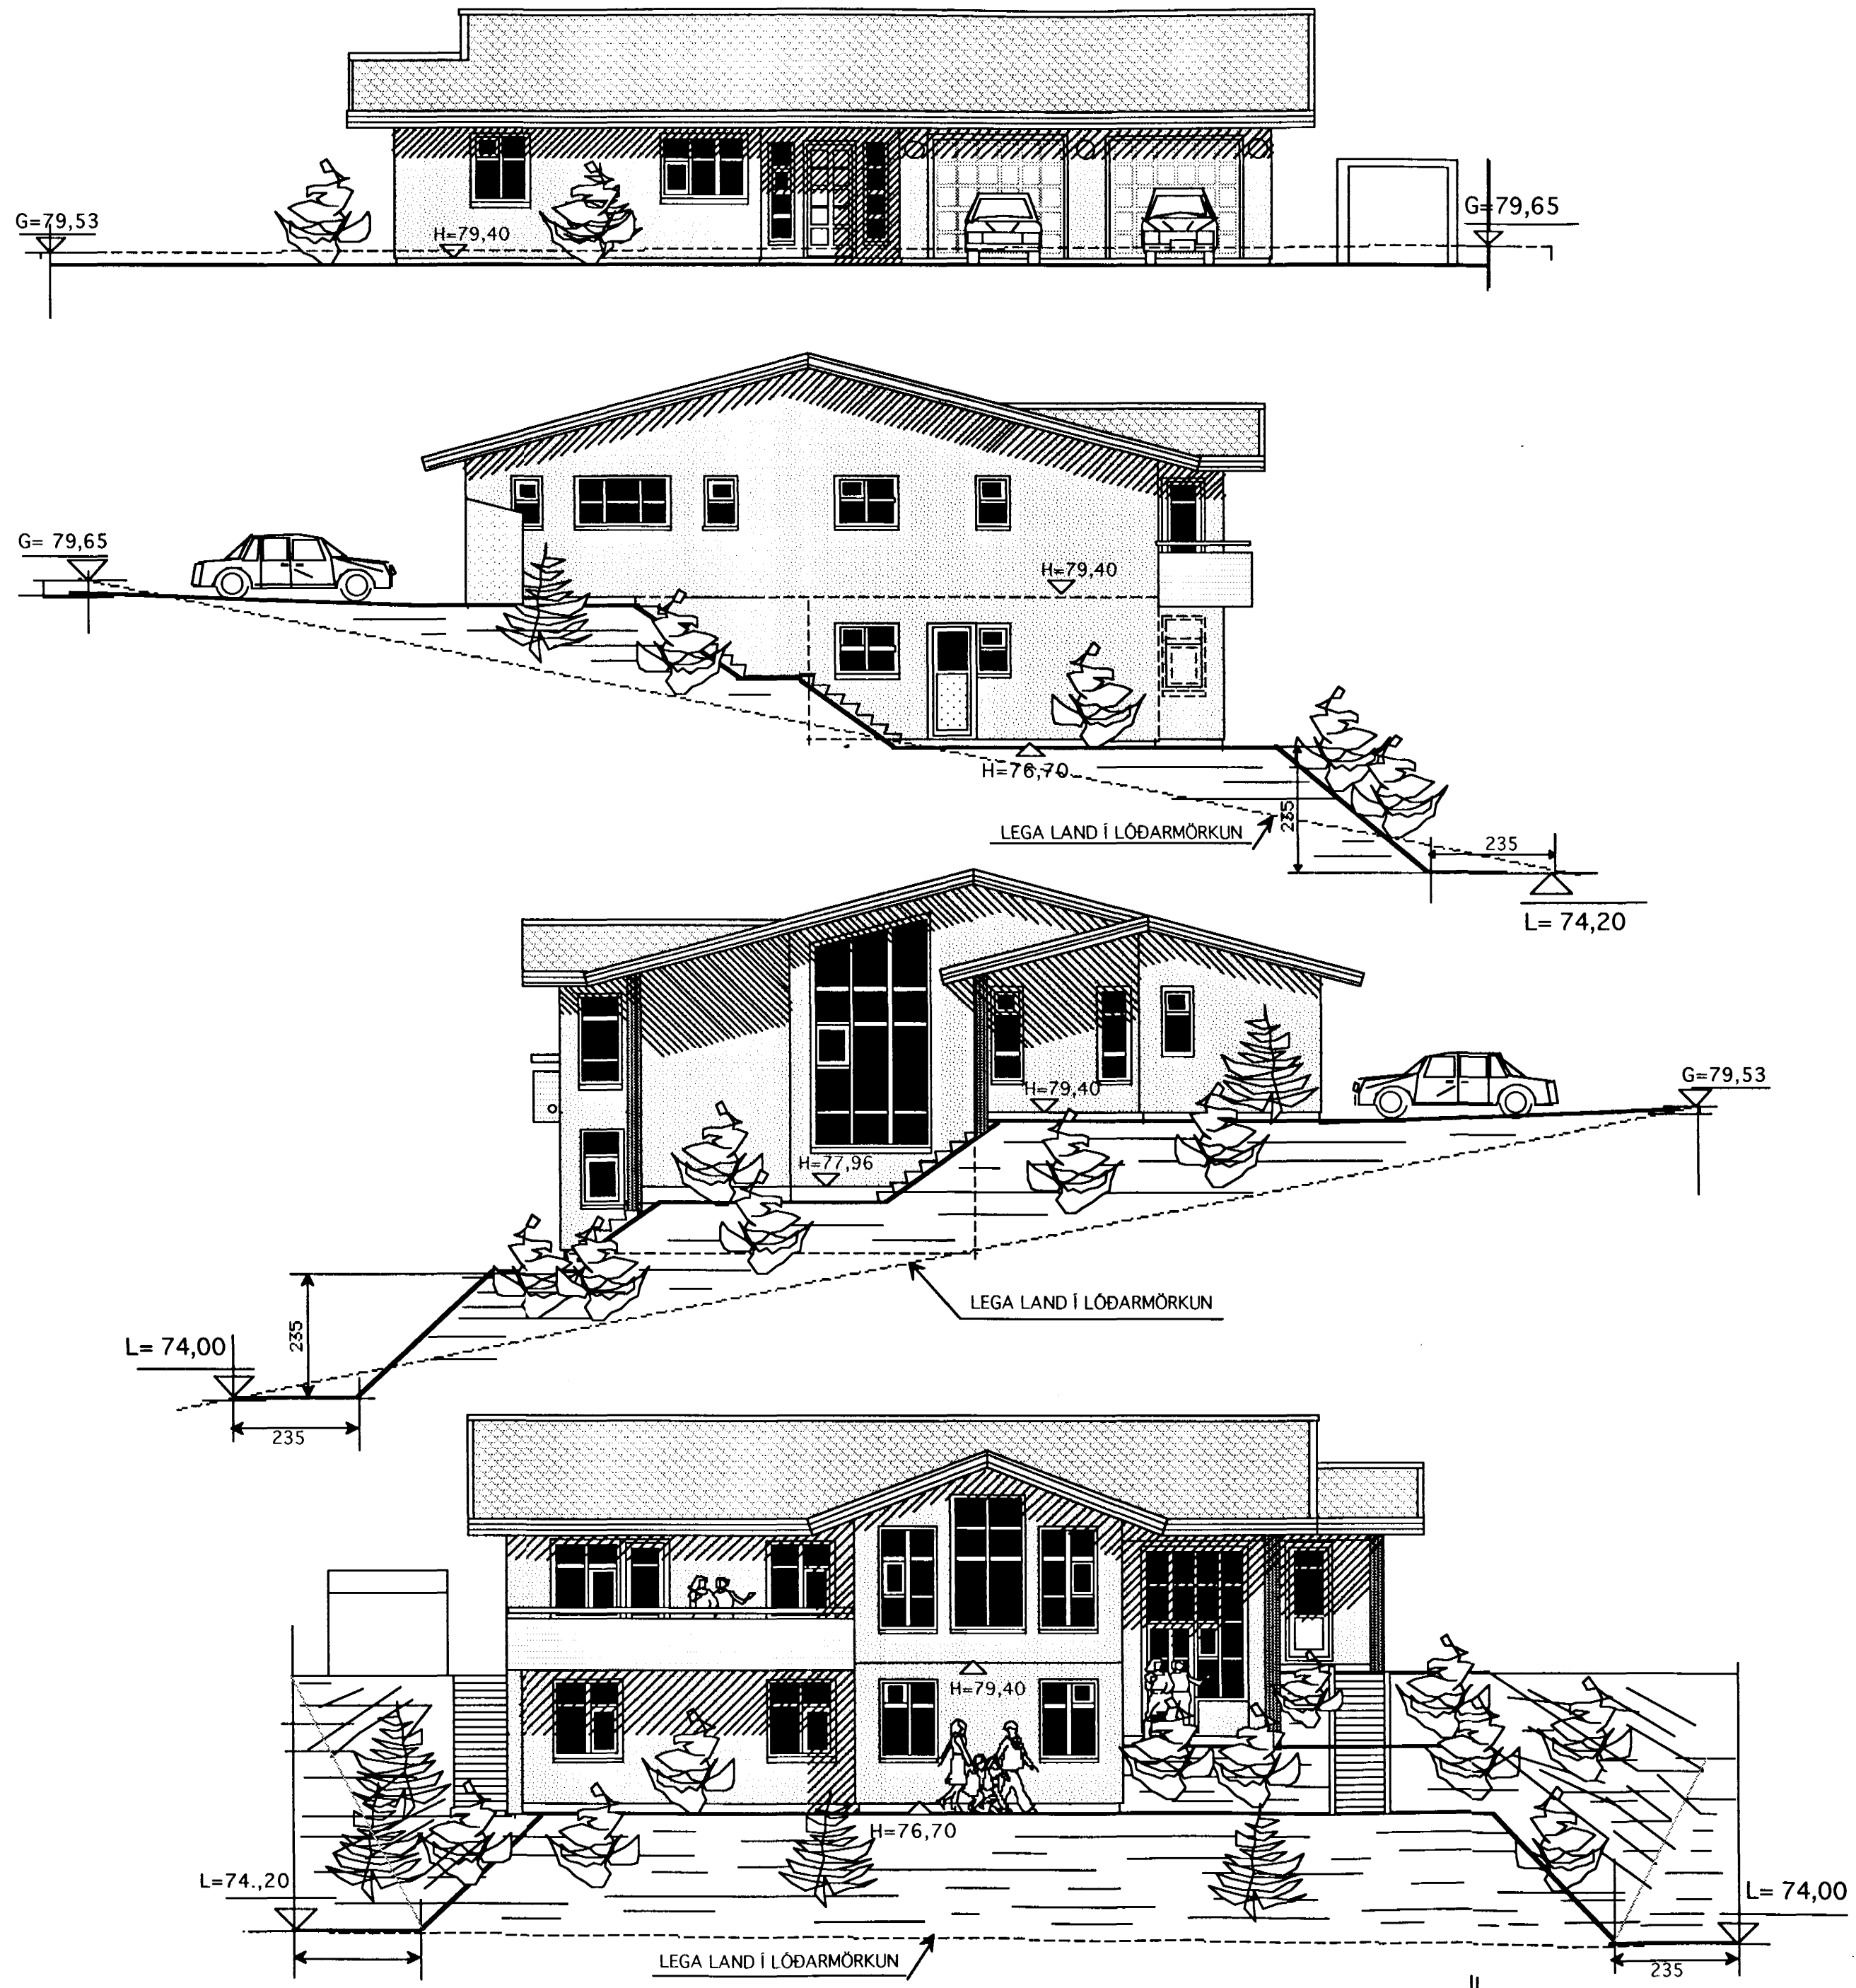

BREYTT 4. JAN. 2001
Breytt samkv. minnisþingum K.Þ. dags. 29.12. 2000



Verkefni
GAUKSÁS 27
HAFNARFIRÐI
Heiti
ÚTLITSMYNDIR.

kvarði	1:100	verk.nr	200056
dags.	21 NÓV..2000	dags br.	4. JAN.2001
hönnun	G. G.	teikn nr	A-3
teikn	G. G.		

Hringbraut 17 220 Hafnarfirði
s. 555-2020 FAX 555-2021
Gísli B. Gunnarsson BFI kt. 020649-2409