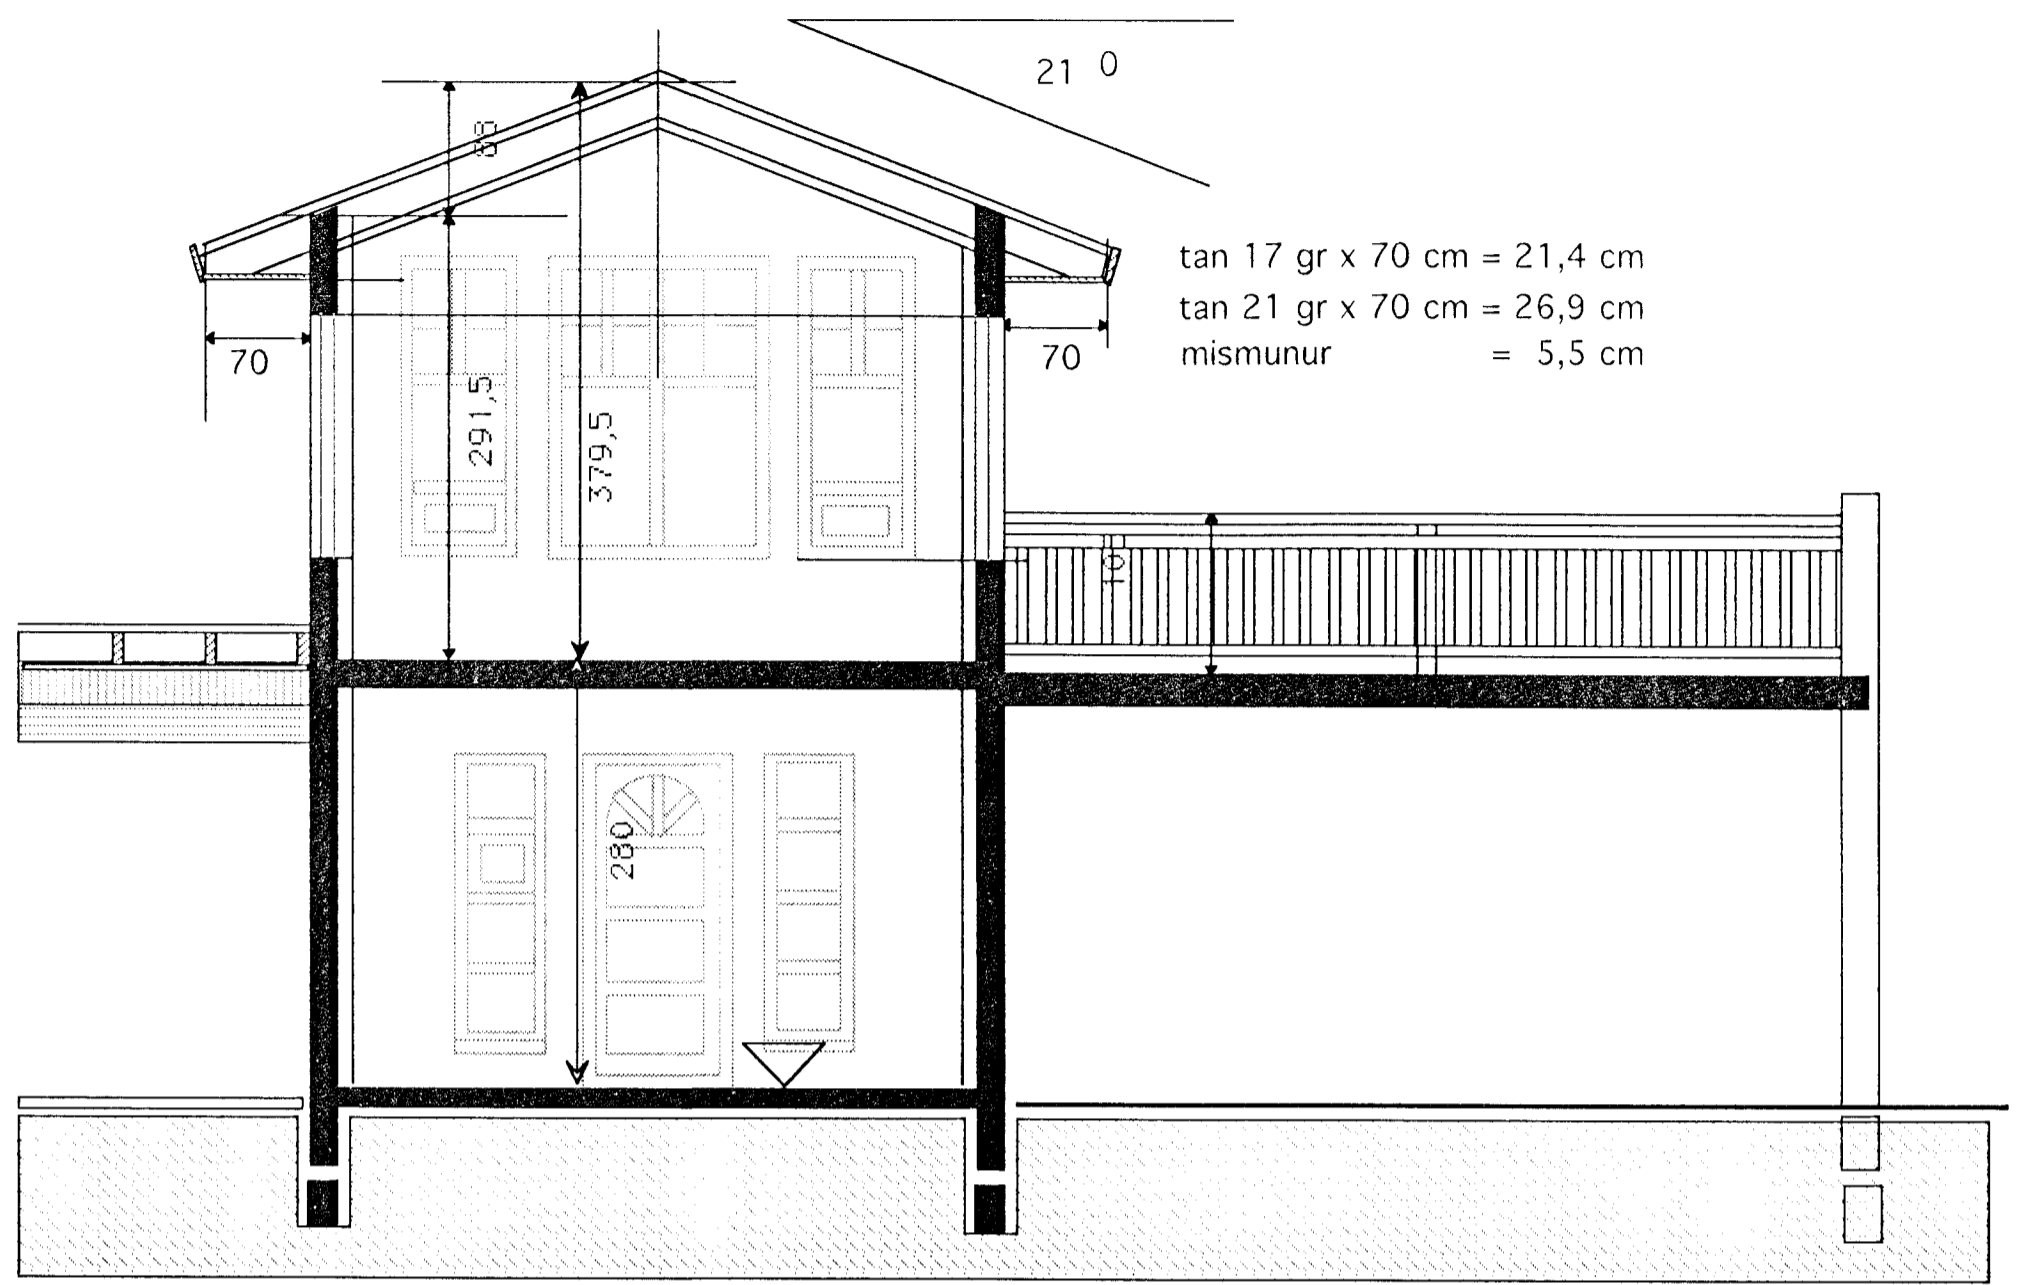
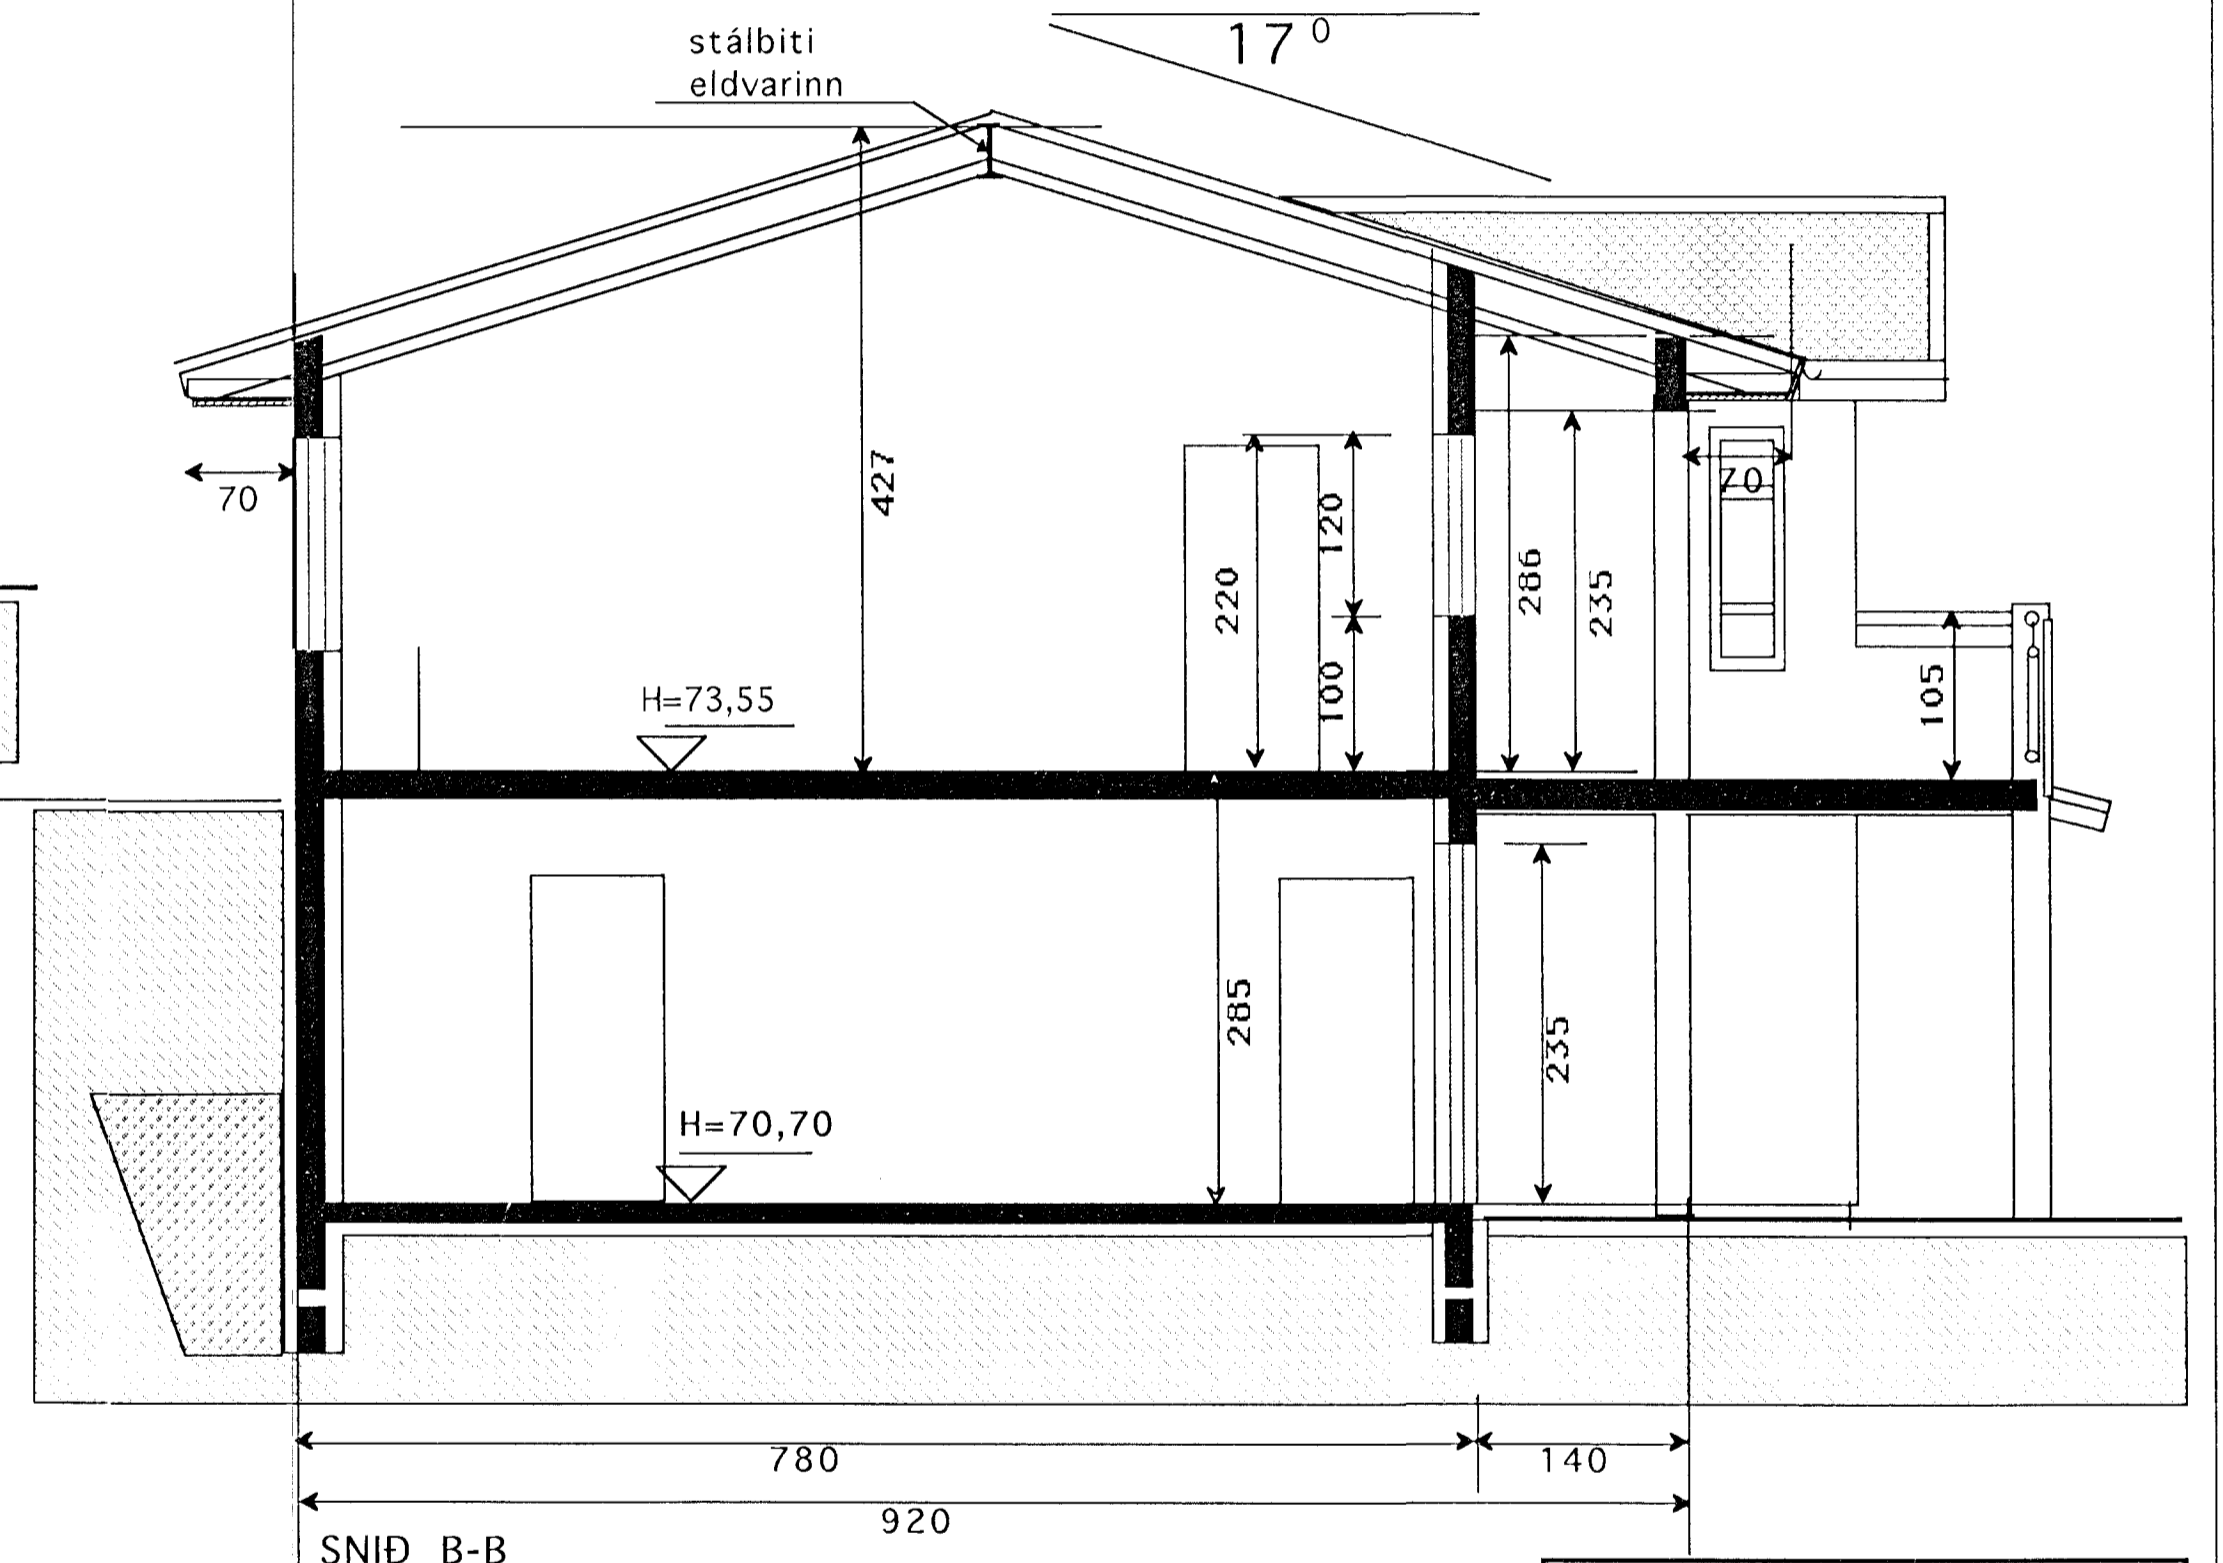

 28 MAI 2002
 VG




$\tan 17 \text{ gr} \times 70 \text{ cm} = 21,4 \text{ cm}$
 $\tan 21 \text{ gr} \times 70 \text{ cm} = 26,9 \text{ cm}$
 mismunur = 5,5 cm

SNID B-B



SNID B-B

TEIKNISTOFAN  KVARDI	Verkefni	GAUKSÁS 45 HAFNARFIRÐI
	Heiti	SNID
kvarði	1:50	verk.nr
dags.	des 01"	dags br.
hönnun	G.G.	teikn nr
teikn	G.G.	V-4

Hringbraut 17 220 Hafnarfjörður.
 S. 555 2020 FAX 555 2021
 N.F. kvardi@vortex.is

Gush Gunnarsson