


GRUNNMYND 1.HÆÐ 1:100

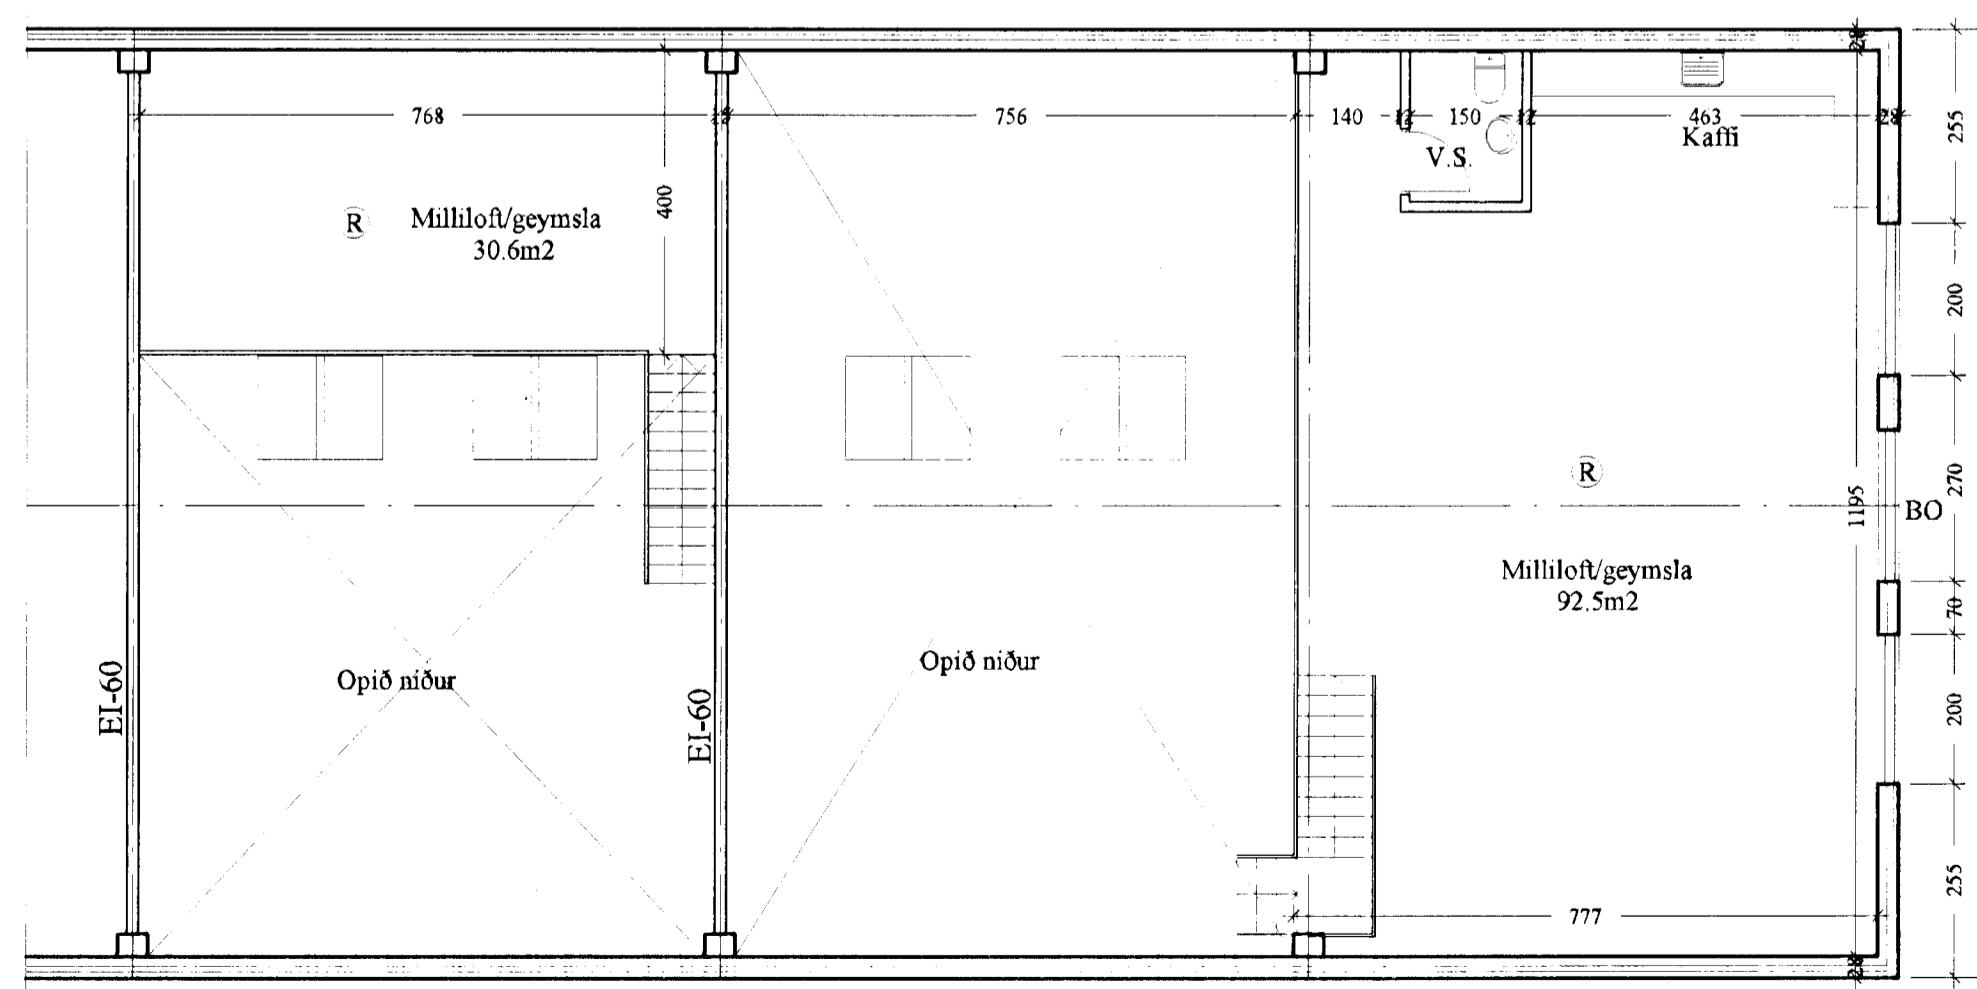

GRUNNMYND MILLILOFT 1:100

Dags. 11.11.2011 Breytt
 Inna skipulagi í einigum 0104 og 0105

Reyndarteikning

verkefni
Gjótuhraun 7

henta teikningar
 Grunnmyndir m.b.v. T:100
 dags. 13.9.2006 Nr. **A 102**

Ársæll Vignisson Arkitekt
 kt. 101255-3369
 Hámarborg 7
 200 Kópavogur 8440255

12.6.2012 Ársæll Vignisson