


SKÝRINGAR:

- 1 DAGSTOFA, BORDSTOFA
- 2 HÚSBÓNDHAERBERGI
- 3 BARNHAERBERGI
- 4 BARNHAERBERGI
- 5 SAUNNA
- 6 HJÓNAERBERGI
- 7 BADHAERBERGI
- 8 ELDHÚS
- 9 BORDKROKUR
- 10 FORSTOFA
- 11 LEIKHAERBERGI
- 12 FATAGEYMSLA
- 13 ÞVOTTAHÚS, GRÓFELDHÚS
- 14 WC
- 15 ANDDYRI
- 16 GEYMSLA
- 17 KYNDIKLEFI
- 18 BÍLSKÚR
- 19 SORP
- 20 SÓLSKÝLI

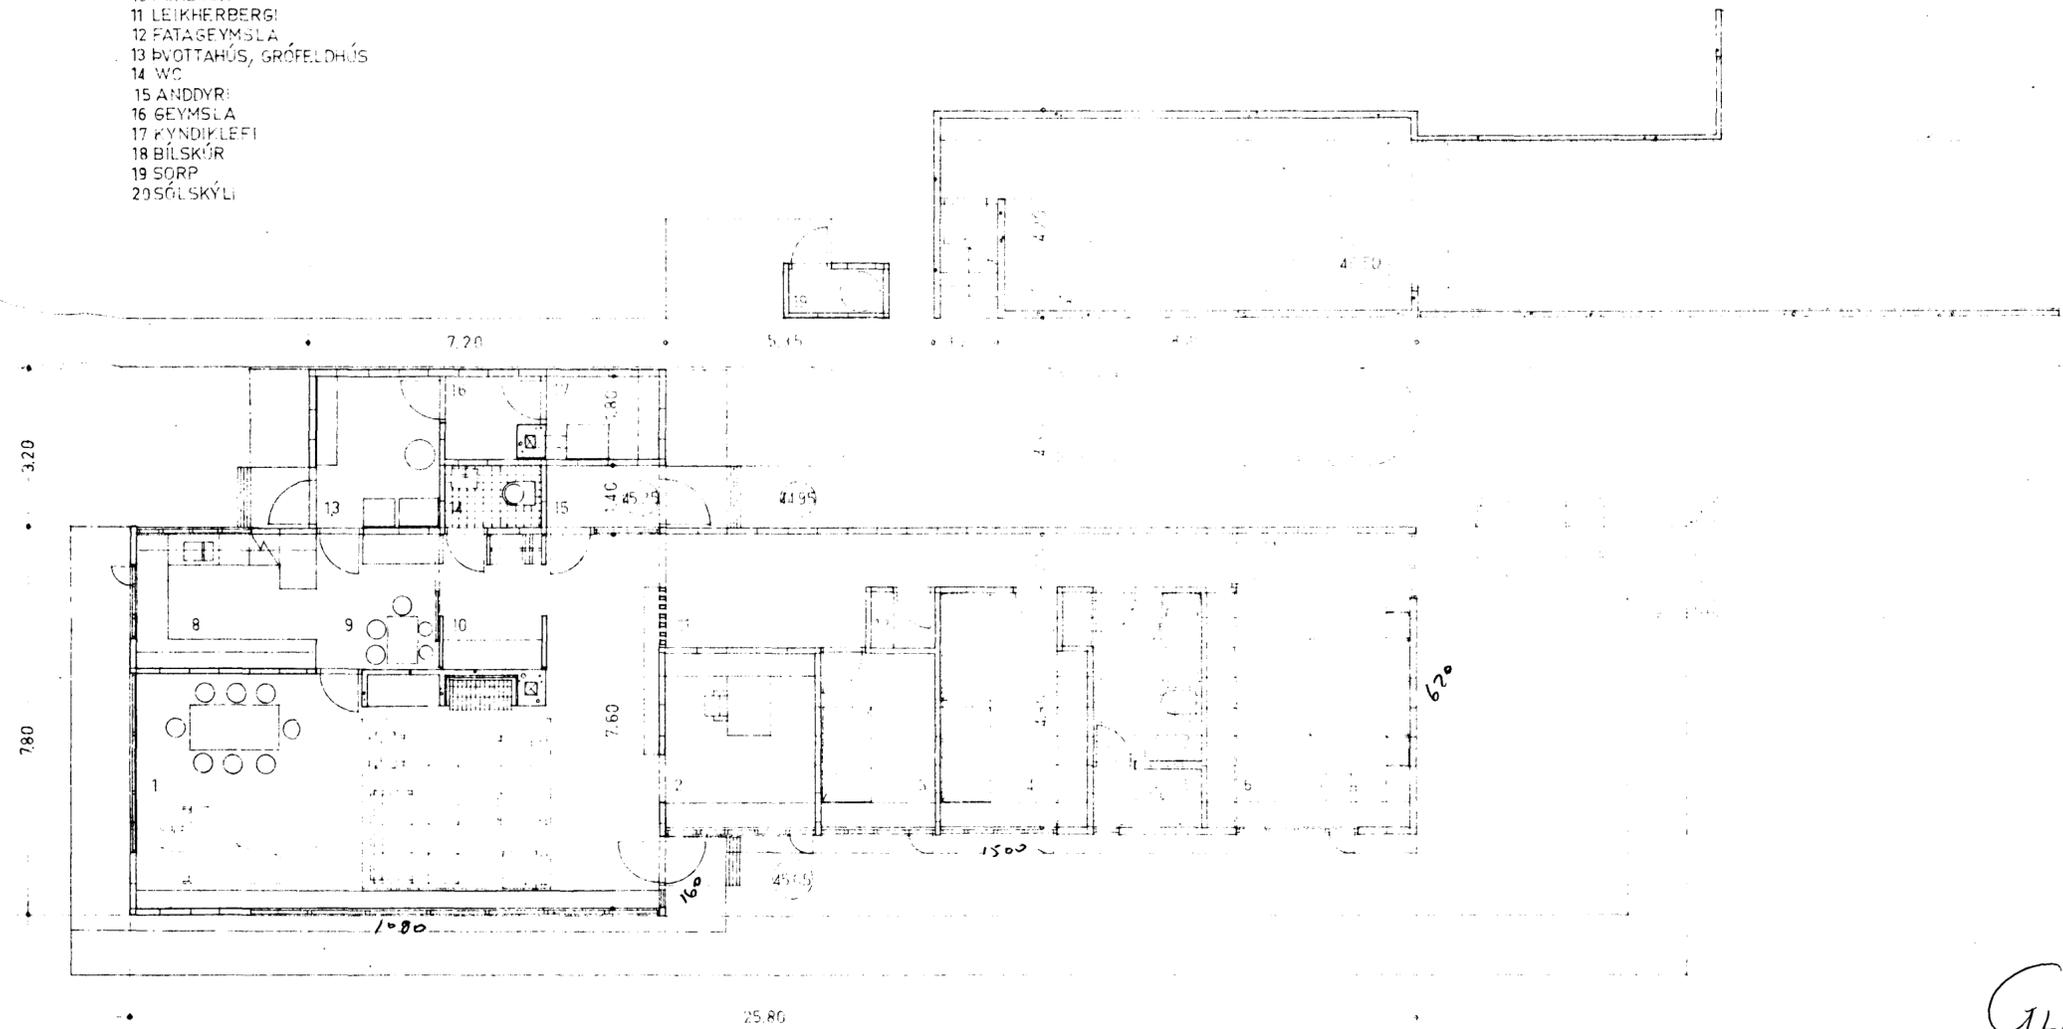

01 sp. 2.5.68

GLITBERG 7  
2740-0070-01

1980  
 $200 \text{ m}^2 + 38 \text{ m}^2$   
 $620 \text{ m}^3 + 95 \text{ m}^3 = 715 \text{ m}^3$   
 615 Bj. kr. 2140.-

ELNEYLIÐHÚS B. THORODDSEN VÍÐ ÁSBERG, GARÐAHEPPA  
 GRUNNMYND 1:100  
 TEKINGAR D. R.VIK, 27.4.1958

*Signature*