



VESTURHLID, M = 1:100

Byggf. hún
Sjá bókun

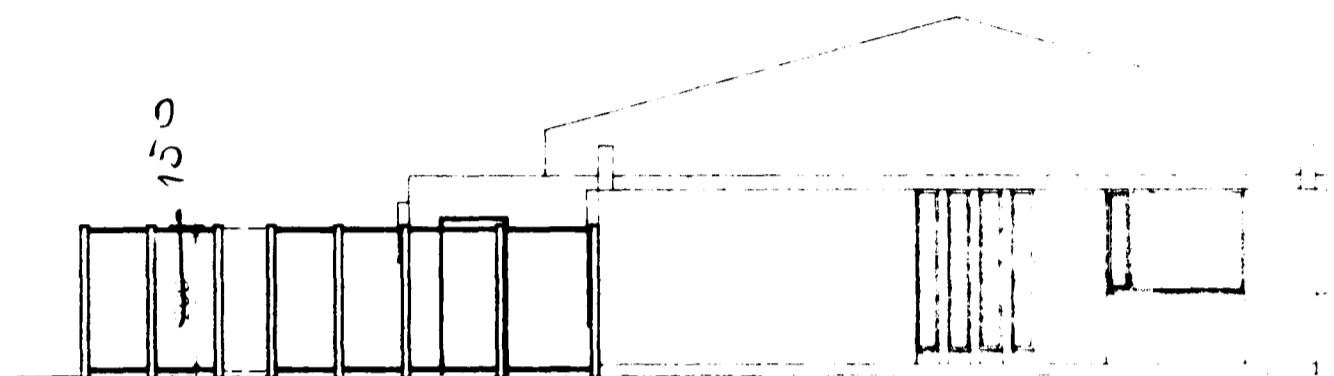


AUSTURHLID, M = 1:100

skildrettar teken i anda
bókunar byggingsmálefudar
dags. 2/7 1997

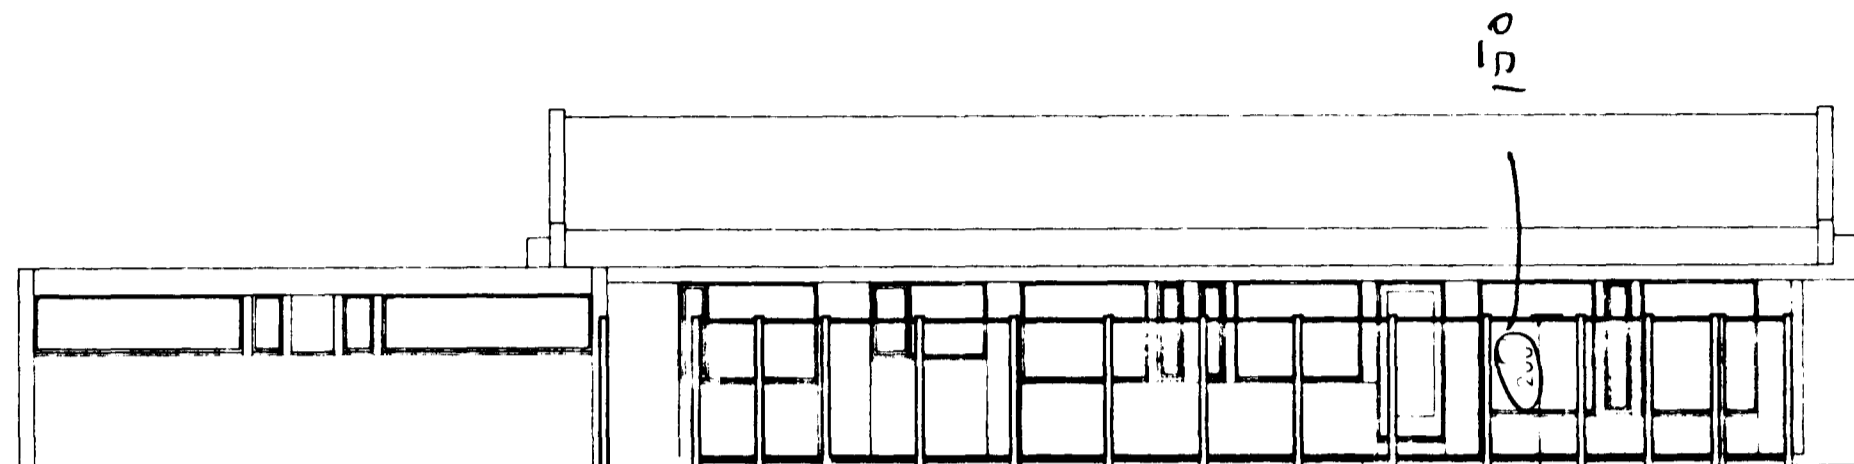

SUDURHLID, M = 1:100

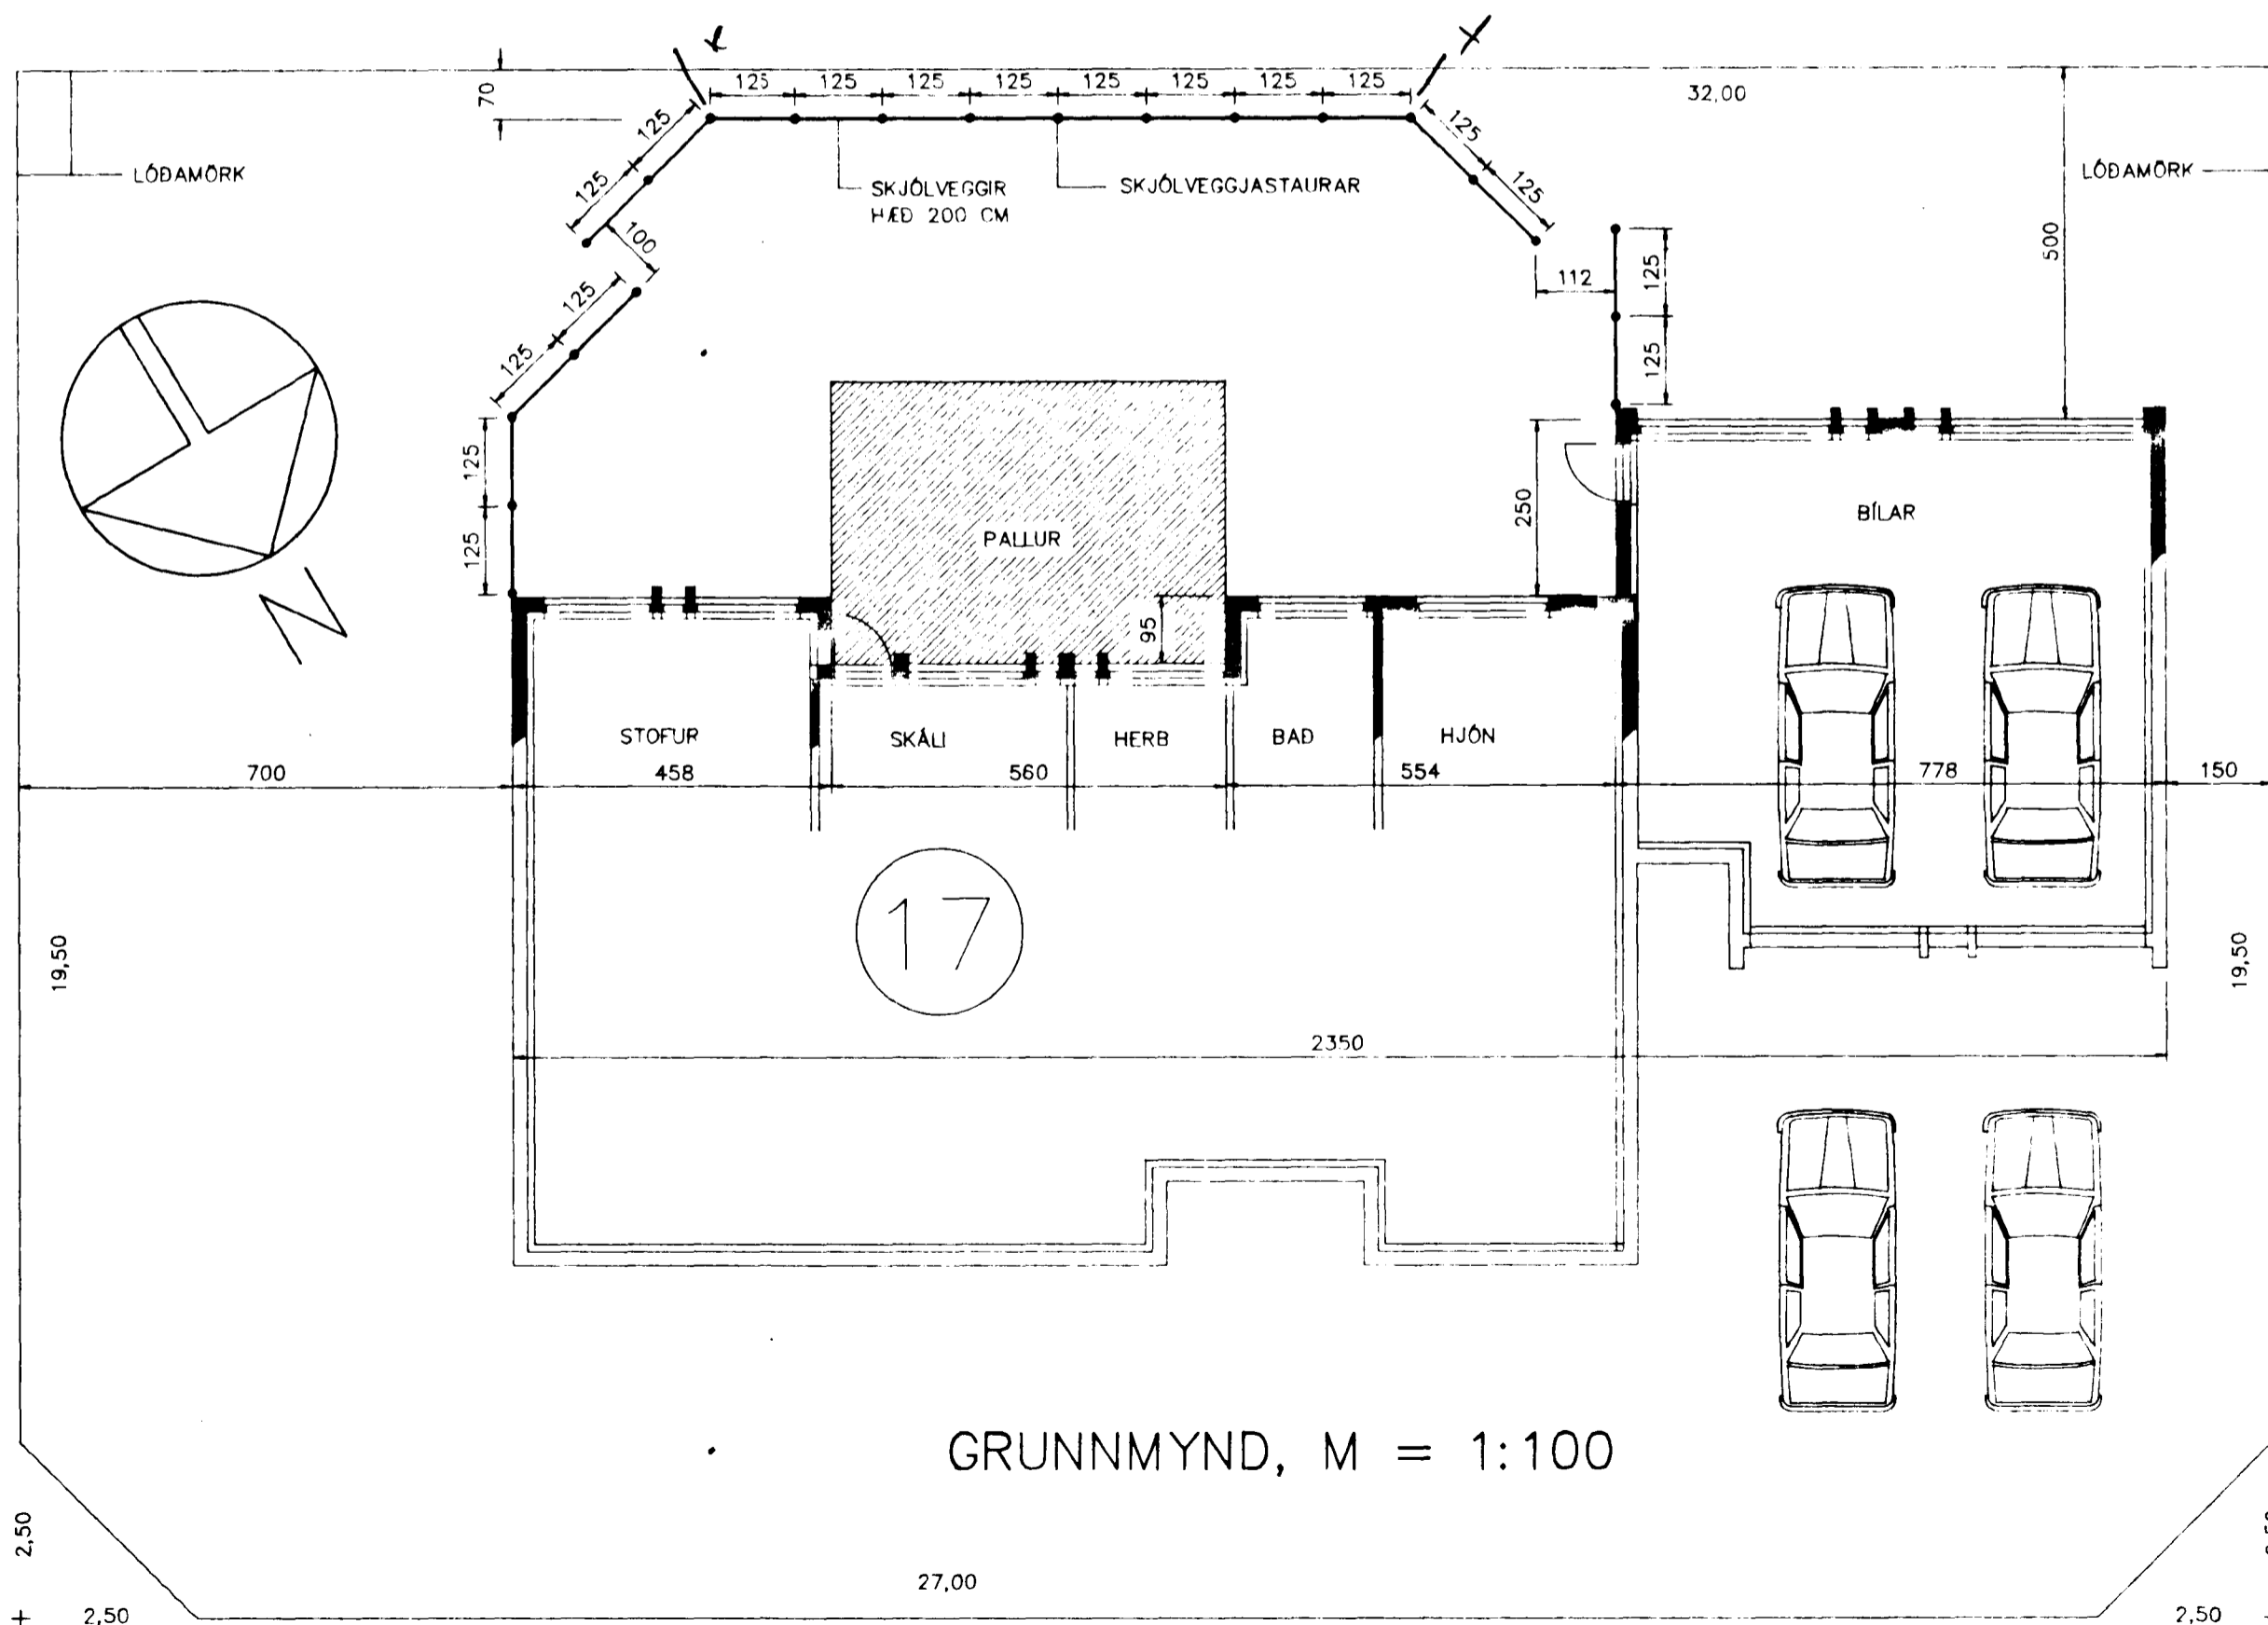

GRUNNMYND, M = 1:100

<i>Anna Magnúsdóttir</i>	