
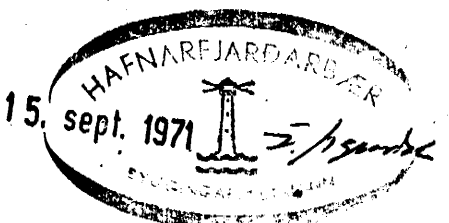



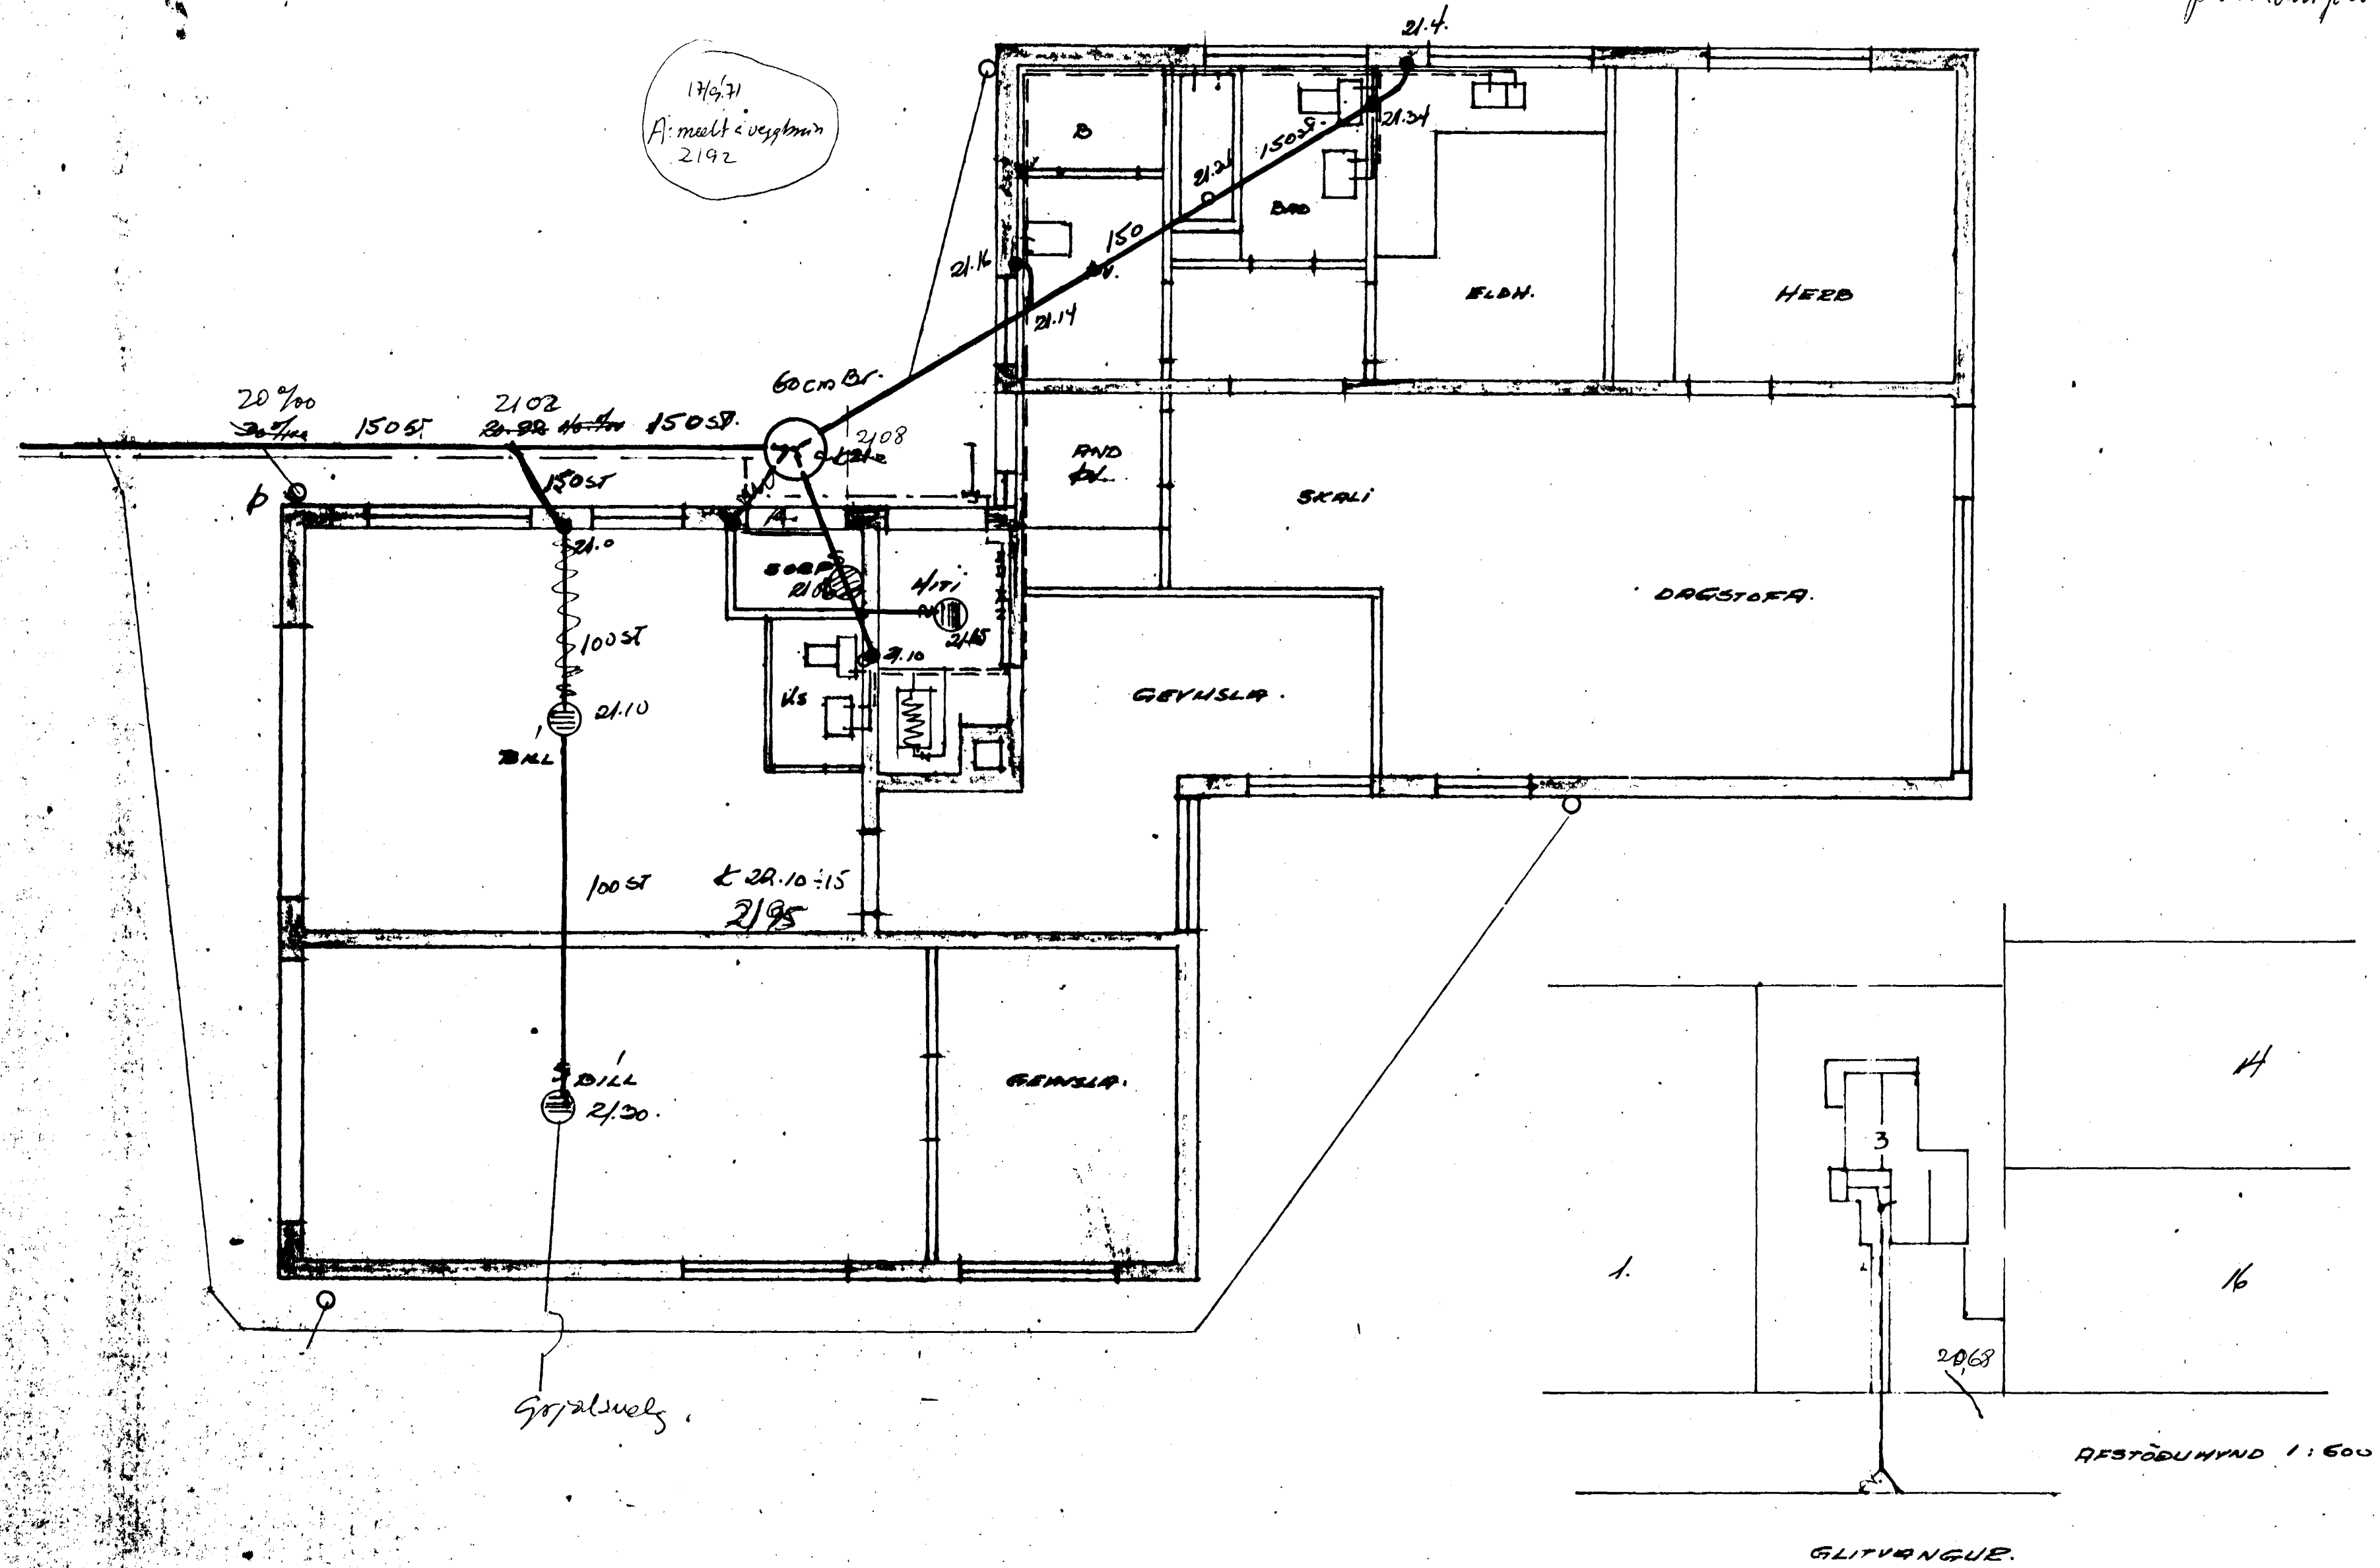

GLITVANGUR 3 NATN & SKULD	N.	TEIEM.	DM.
	1:50	DARE.	6.6.71
KOLBEINN KJ. JONSSON TEKNI. FR. NFI.	TEIEM. N.	7108	
	RL. 1		