

Eig:

Haukur Jónsson

Grænakinn nr. 14


Breyting

1:100

AFSTÖÐUMYND





1:500

15/X'59

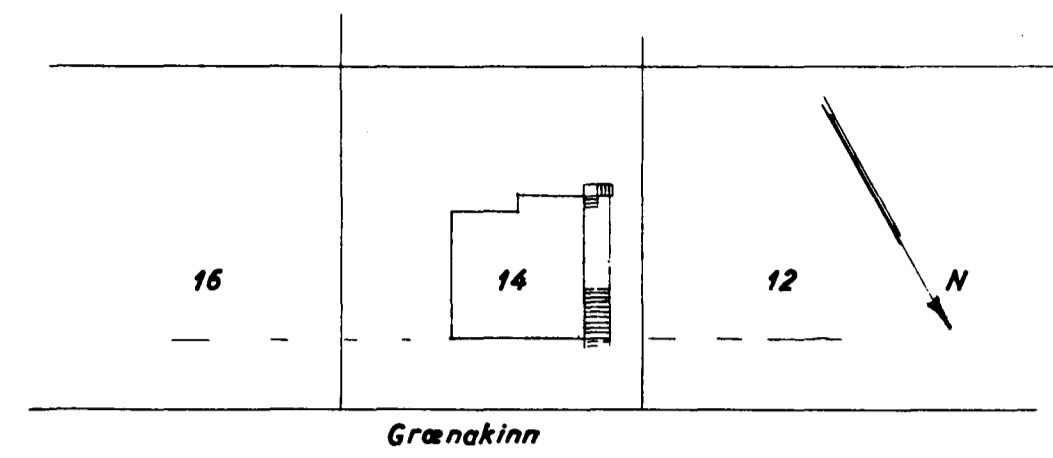

HÚSASMÍÐAMEISTARI

MÜRARAMEISTARI

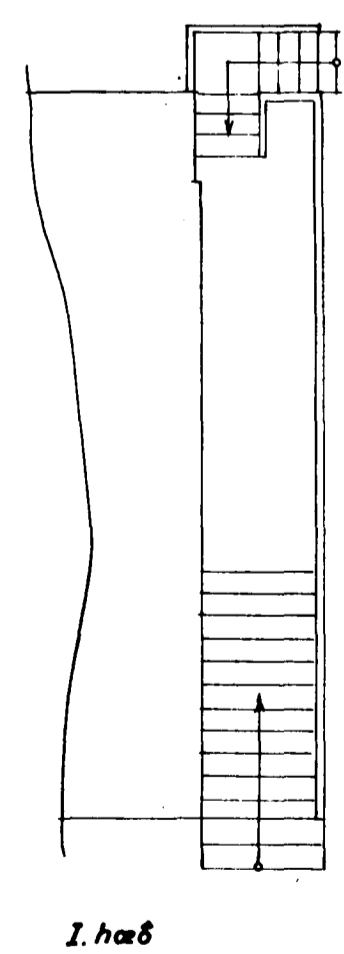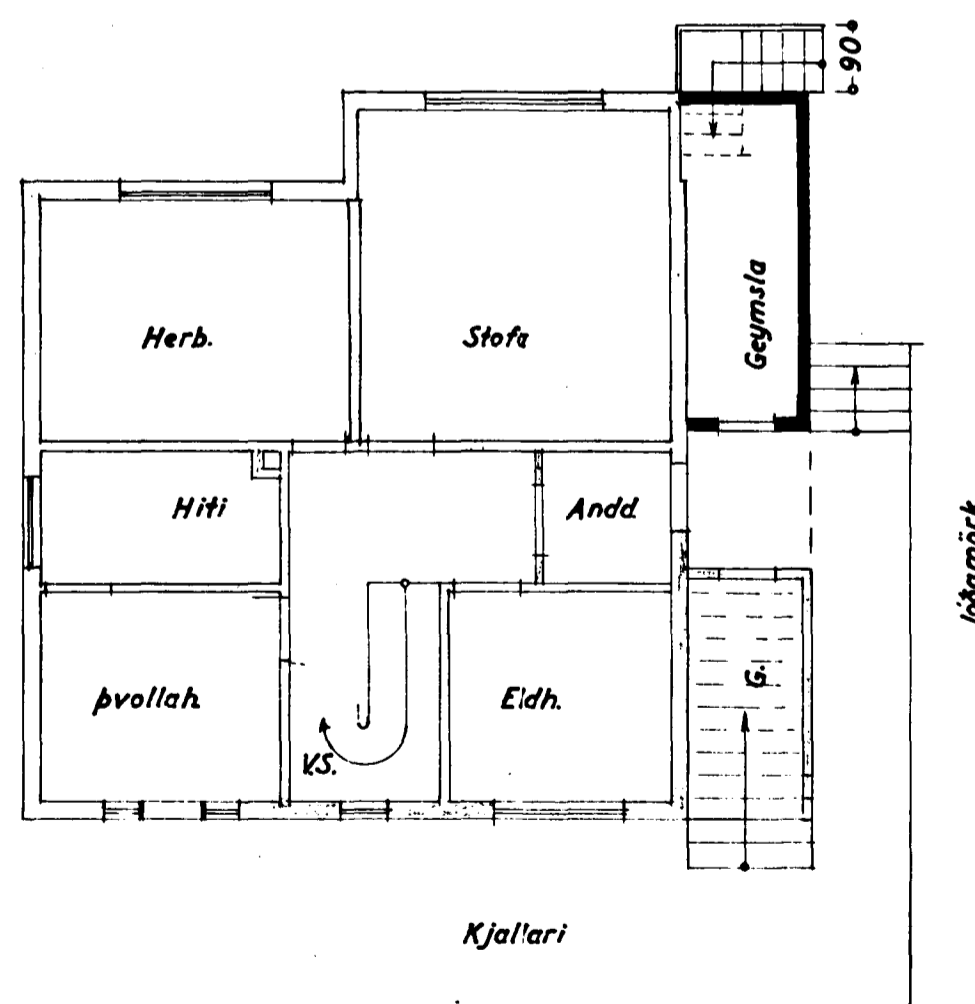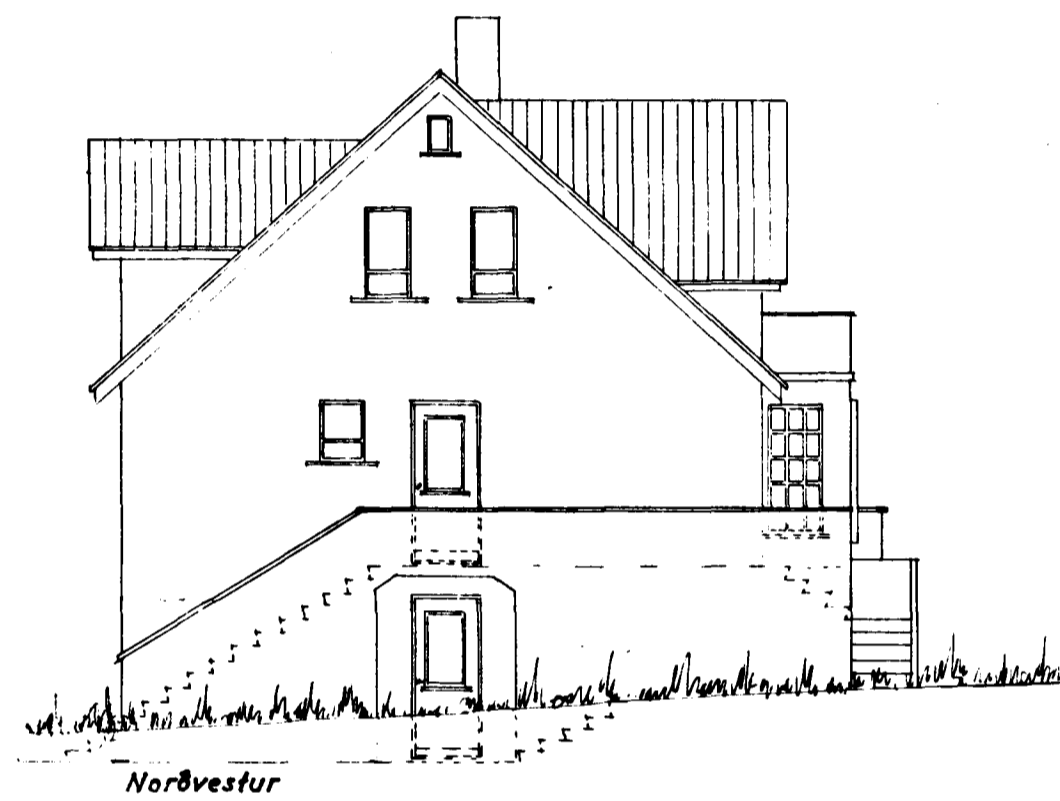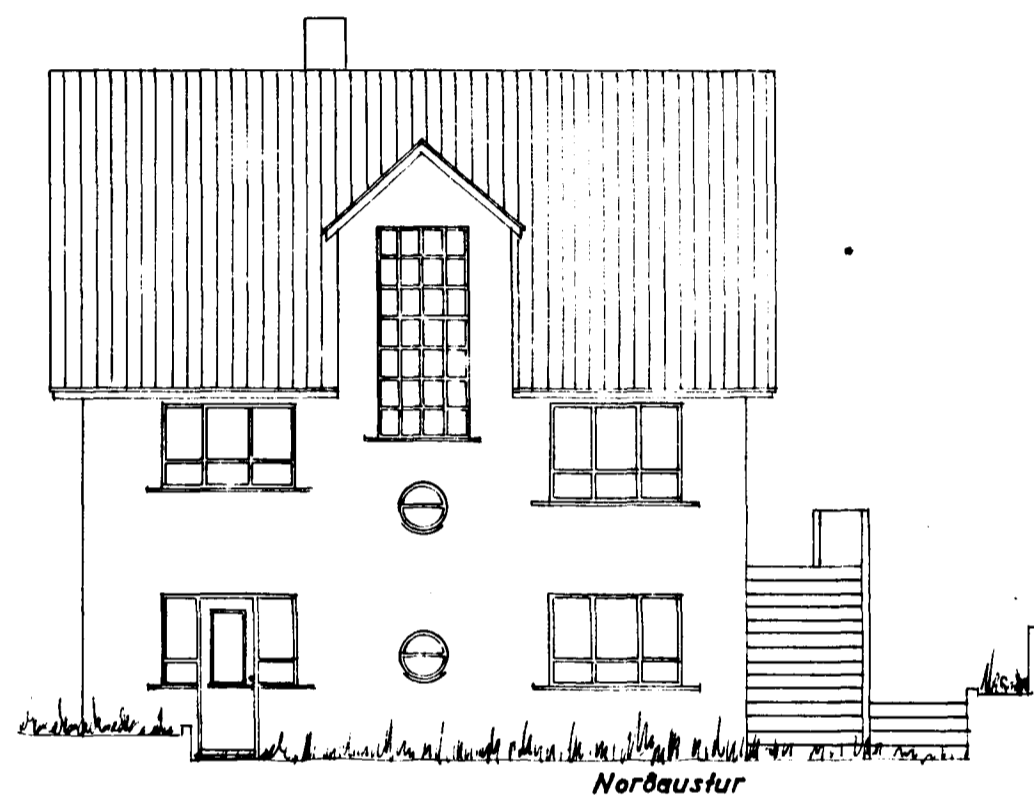

Sjalmarlitað: í maí 1959

F. Jónsson