


GRUNNMÝND, 2. HÆÐ, 1:50

01	07.08.96	LEGU LAGNA DREYTT	CH
BR.	DAGS.	EDL. BR.	SIGN

GRÆNAKINN 4
HAFNARFIRÐI 8

HITA - 06 VATNSLAGNIR

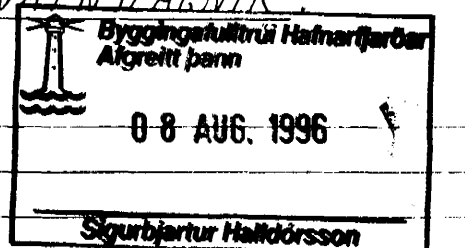

DAGS. DES. 95
VERK NR. 9544
TEIKN NR. 2-04
HANNAD CH
TEIKNAD CH
YFIRFARIÐ

ÁSKILIÐ, ELÐRI
TEIKNING ÓGILD

TSÞ TÆKNIÞJÓNUSTA
SIGURÐAR ÞORLEIFSSONAR HF

STRANDGÖTU 11 - 220 HAFNARFJÖRÐUR - SÍMI 54255 - FAX 652875