

A

B

C


D

E


F

G


H

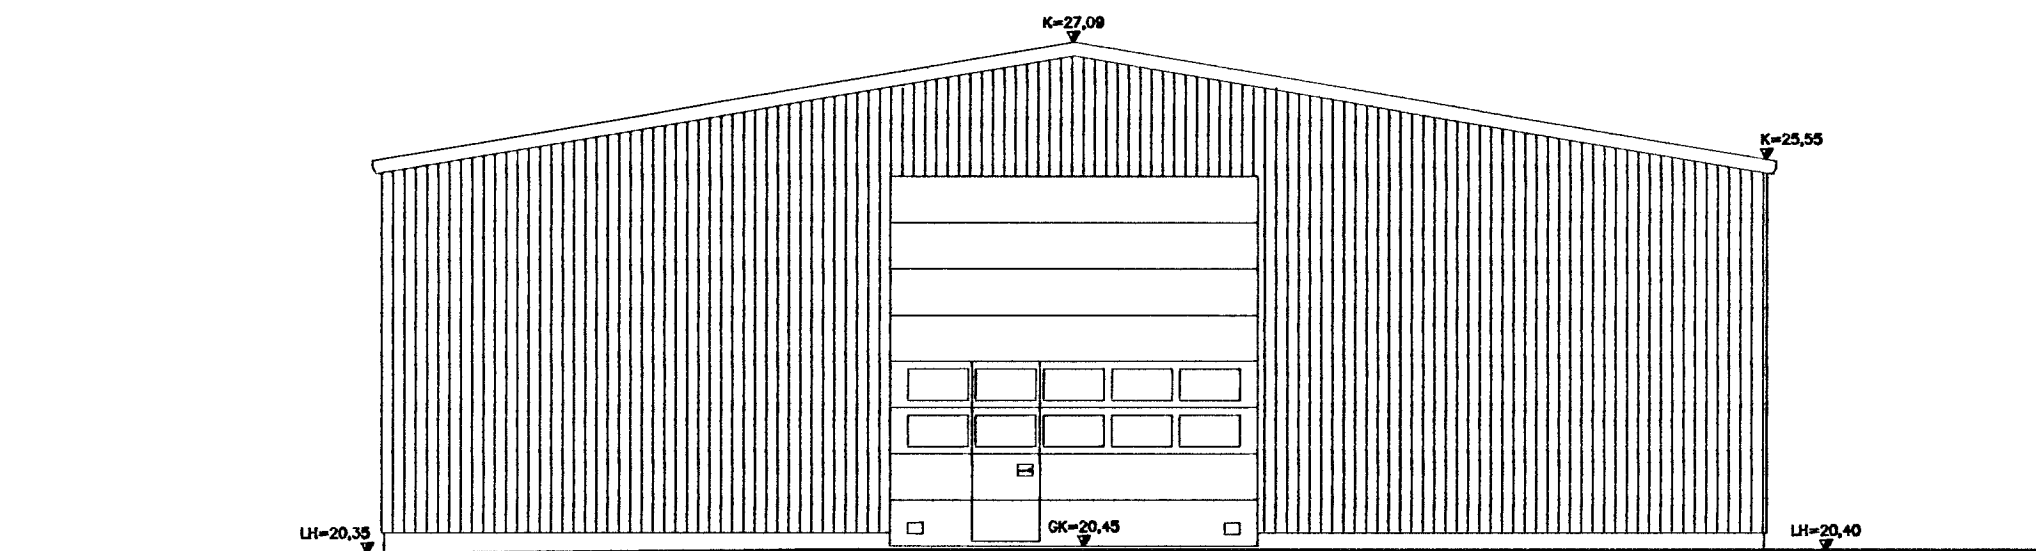


SUDURGAFL MKV. 2

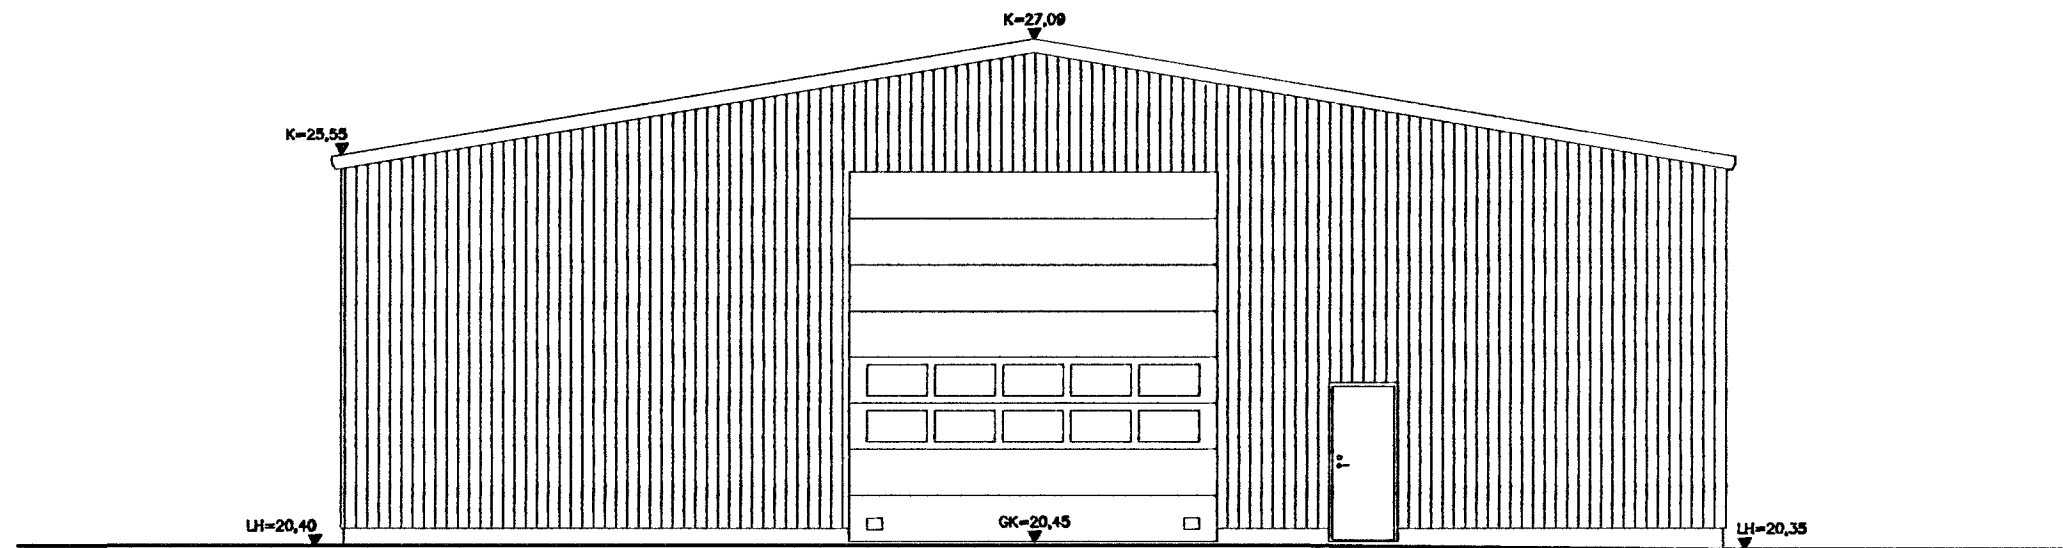

NORDURGAFL MKV. 2

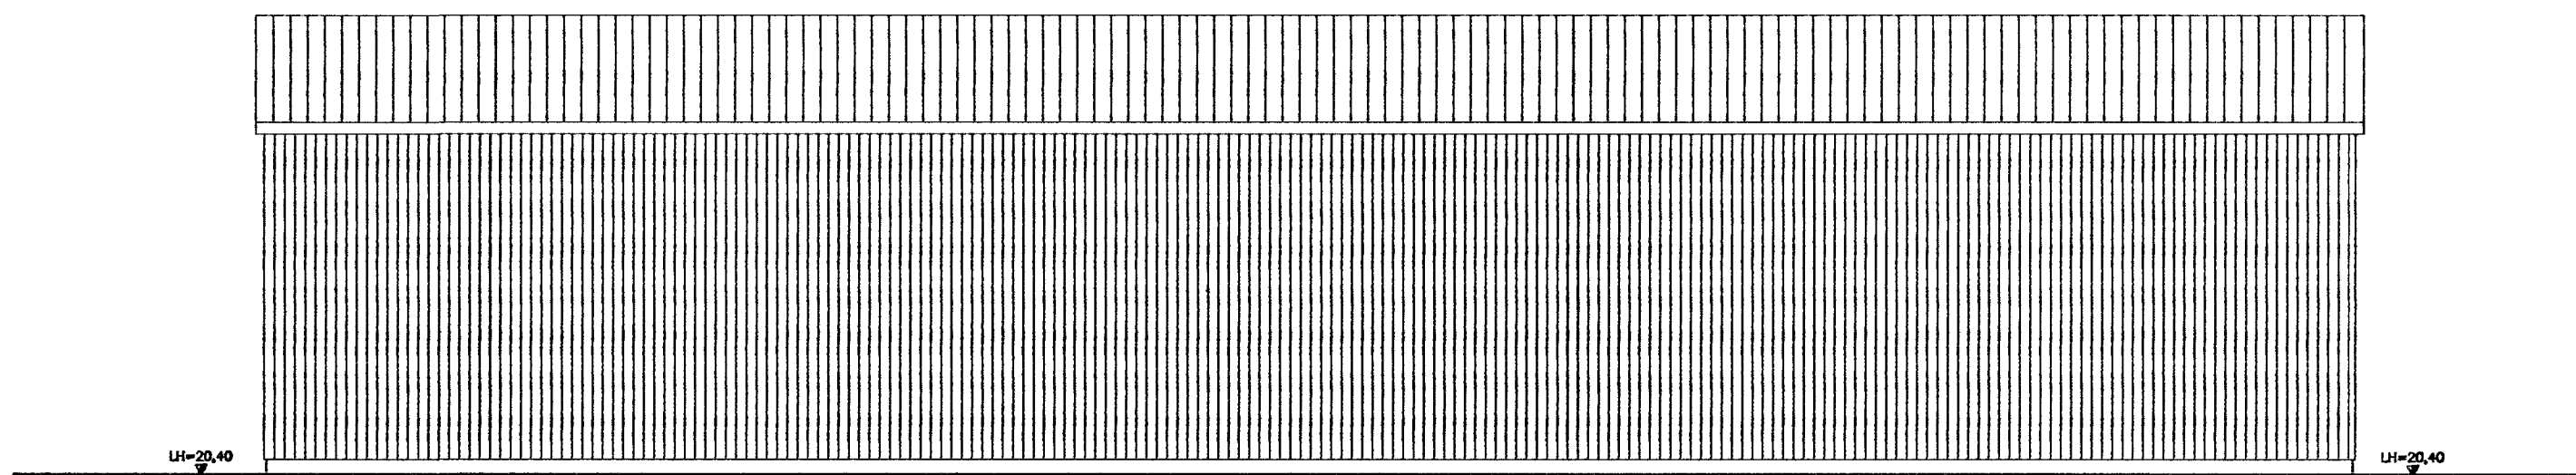

AUSTURHLID MKV. 2

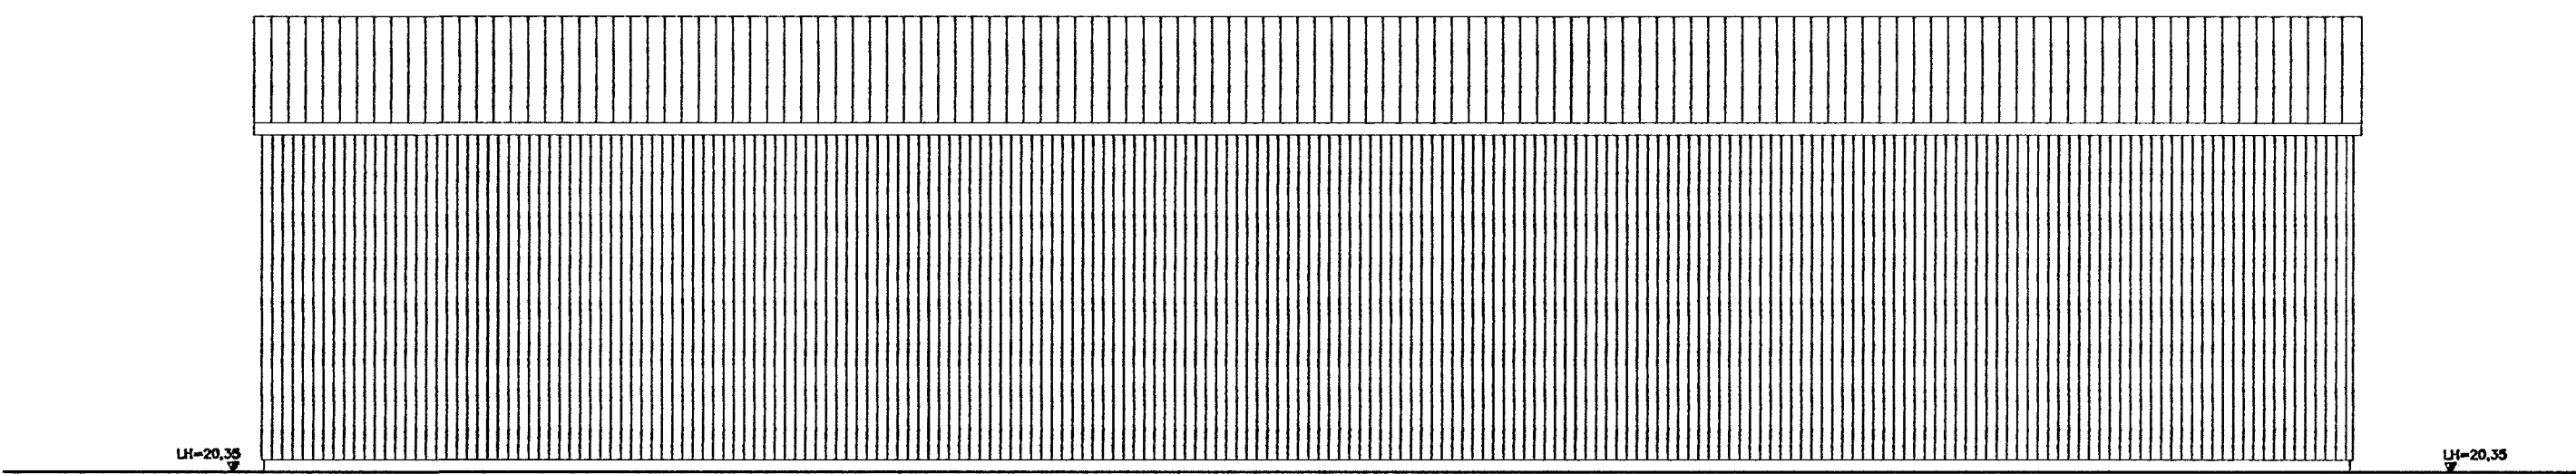

VESTURHLID MKV. 2

SKÝRINGAR

SJÁ TEIKNINGU A101

MKV.2

0 2000 4000 6000 8000 10000



1:100 (I A2) mm

ÚTGÁFUFERILL					
NR.	DAGS.	SKÝRINGAR	HA.	YF.	SP.
B1	30.08.07	FRUMÚTGÁFA	BV	LÁ	BV
B2	15.01.10	ÚTLITI BREYTT, VÉLAKLEFA BÆTT VIÐ	BV	LÁ	BV
B3	4.1.2013	ÍVINNSLU	LDB	LÁ	LDB
B4	22.1.2013	REYNDARTEIKNING	LDB	LÁ	
DAGS. UNDIRSKRIFTAR:			NAFN OG KT. SAMRÆMINGARHÖNNUÐAR:		
22.01.2013			LÚDVÍK D. BJÖRNSSON 141054-2359		
UNDIRSKRIFT SAMRÆMINGARHÖNNUÐAR:					
			<i>Lúdvík D. Björnsson</i>		
MANNVIT VERKFRÆÐISTOFA					
GRENSÁSVEGI 1, 108 REYKJAVÍK, SÍMI: 422 3000, FAX: 422 3001 VEFFANG: www.mannvit.is NETFANG: mannvit@mannvit.is					
HEITI VERKS:					
GULLHELLA 1 HLADBÆR-COLAS HAFNARFIRÐI					
HEITI TEIKNINGAR:					
ADALUPPDRAÐTUR VÉLAVERKSTÆÐI (MHL.01)					
ÚTLIT					
TEIKNAD:	BV	BLAD NR.	N. BL. NR.	TÖLVUSKRÁ:	VNR:
					7.031.285
HANNAD:	BV	YFIRFARID:	LÁ	MKV:	NR. TEIKNINGAR:
				1:100 A2	
DAGS. UNDIRSKRIFTAR:	NAFN OG KT. HÖNNUÐAR:		MANNVIT		430572-0169
					A103
UNDIRSKRIFT HÖNNUÐAR:					ÚTGÁFA:
	<i>Lúdvík D. Björnsson</i>				B4