

Eig:


Erla Eiríksdóttir

Háabarð nr. 7

1:100







AFSTÖÐMYND

1:500

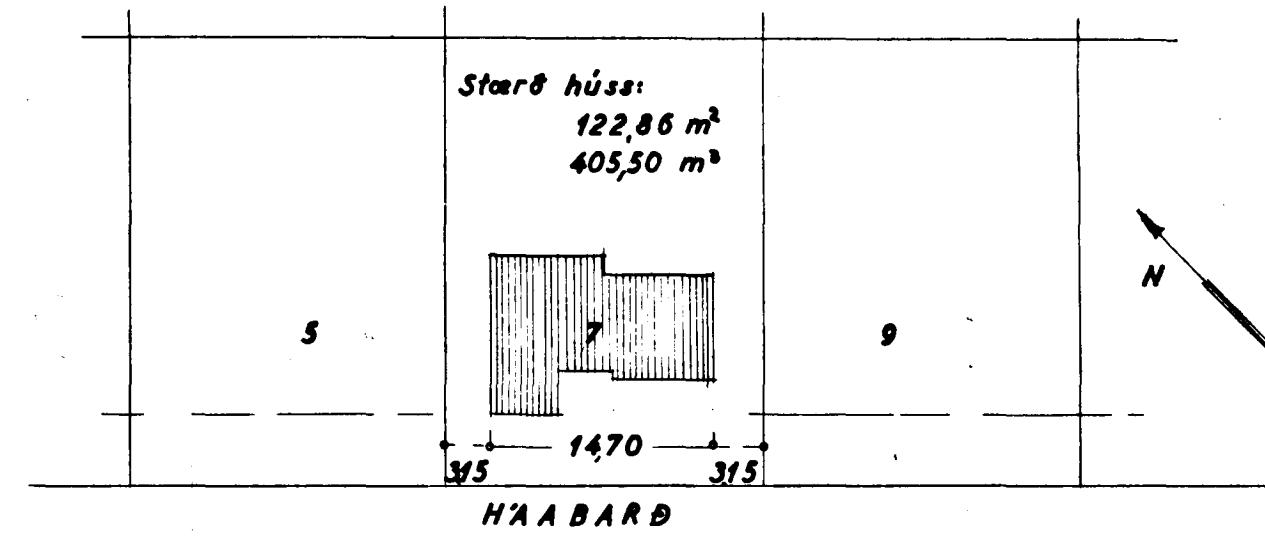

*Þorvaldur Þorgrímsson*  
HÚSAMÍÐAMEISTARI:  
*Einar Sigurðsson*  
MÚRARAMEISTARI:

Gluuggabragting  
Scamp. 12/6 74  
F. Sig.

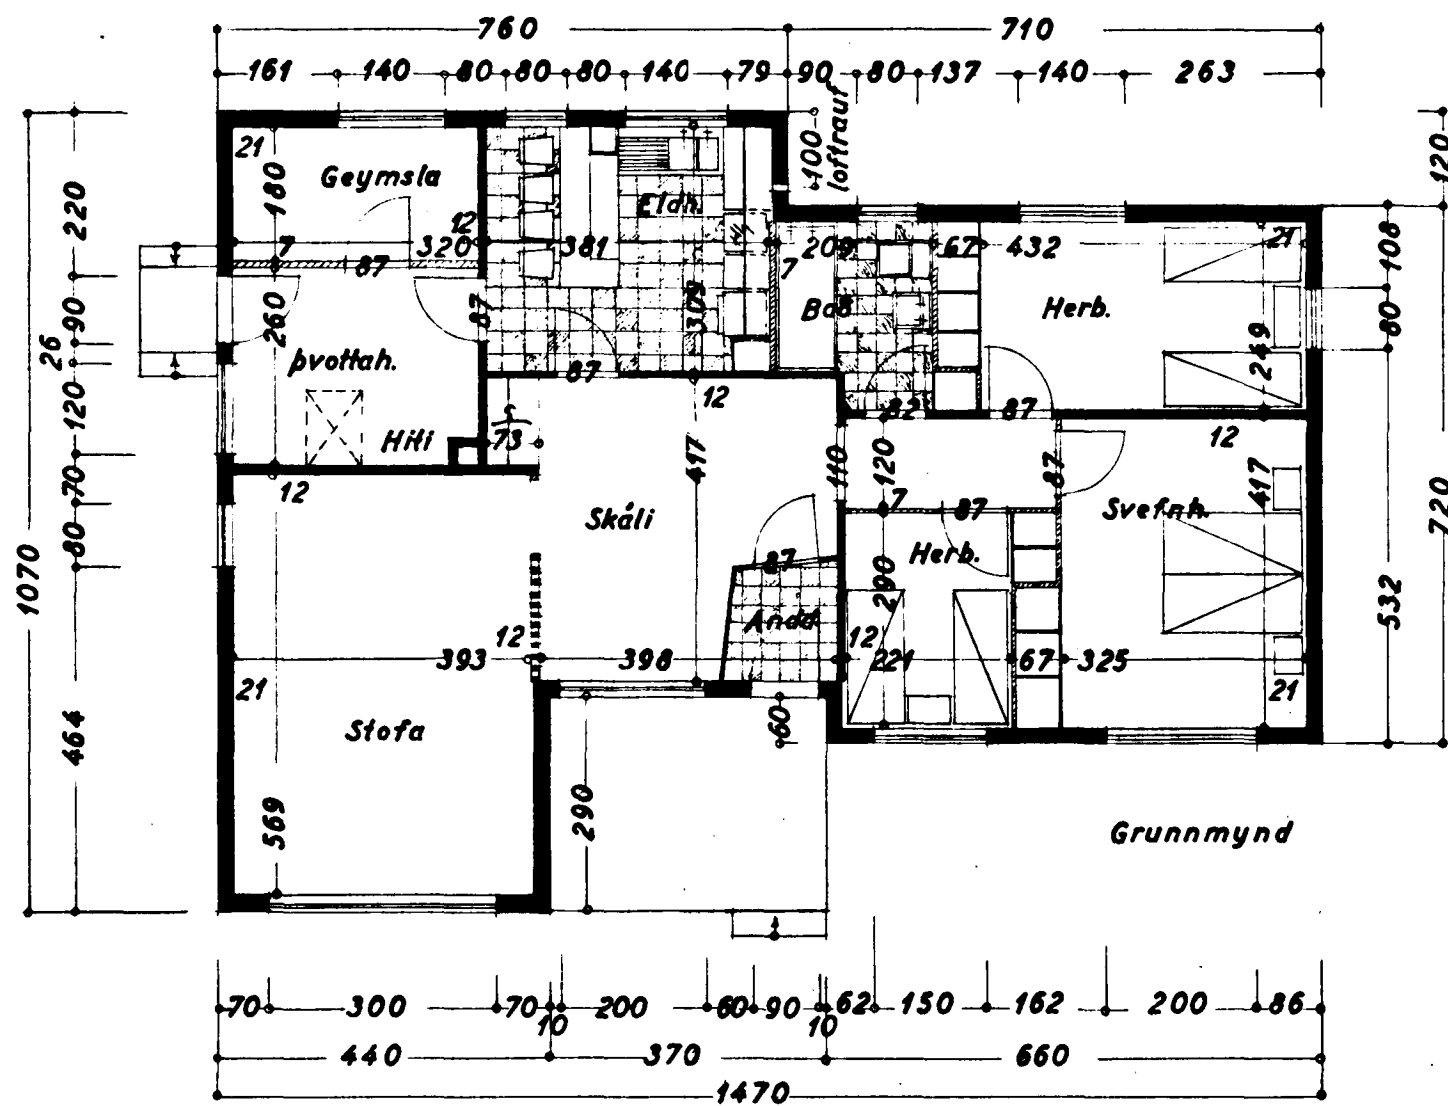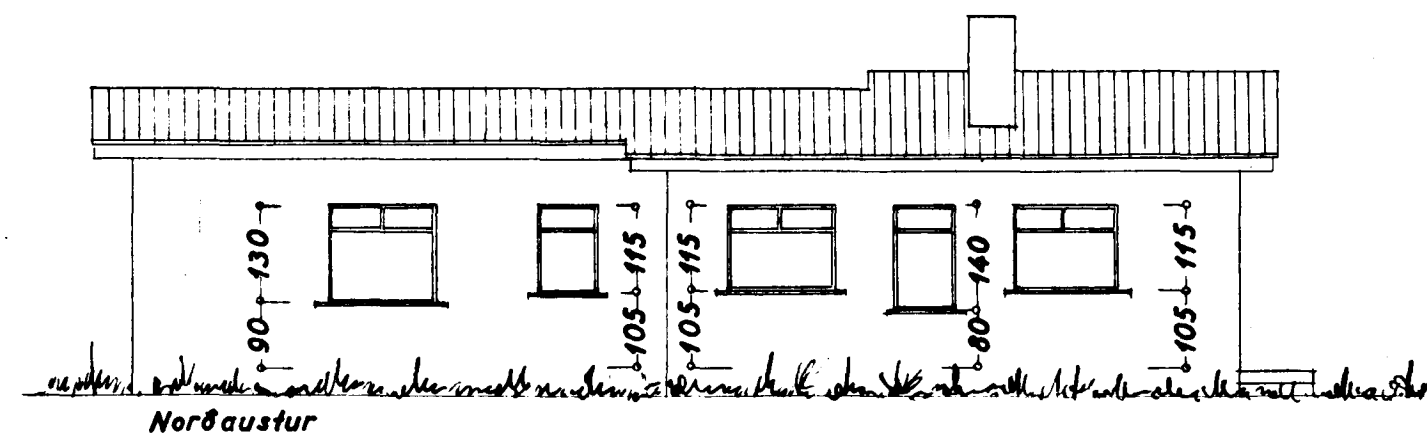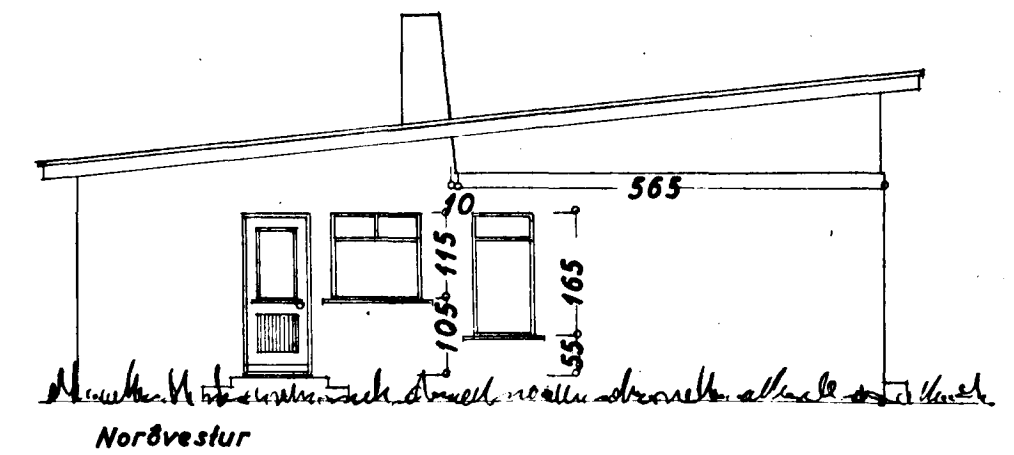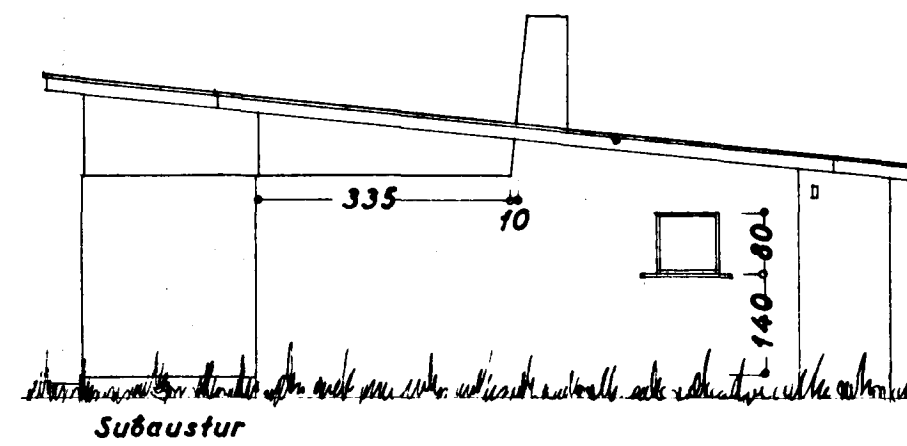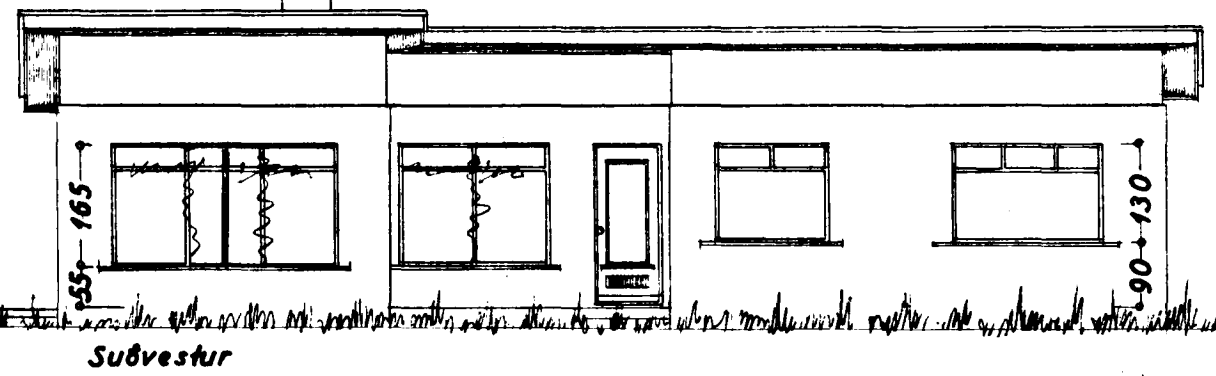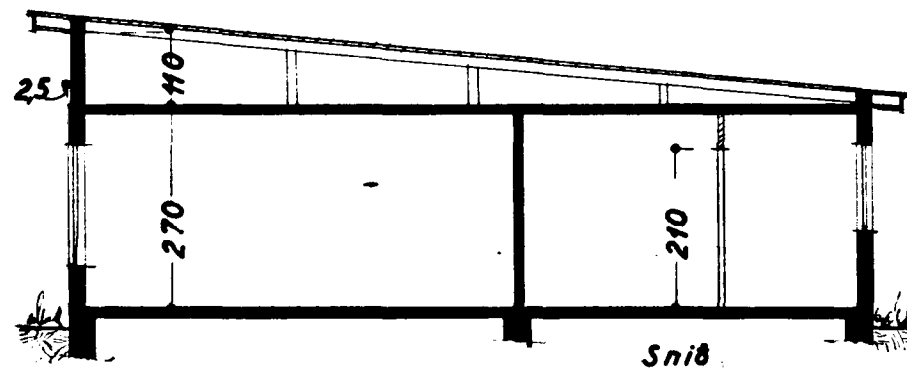

HÁABARÐ

Þáttmál: 2 sept. 1959  
F. Sigurðsson