




SUD - VESTUR

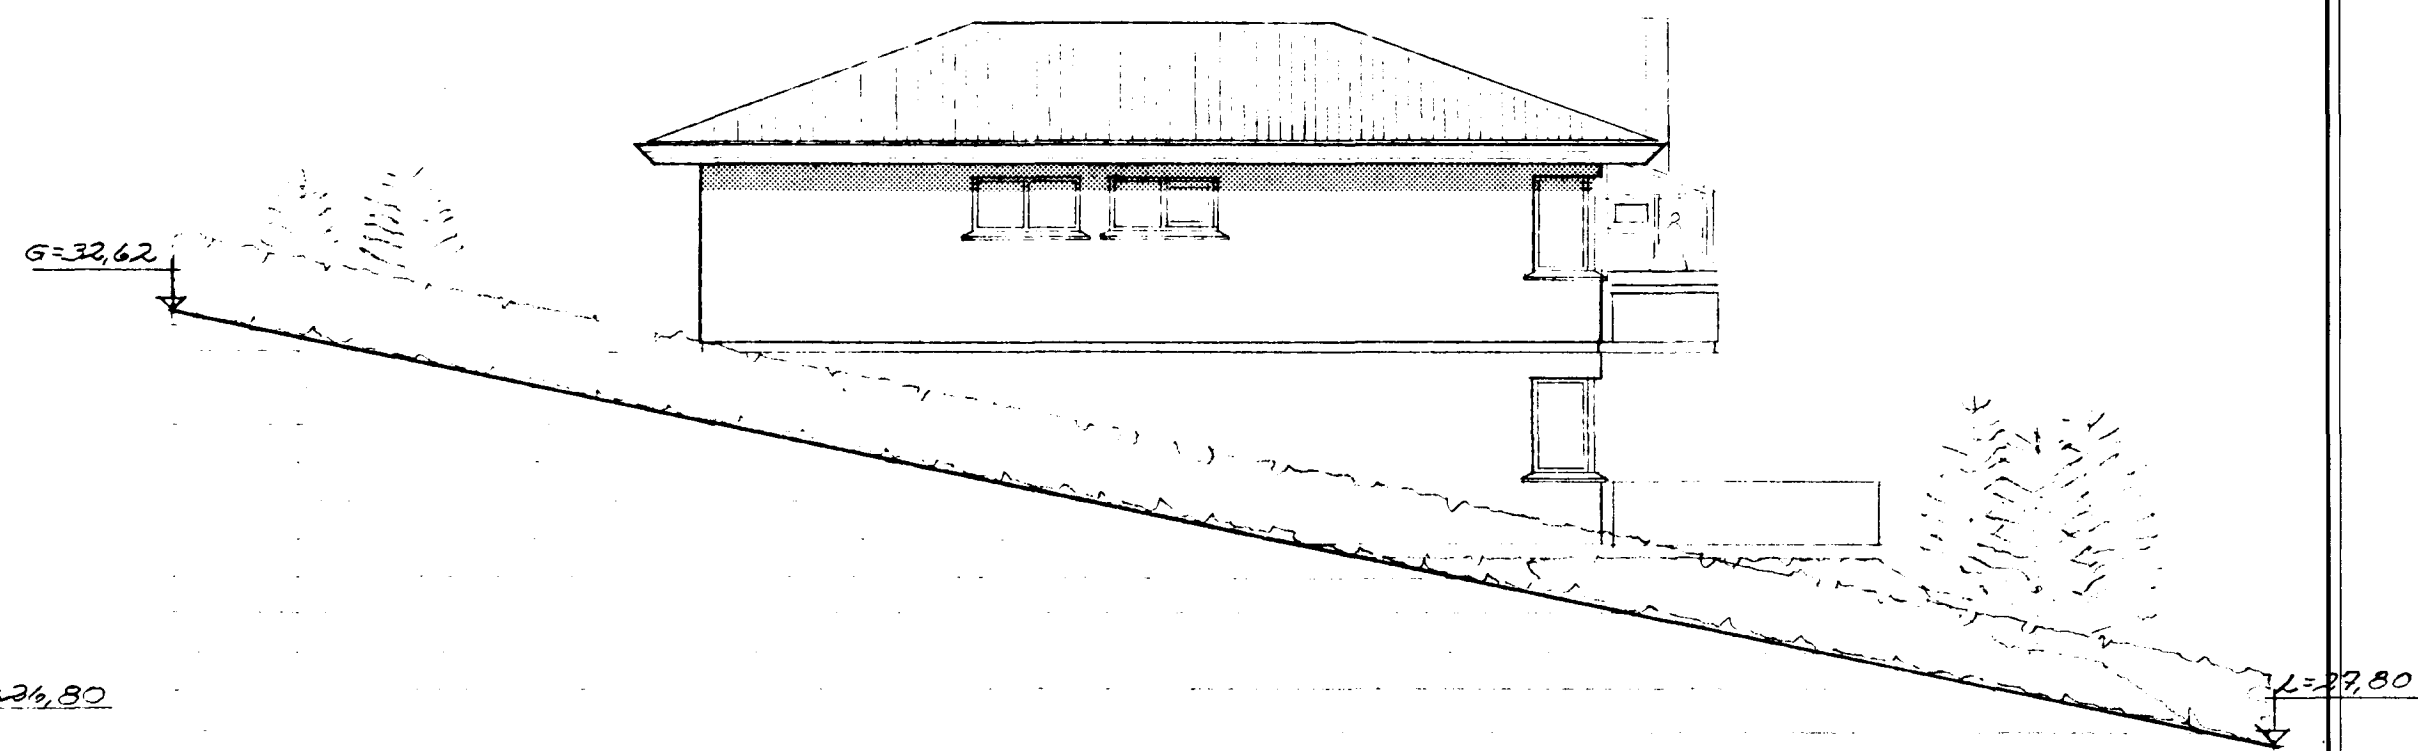

NORÐ - VESTUR

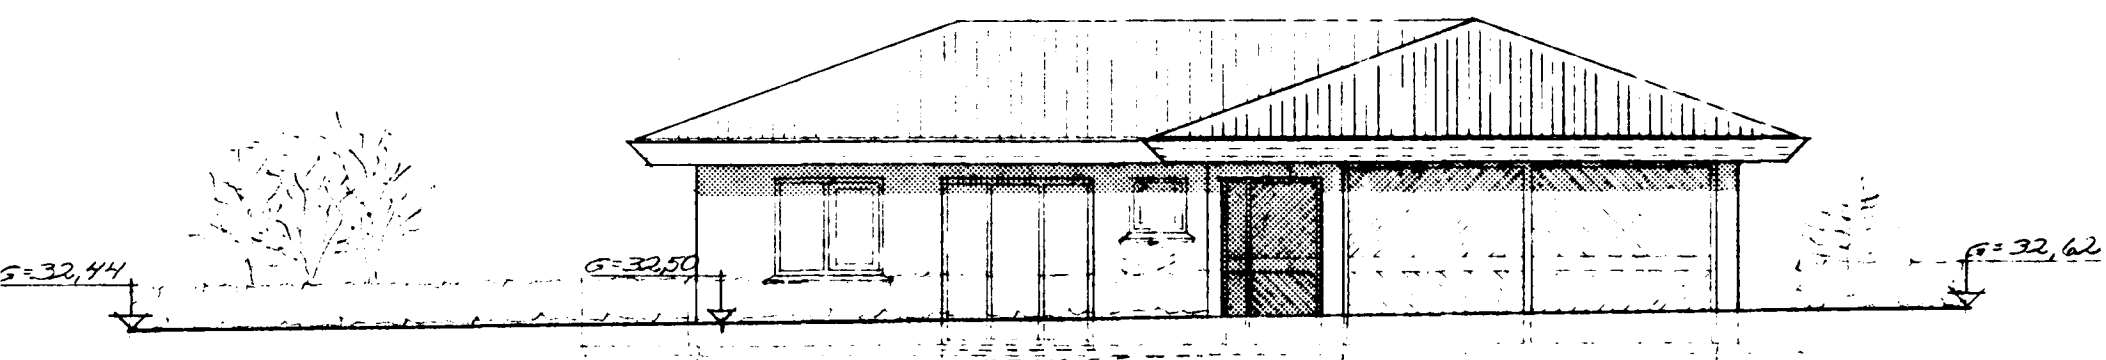

NORÐ - AUSTUR

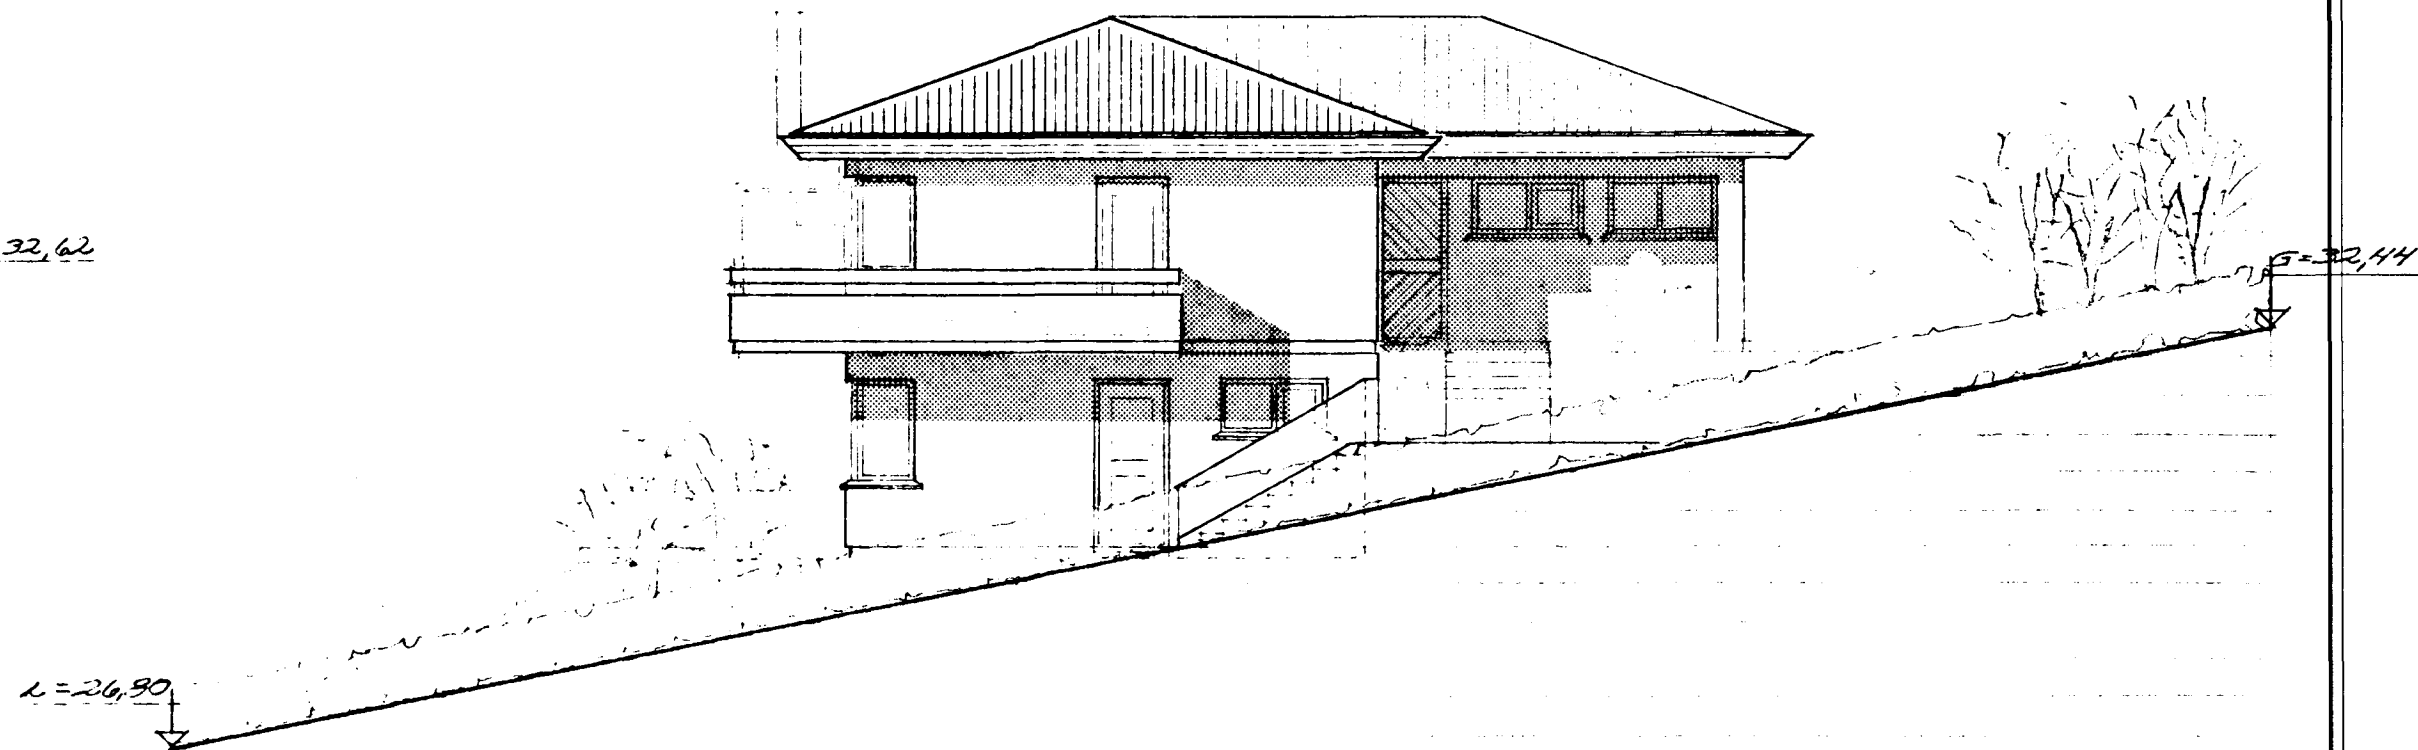

SUD - AUSTUR

BREYTT 10/4 196 BLÓMASKÁLI *Fj*

HÁBERG 11 HAFNAFIRÐI

NR. 3

ÚTLIT
INGI GUNNAR ÞÓRÐARSON BYGGINGAFR. BFI
SAFARÍGI 87 RVK. Sími 568 3523 *Þj*
D. DES. 190

TKV. 1:100