


AFSTÖÐUMYND 1:500

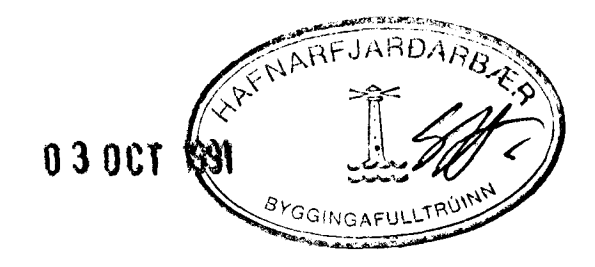

01	11.09.91	LÖGNUM BREYTT	4.21.
BR.NR.	DAGS	EÐLI BREVTINGAR	SIGN.
HÁBERG 15 HAFNARFIRÐI			DAGS. OKT. 90
GRUNNMÝND - GRUNNLAGNA			HANNAÐ <i>d.w.</i>
MÆLIKV. A 1:50			TEIKNAD <i>d.w.</i>
SIGURÐUR ÞORLEIFSSON TEKNIFRÆÐINGUR F.T.F.I.			VERK NR. 9039
STRANDGÖTU 11 HAFNARFIRÐI SÍMI 54751/54255			BLADNR. 2 - 02