



Mkv.: 1:50.


Í ALLA VEGGI KOMI EINFÖLD JÄRNAGRIND
LÖDRÉTT KID ½ 30
LÄRÉTT KID ½ 20
FRÁBANGUR JÄRNA Í KRINGUM ÖP
ER SÝNDUR Á SKÝRINGARBLADI.

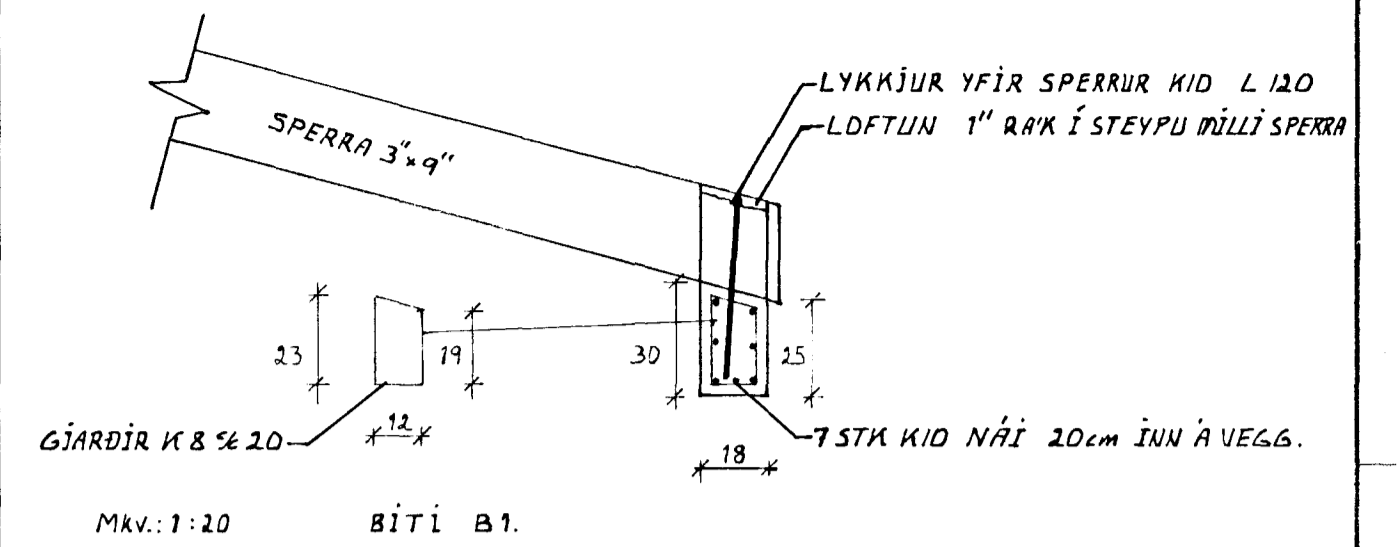


Mkv.: 1:20 BITI B1.

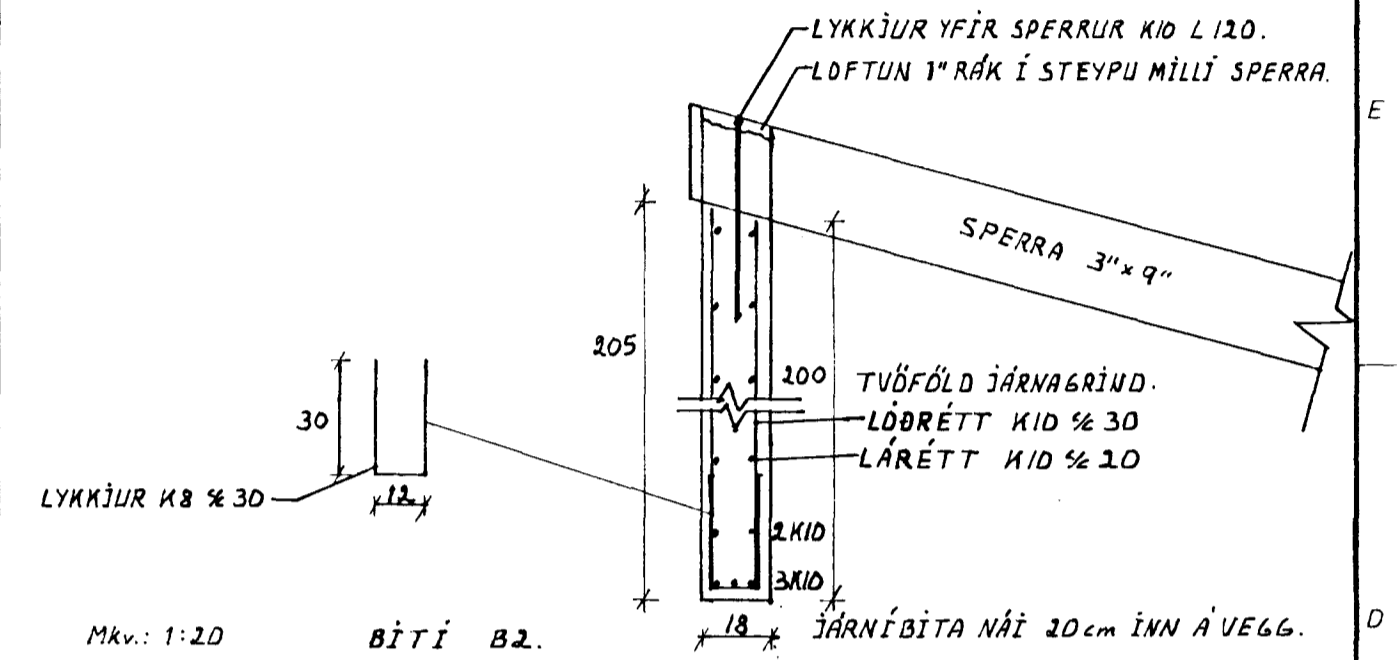


Mkv.: 1:20 BITI B2.

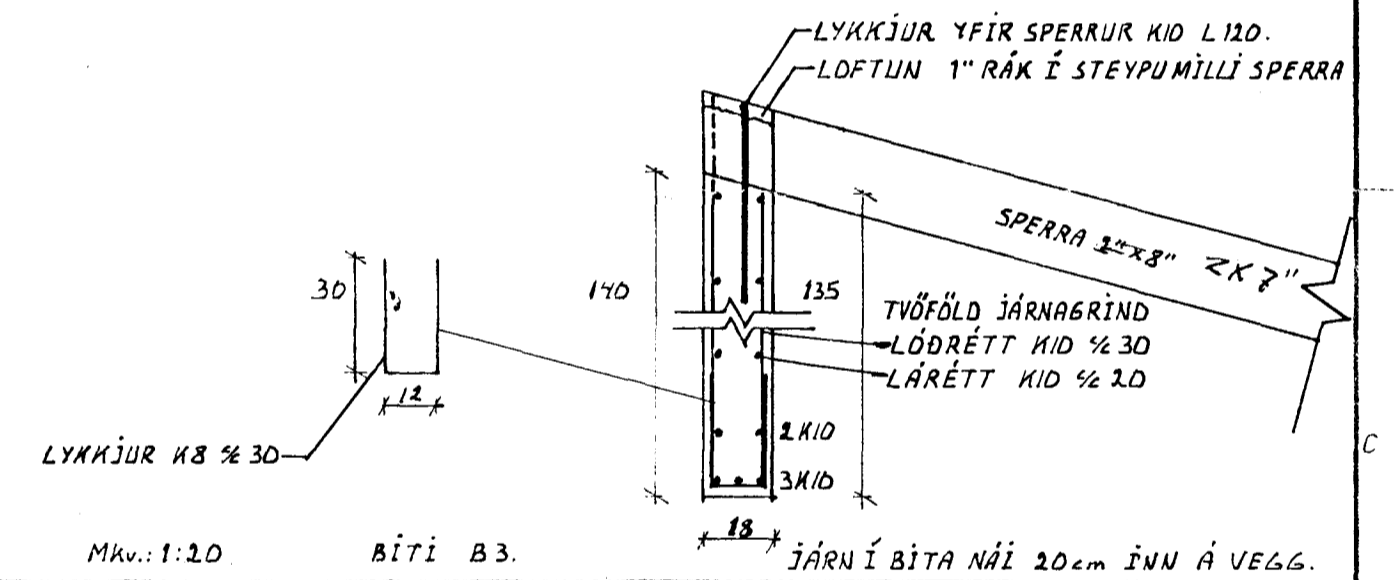

Mkv.: 1:20 BITI B3.

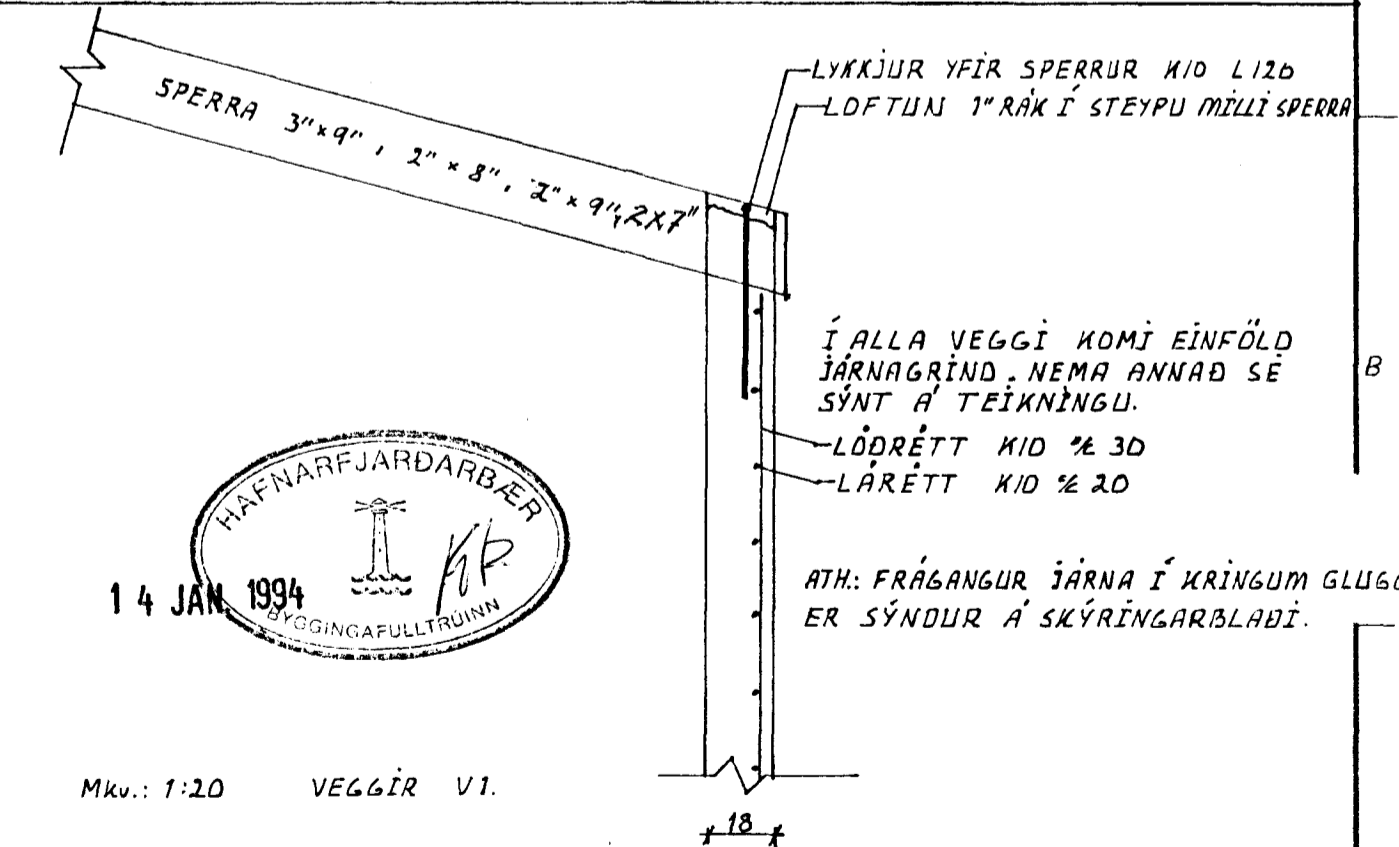

Mkv.: 1:20 VEGGIR V1.

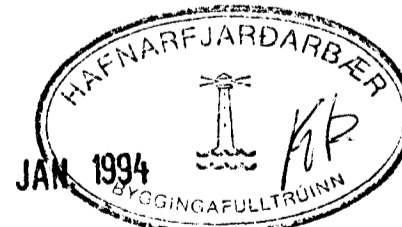

HAFBERG 23. HAFNARFIRÐI:

JÄRNABENDING VEGGJA I. HÆÐAR.
PAKVIRKI.

VERK NR V1.
TEKN NR 04. DAGS 4/10 1993

TEIKN SIÐURBJ HALLD.

HAFNAD Sigurbj Halld. YFIR Sigurbj Halld.

MKV 1:50/1:20.

Sigurbj Halld. PTFI Kleddhæun 9. Hg. 5.51356.