



SÚLA S2 1:20


SÚLA S3 1:20

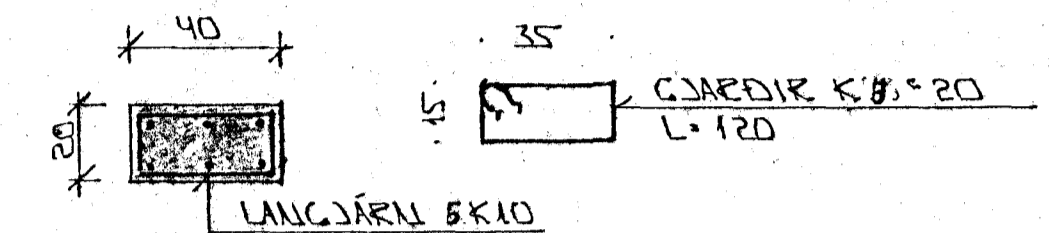

SÚLA S4 1:20

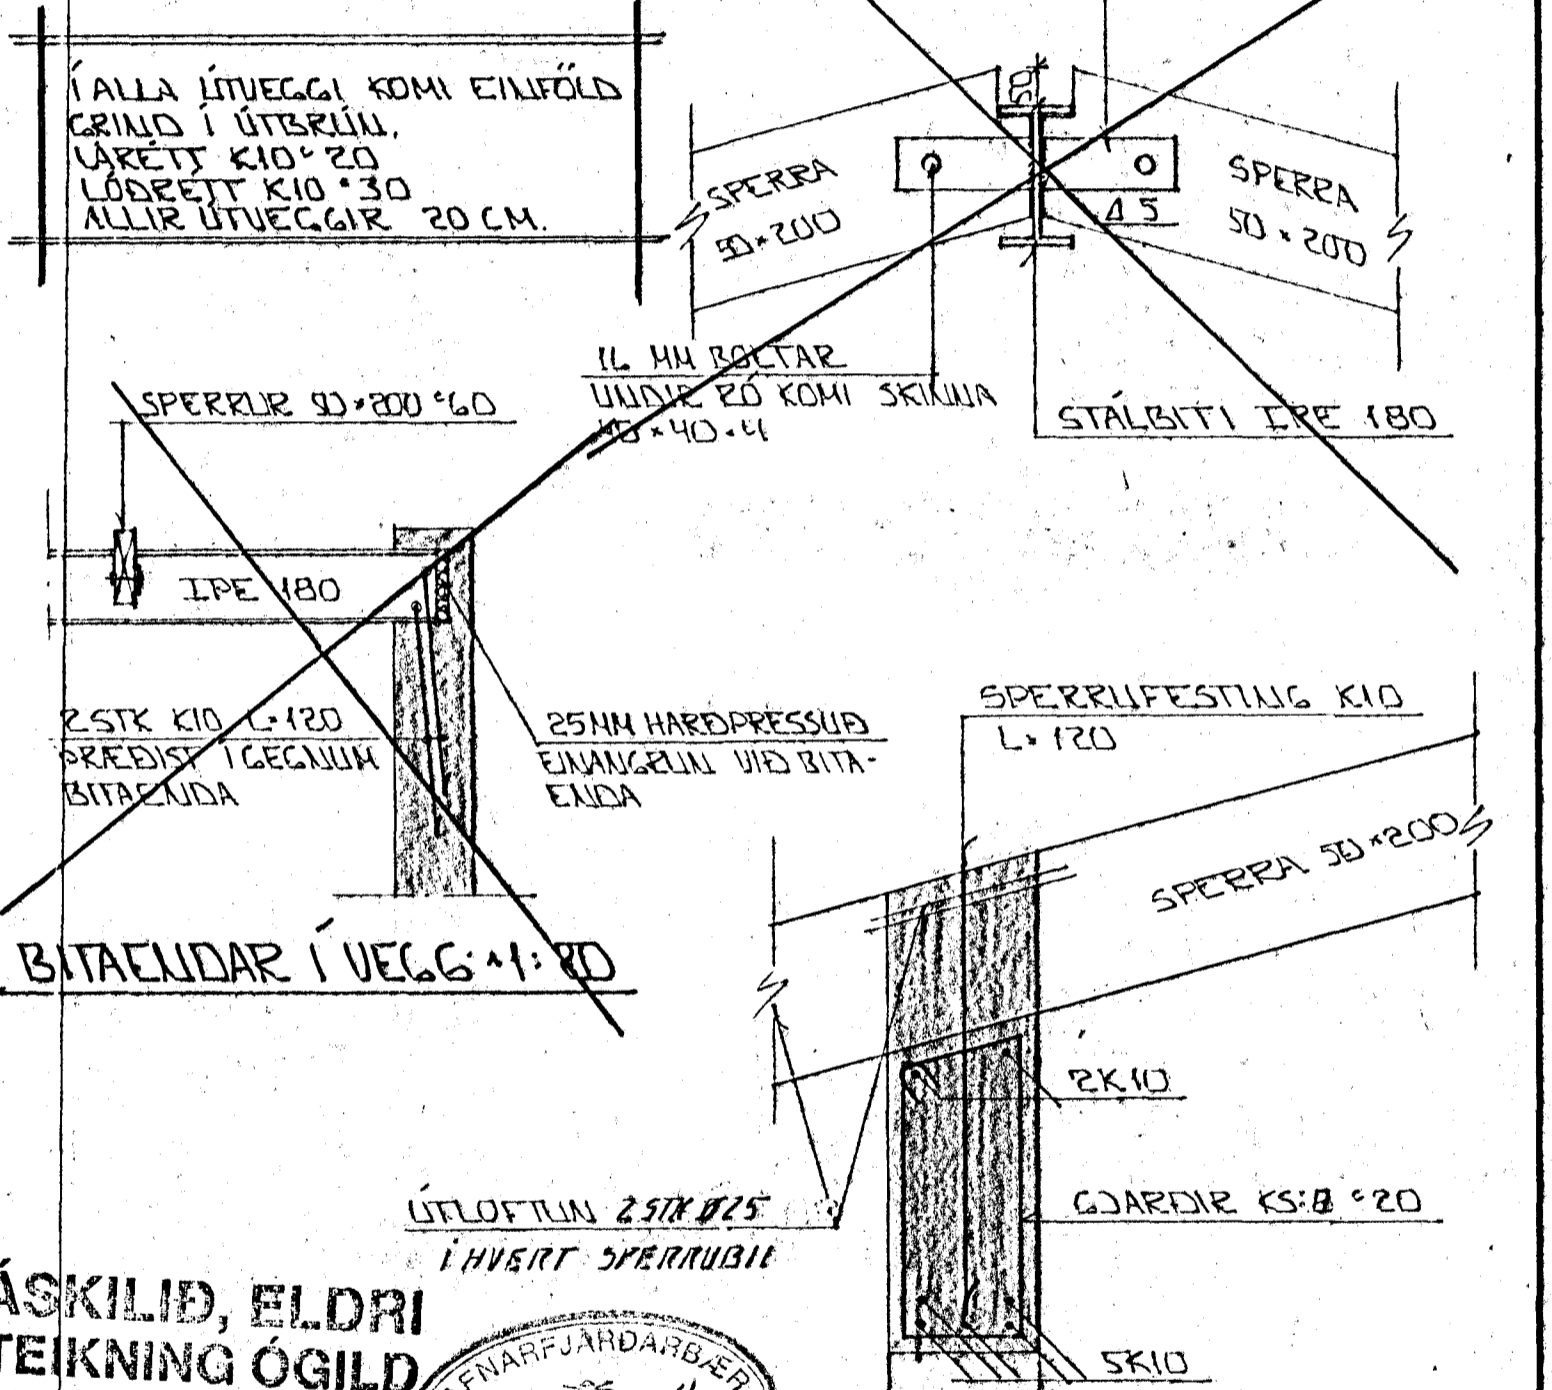


ÁSKILIÐ, ELDRI TEIKNING ÓGILD

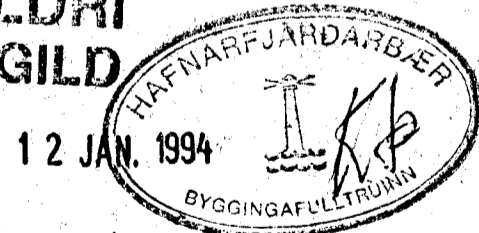


SNID 9 - 8 - 1:10

GRUNNMYND 1:50

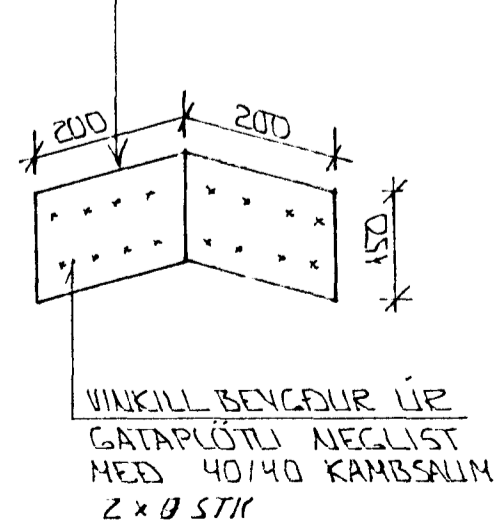

LASKI 25 x 150 x 600 BÁDU MEGIN SPERRU, NEGLIST MED 2 x 5 STK 3" NÓGLUM

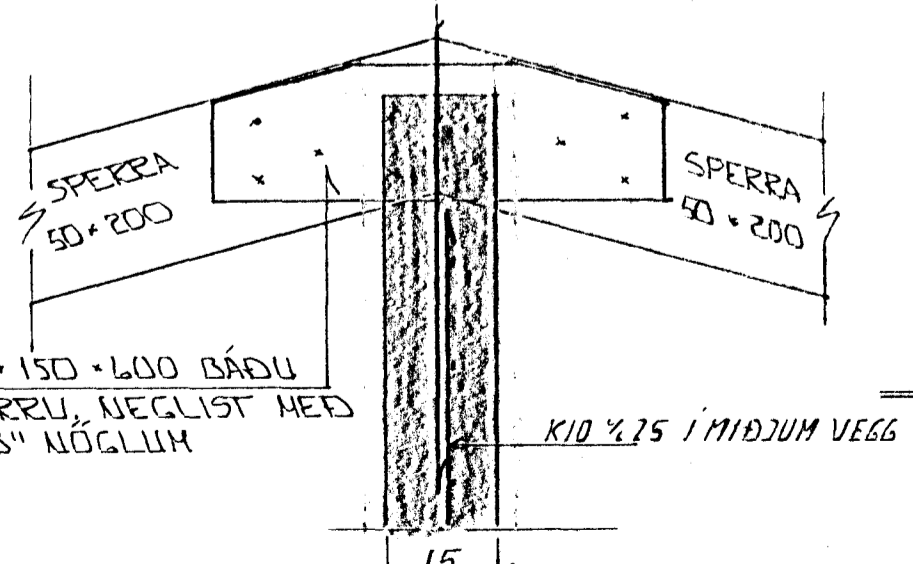

SNID 8 - 8 - 1:10

STEYPA:  
 S > 250  
 VS ≤ 0.5  
 LOFT ≥ 6%  
 SEMENT ≥ 300 KG/M<sup>3</sup>

SKYRNINGAR

ALMEINAR SKYRNINGAR SJÁ BL. NR. 1 - 01. SJÁ SNID Í LÍMTRÉSBITA BL. NR. 1 - 06.

BR.NR.	DAGS	EÐLI BREVTINGAR	SGN.
03	22.10.93	LÍMTRÉ Í STAÐ STÁLBITA	GH
02	20.09.93	BETT VIÐ VEGG	GH
105	10.07.93	GJARDIR BRESTT Í 0MM	4.7.
DAGS JAN '93			
HAFNAB 4.7.			
TEIKNAD GH			
VERK NR. 9302			
GLAÐNR. 1-05			

HÁBERG 3 HAFNARFIRÐI  
 BENDING VEGGJA 2 HÆÐAR  
 ÞAKVIRKI - SNID

MELIKV.  
 SIGURÐUR ÞORLEIFSSON TÆKNIFRÆÐINGUR P.T.F.I.  
 STRANDGÖTU 11 HAFNARFIRÐI SÍMI 54751/54255