





*RP*




ÚTLIT NORÐVESTUR MKV. 1:100

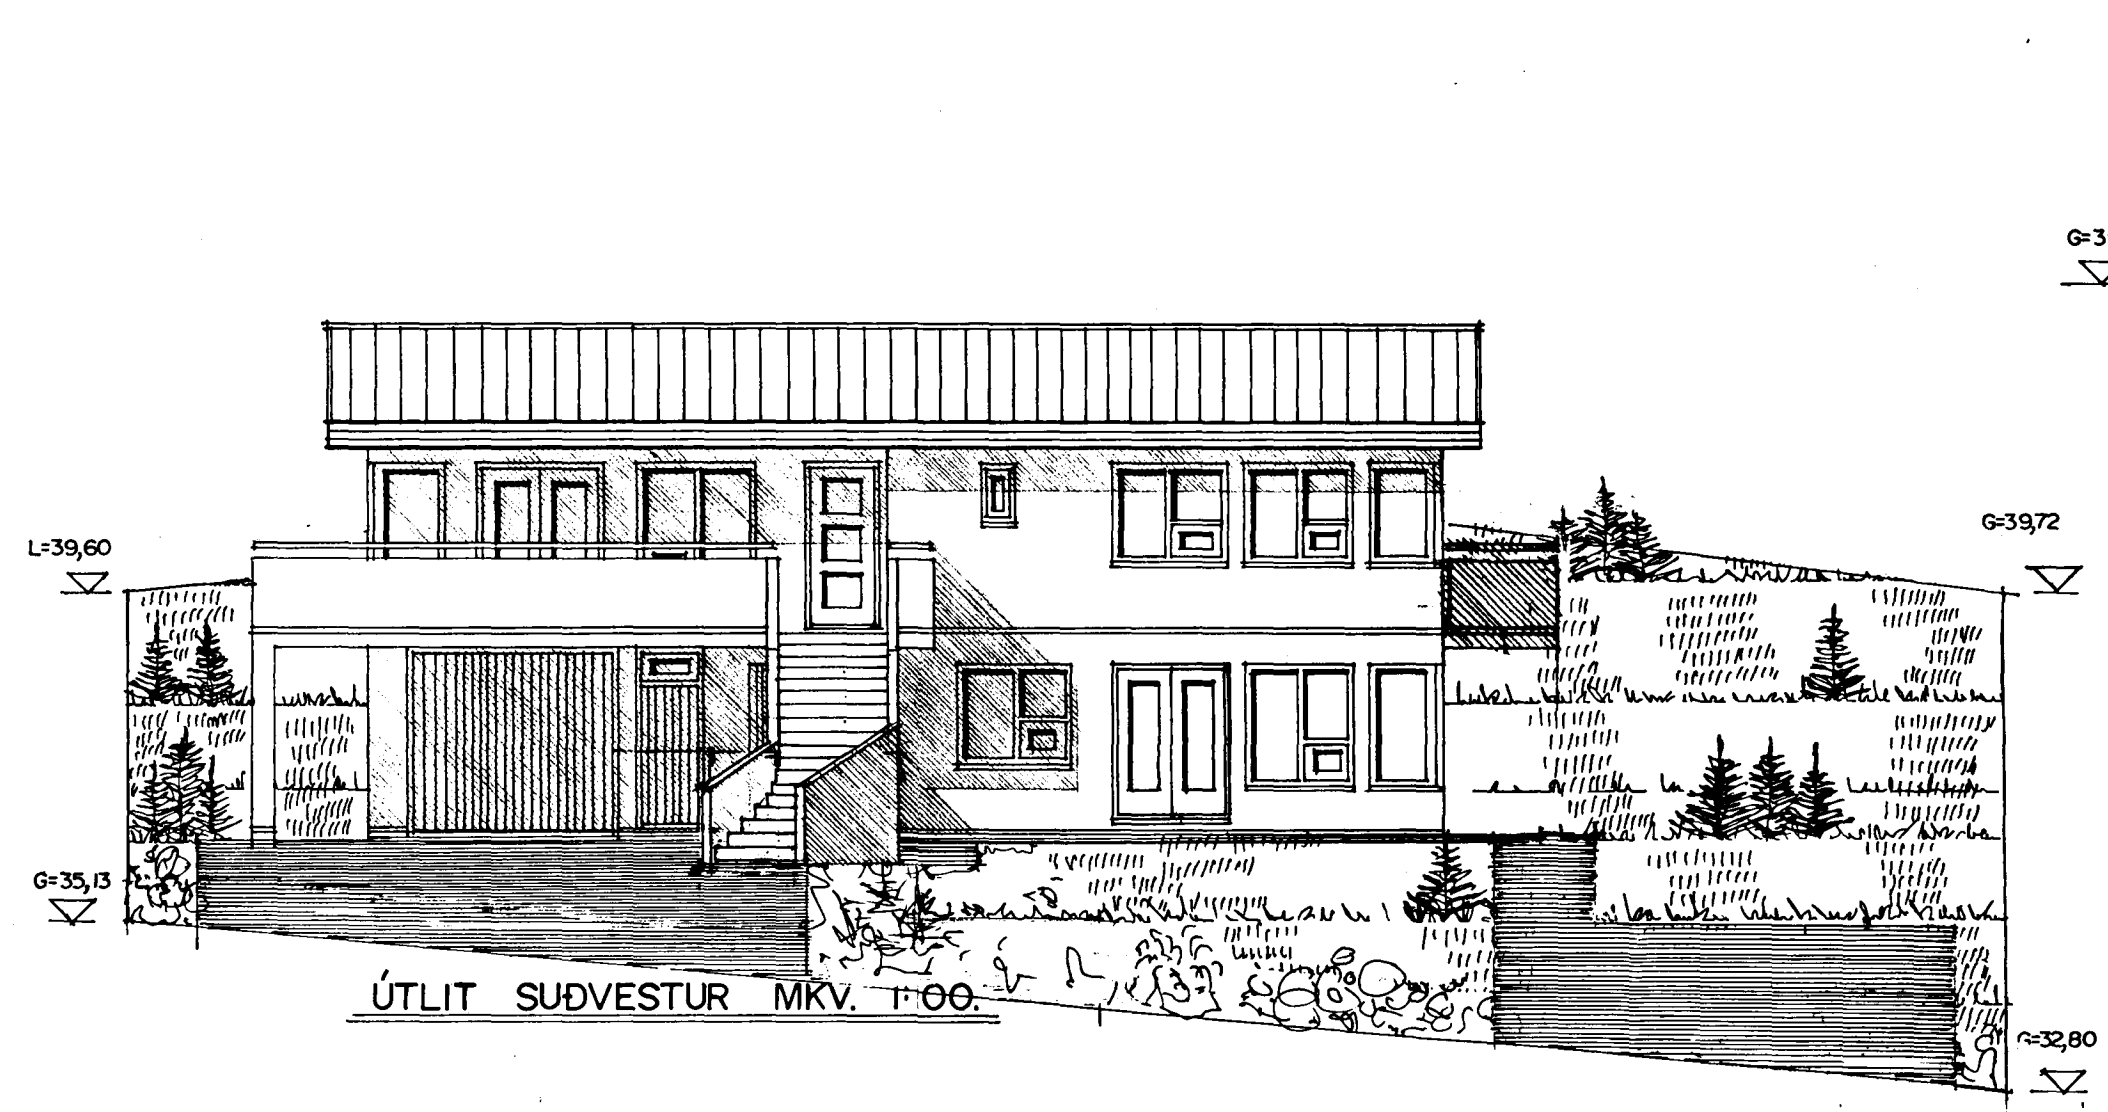

ÚTLIT SUÐVESTUR MKV. 1:100

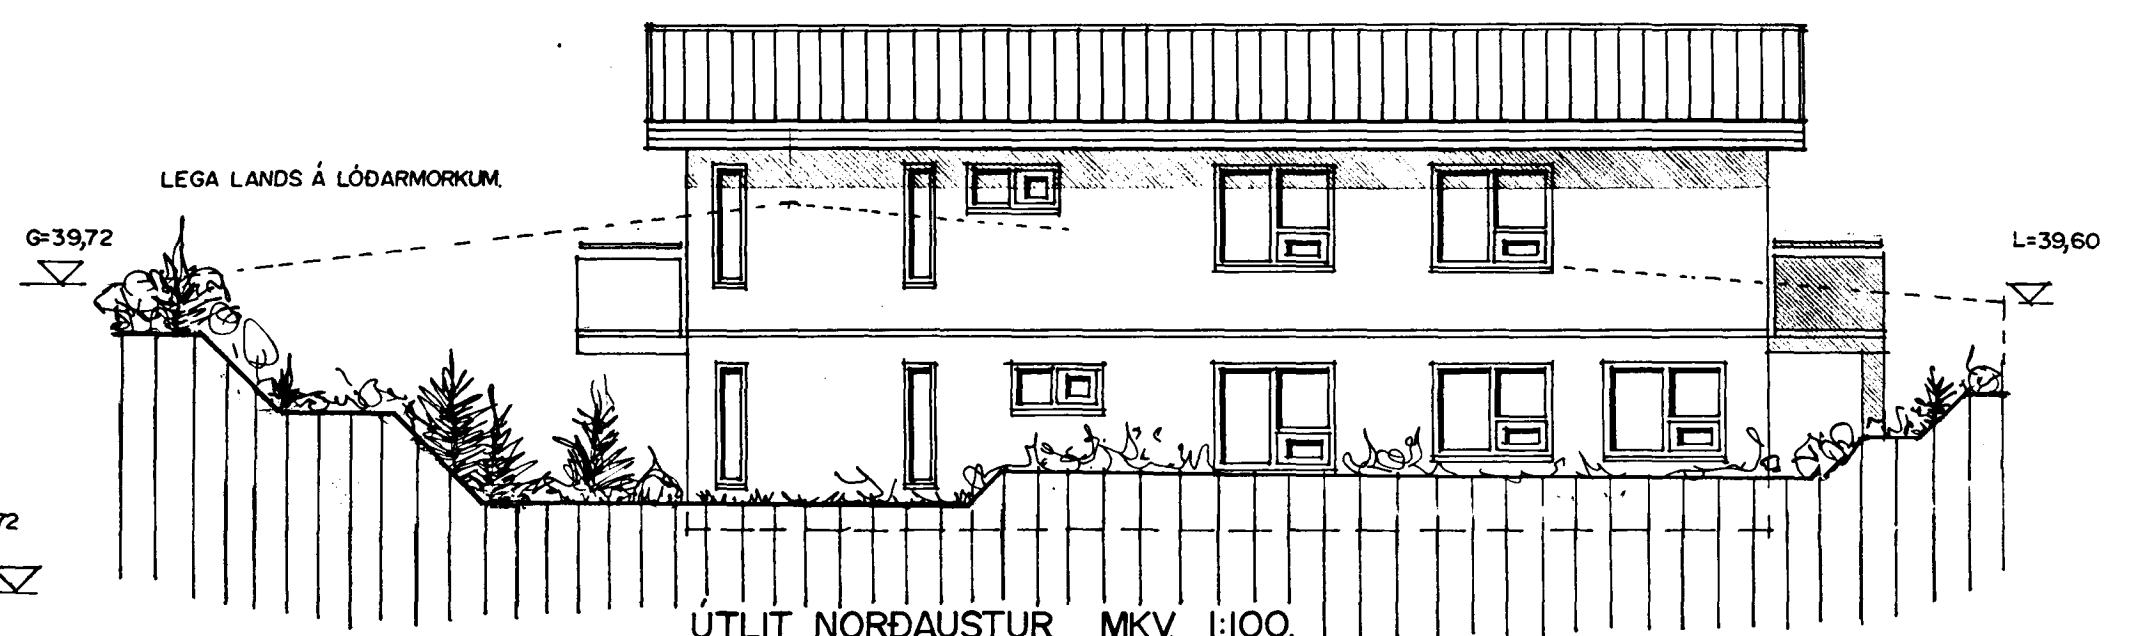

ÚTLIT NORÐAUSTUR MKV. 1:100

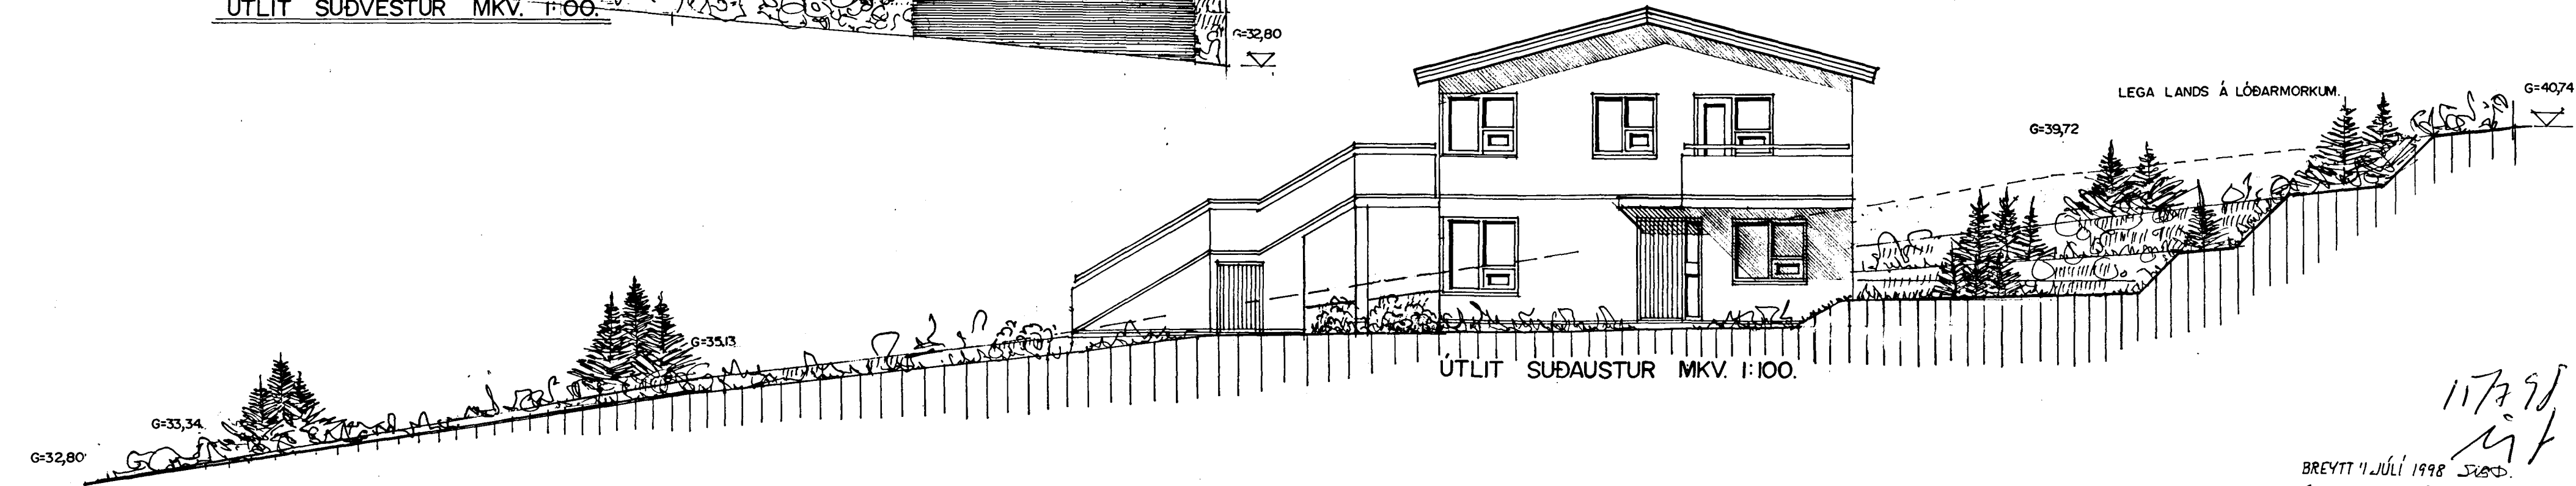

ÚTLIT SUÐAUSTUR MKV. 1:100