



Úr Gildi

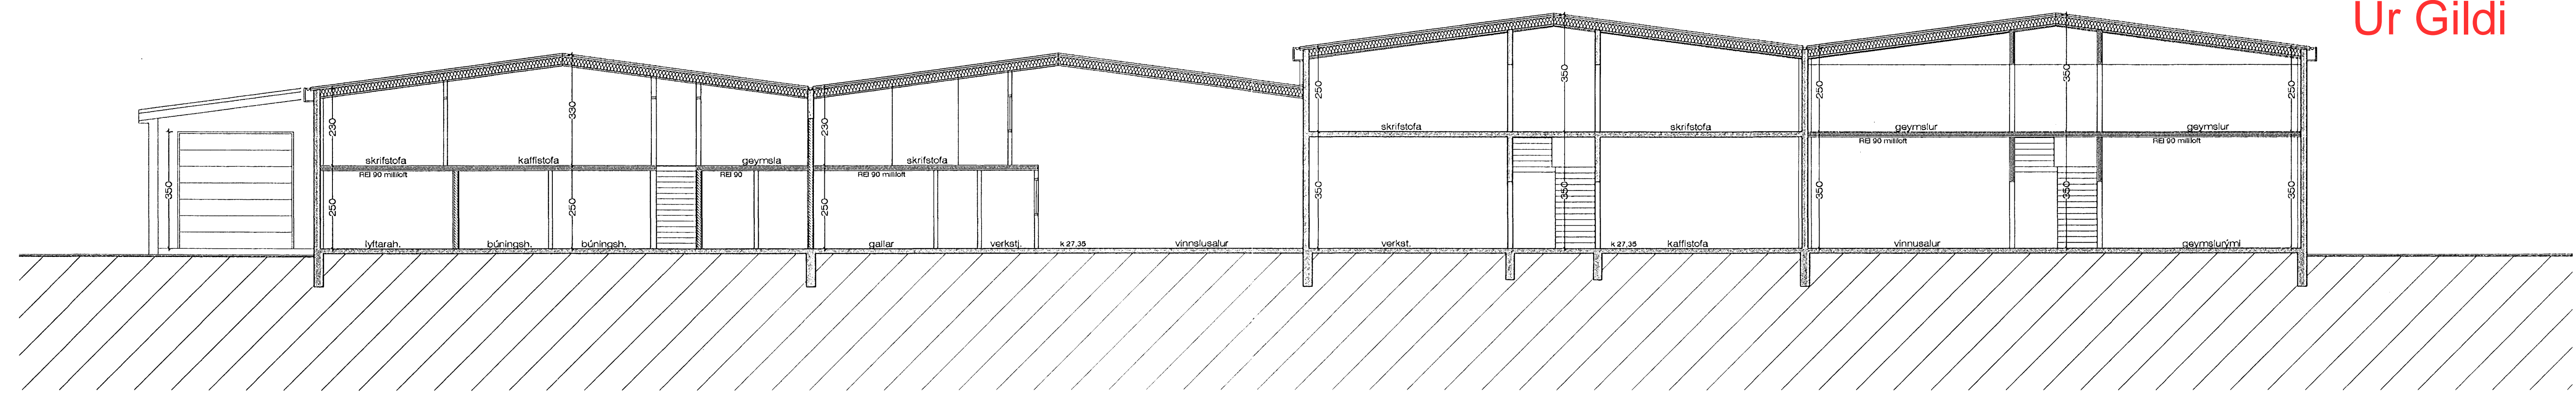

SNEIÐING A - A 1:100

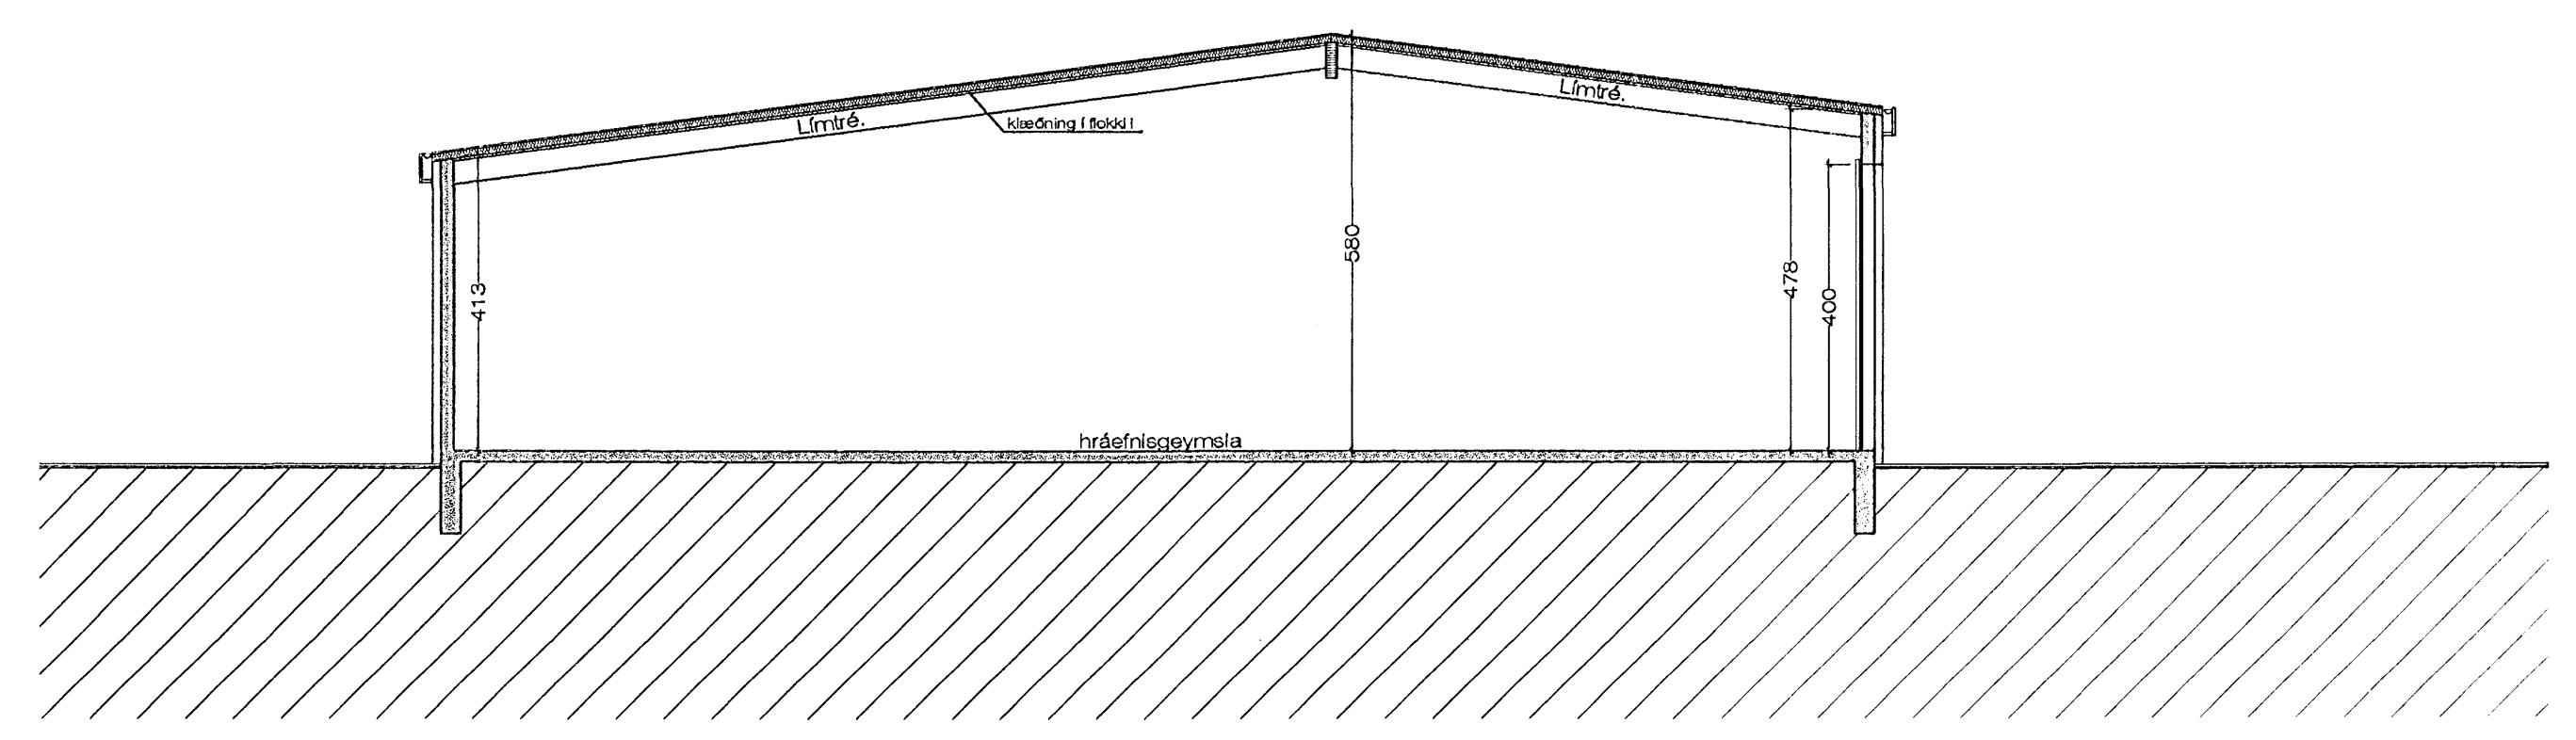

SNEIÐING B - B 1:100 stækkun 407,8 m²

5/9/06
[Professional Seal]

Stækkun á MHL 01 25.08.2000

eyarm1903.dwg 21.8.2006 10:32 Jón Guðmundsson arkitekt. Subútlantsbraut. 16