


LÖNSBRAUT NR 52

Samþykkt þann


21. DES. 2005

Byggingafulltrúinn í Hafnarfirði
Eh. Kristján Þórarinnsson


BP

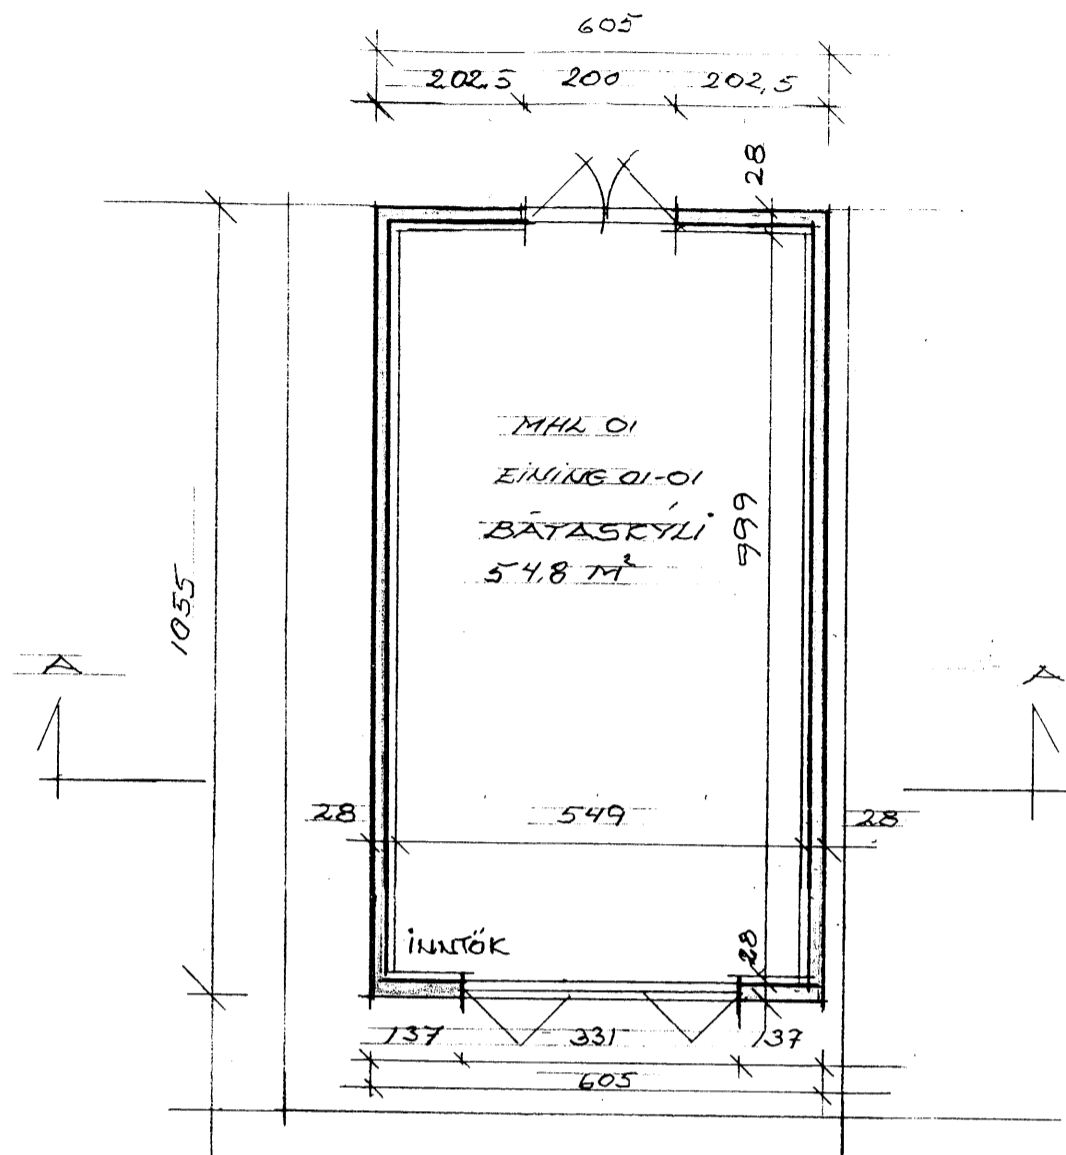


GRUNNMYND HÉÐAR M=1:100

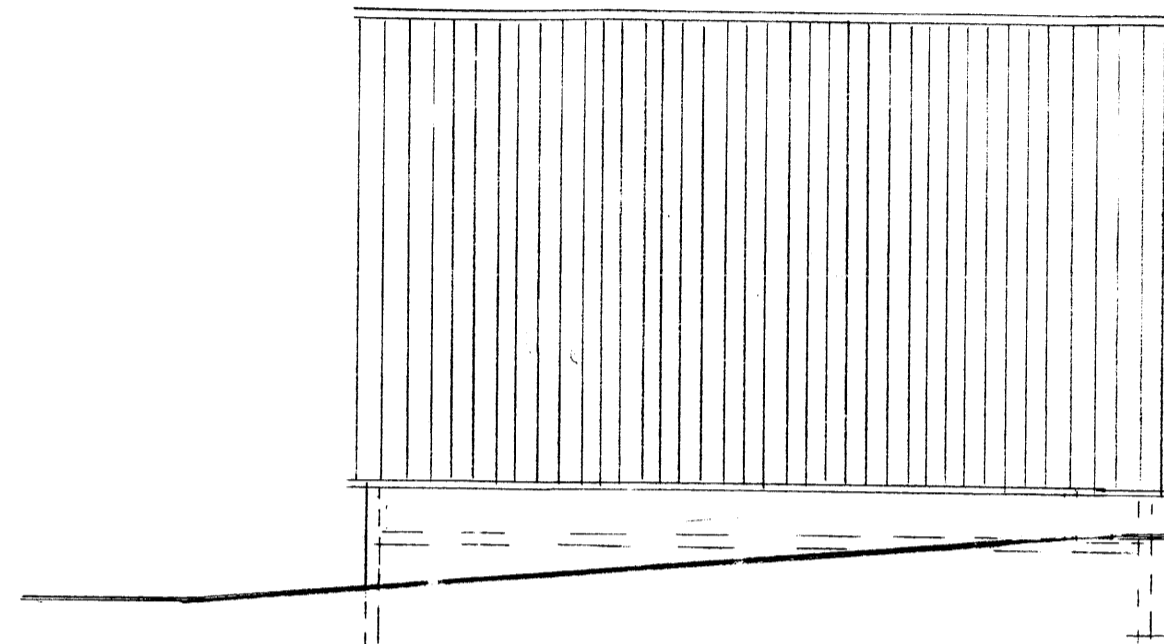


ÚTLIT VESTUR M=1:100

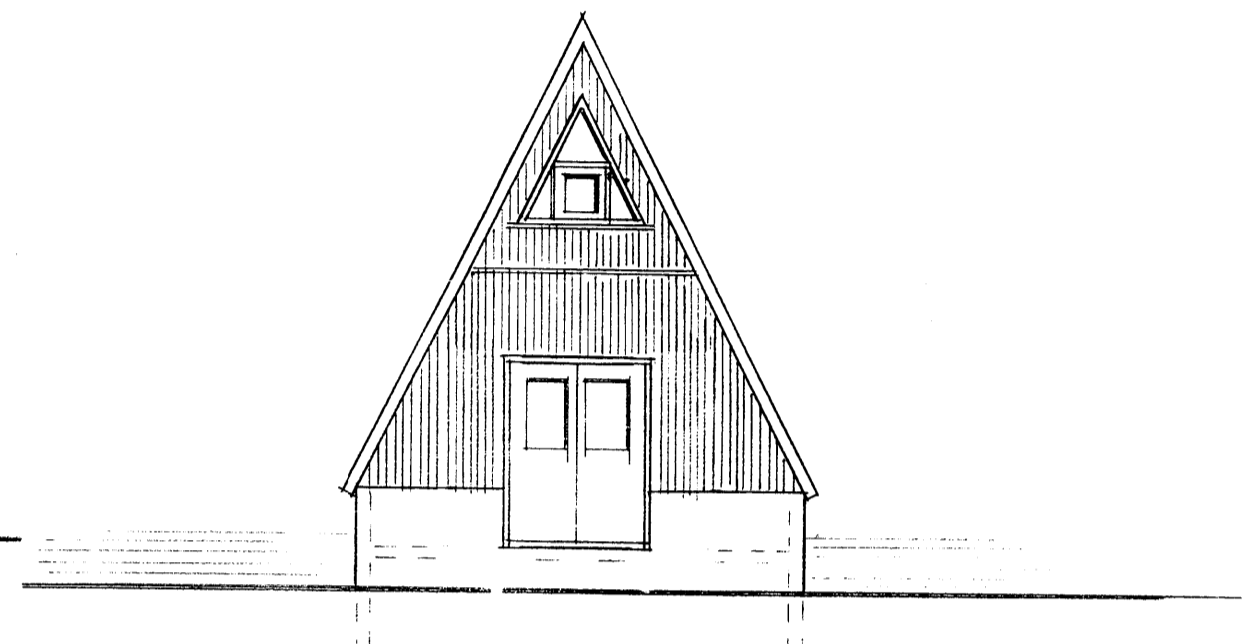


ÚTLIT NORÐUR M=1:100

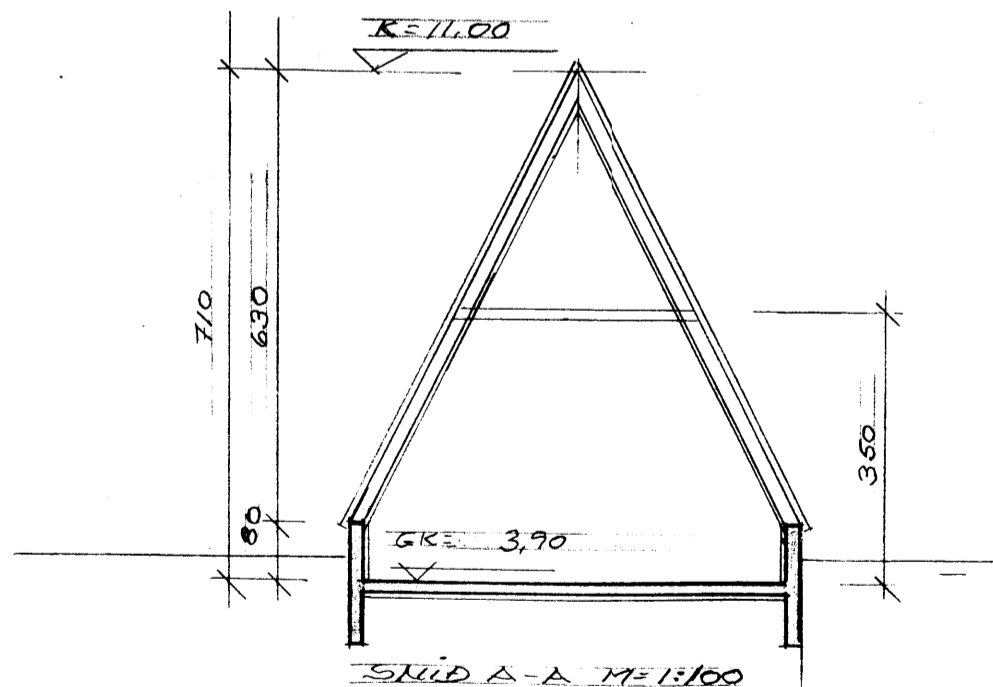

SNID A-A M=1:100

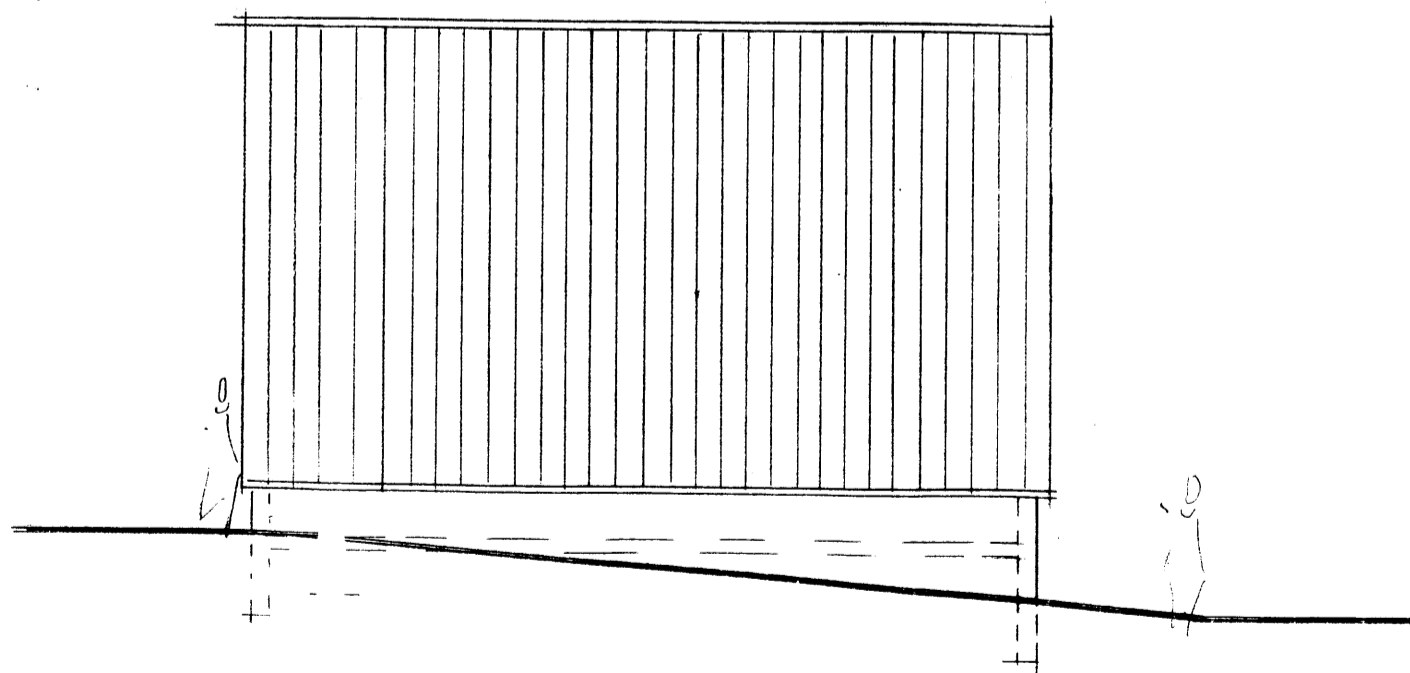

ÚTLIT AUSTUR M=1:100

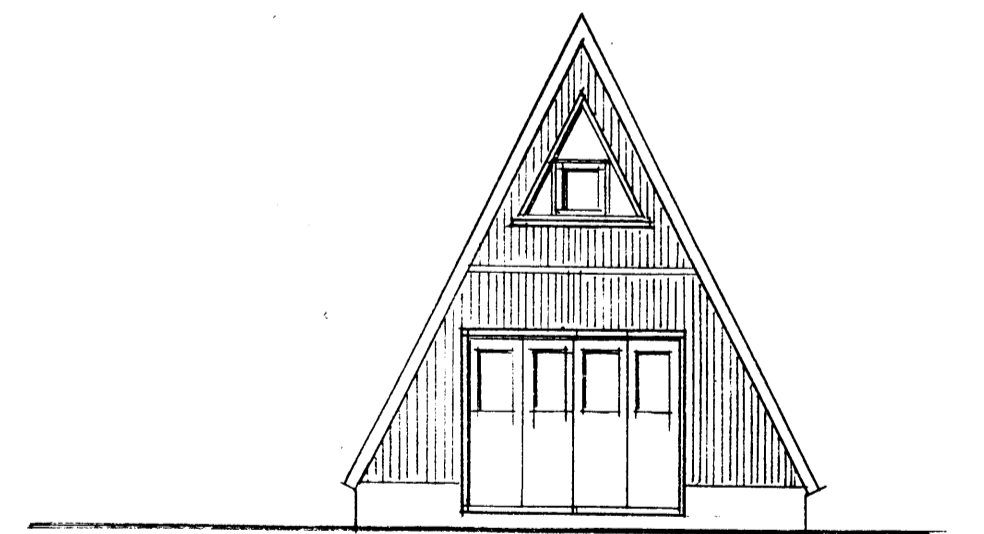

ÚTLIT SUDUR M=1:100

25. OKT. 2005
HÚS HÆKKAD UM 25CM
8. DES. 05
HÉÐARSETNING HÚSS.

BP

L. NR. 121125

LÖNSBRAUT NR 52 MHL 01

GRUNNMYND/SNID/ÚTLIT

ERLENDUR Á HJÁLHARSSON BT KLÉBERGI 6
EF 100355 5239 5-555 3860

101

DRÖG 05.09'04

MÁK 1:100