




F Útlit norður, mkv. 1:100

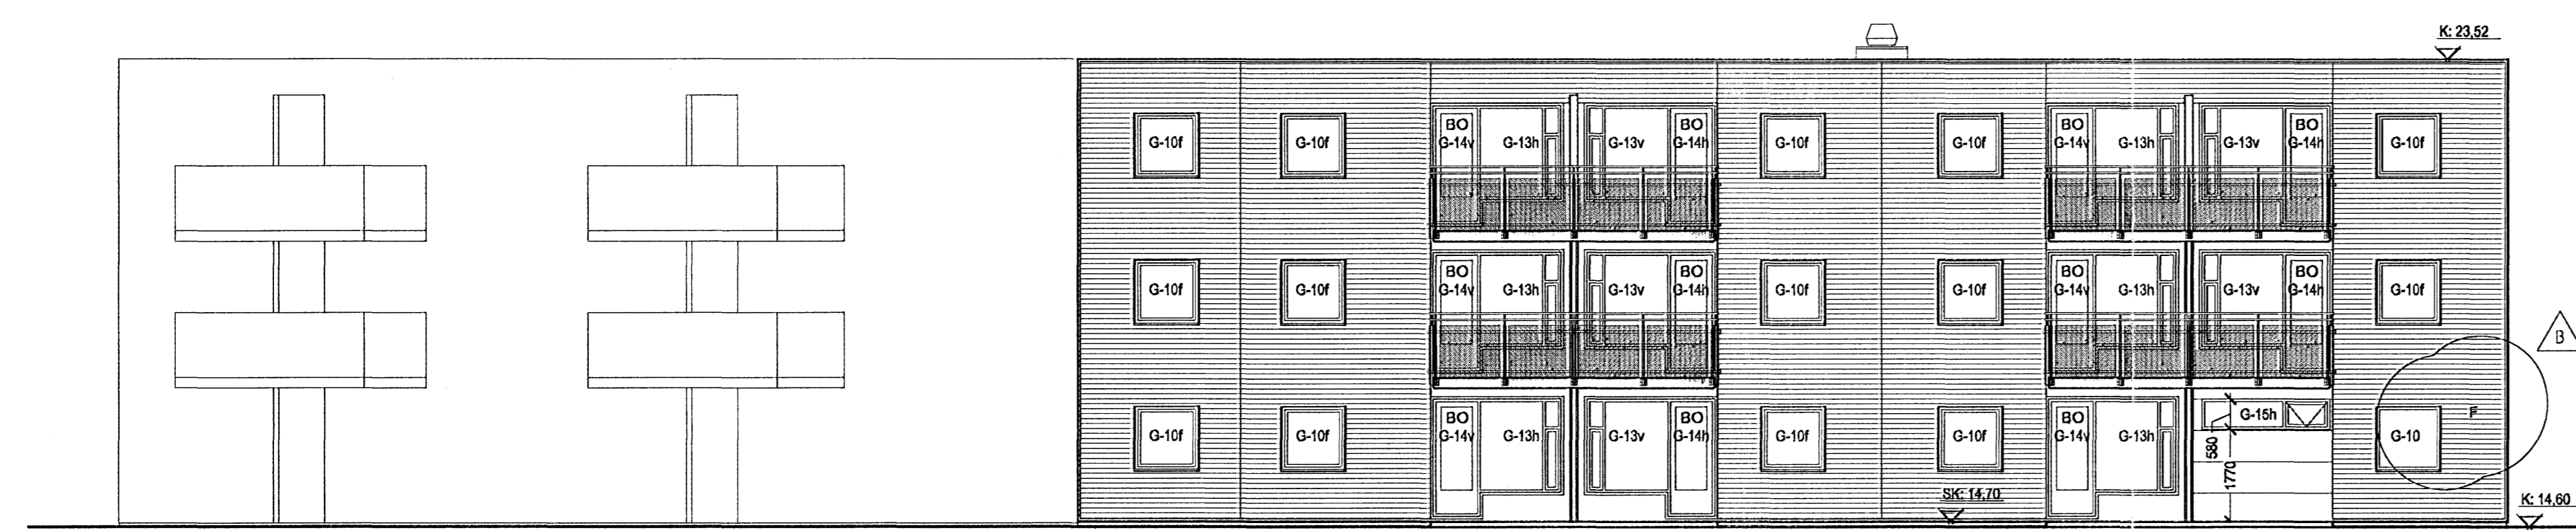


F Útlit suður, mkv. 1:100

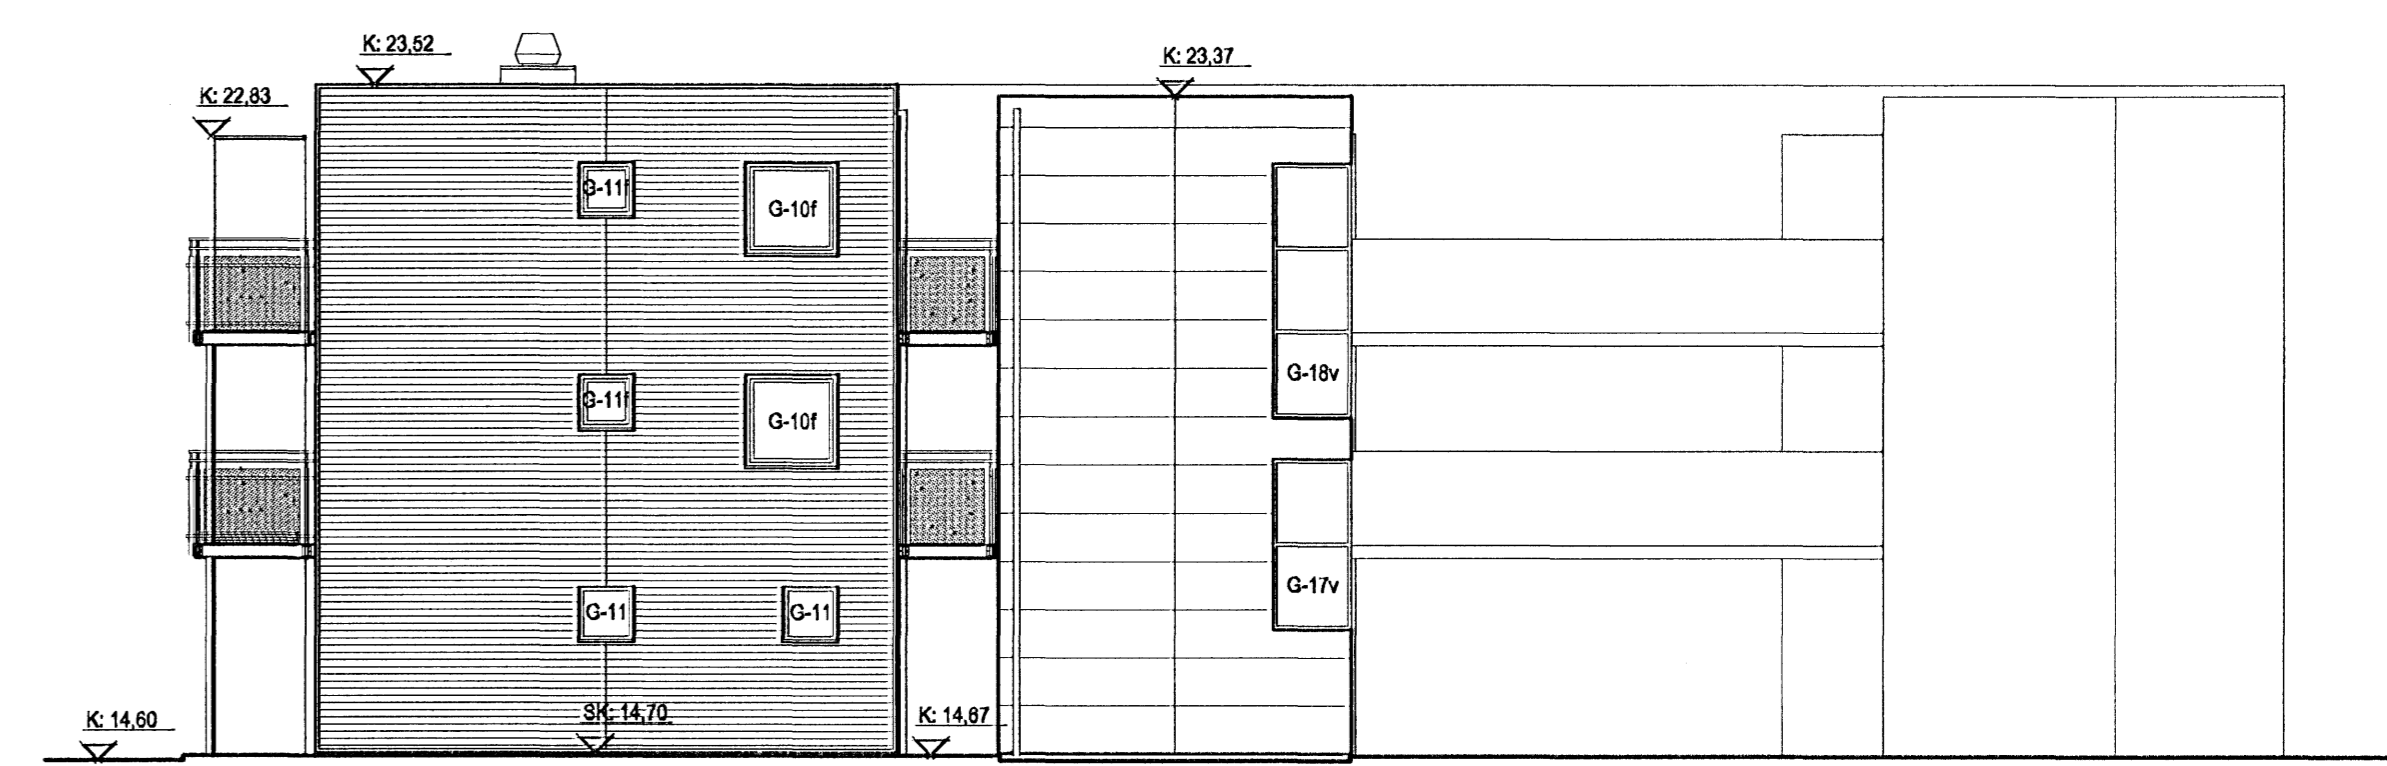


F Útlit austur, mkv. 1:100

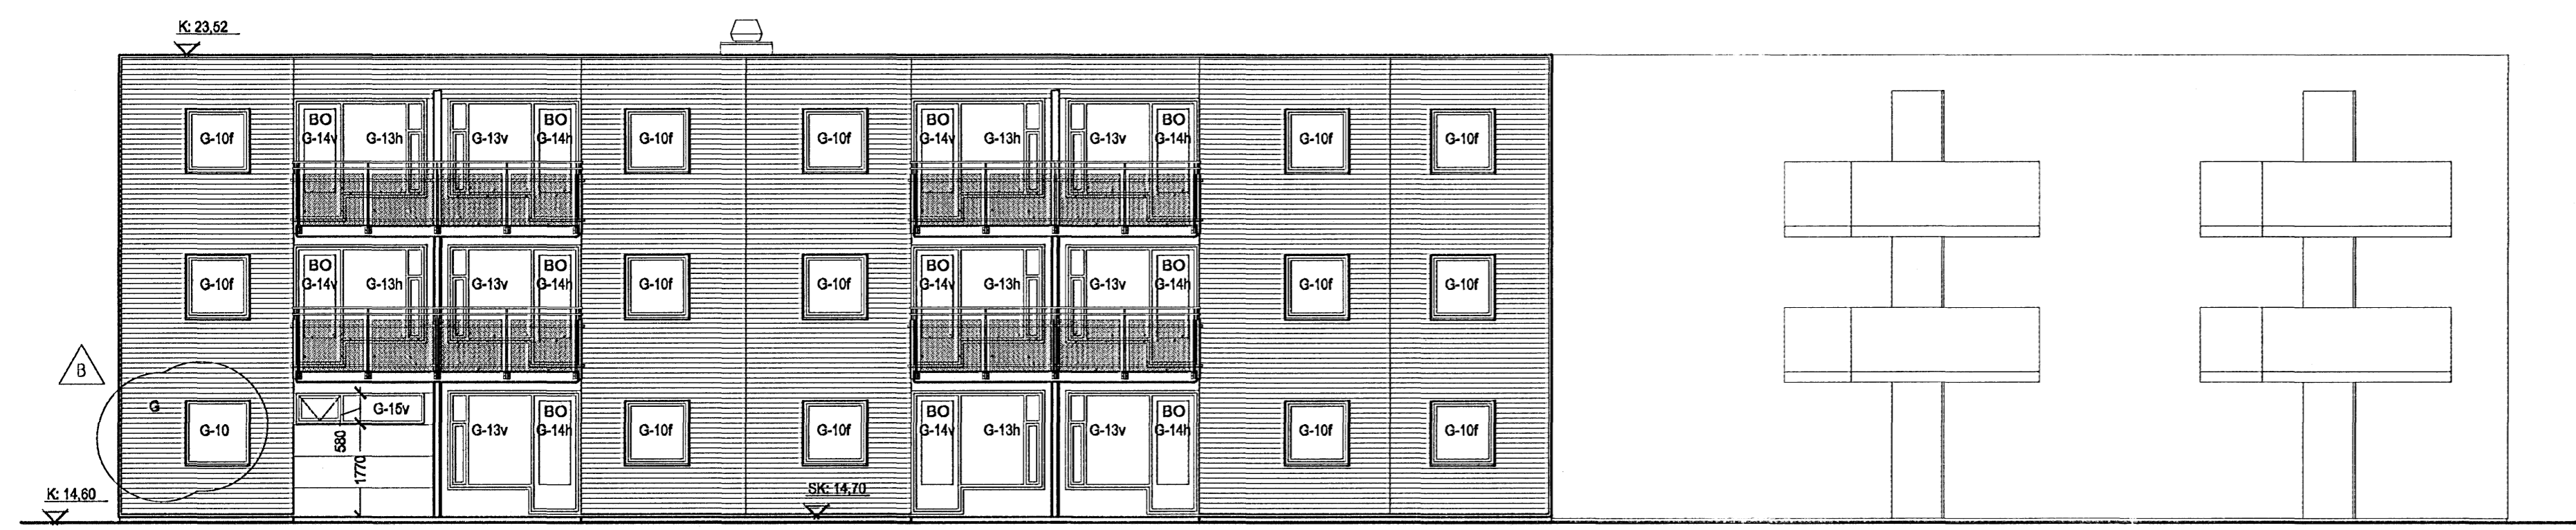


G Útlit suðvestur, mkv. 1:100

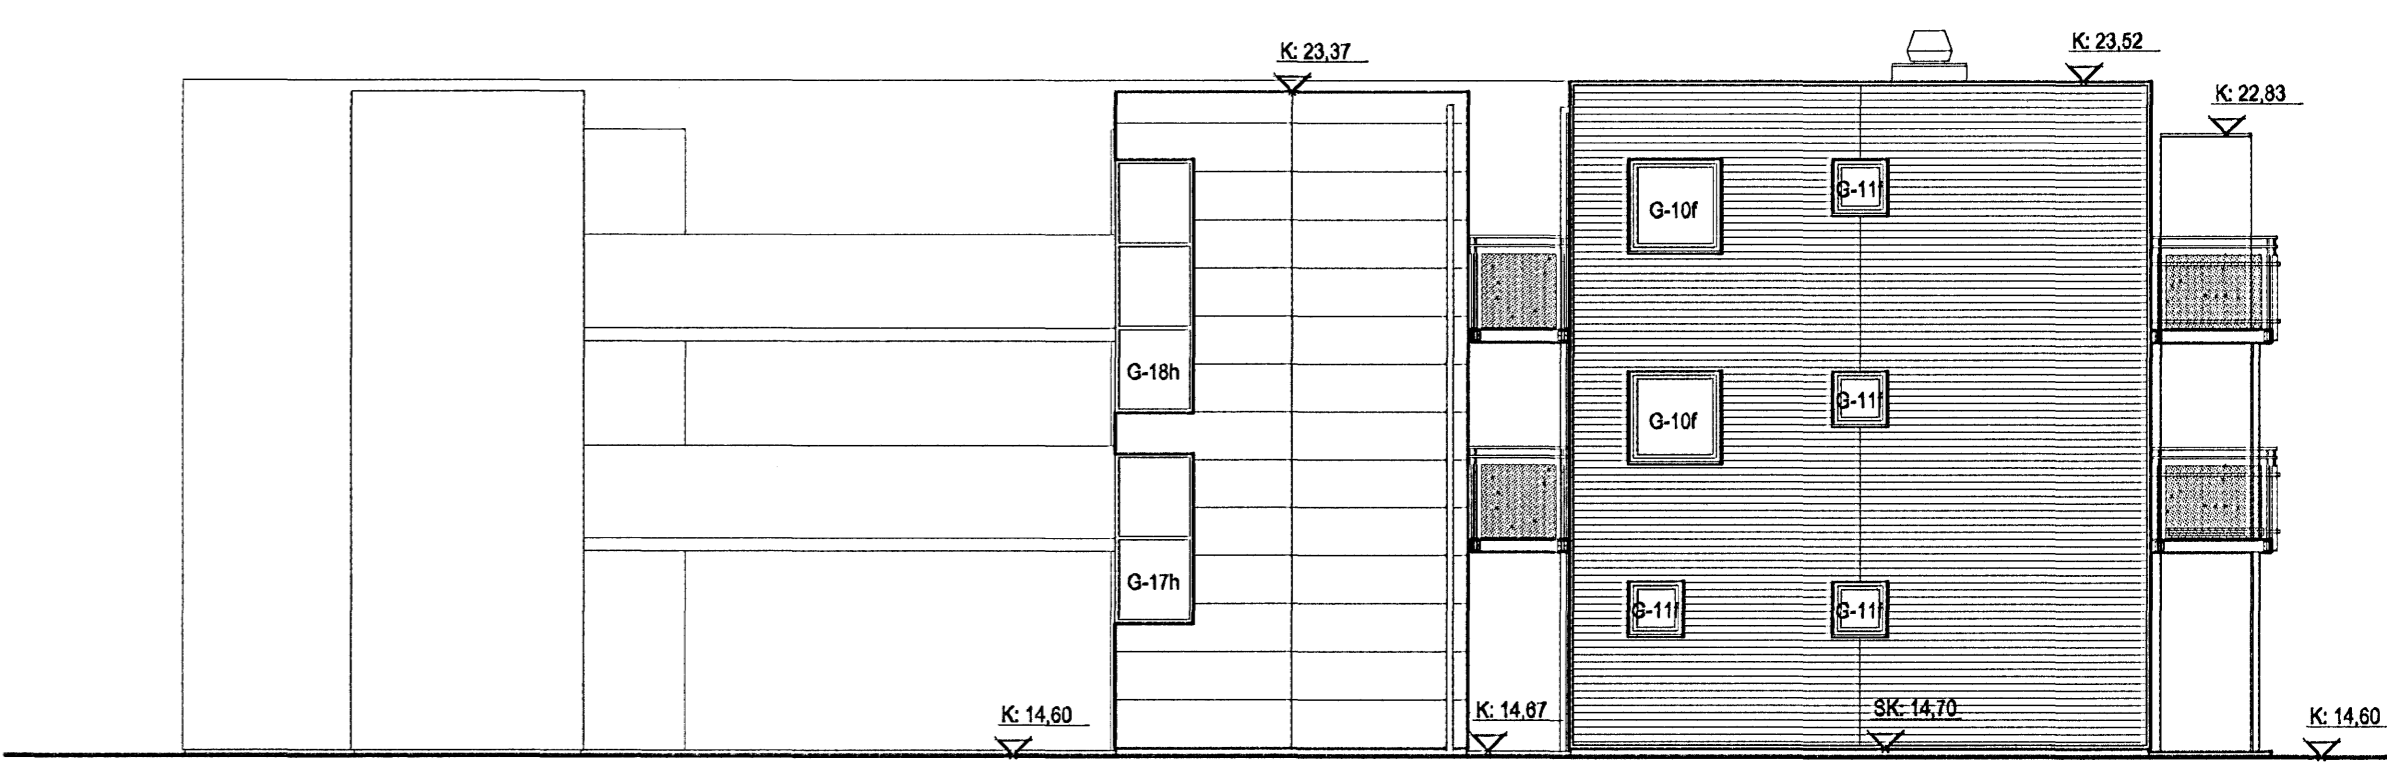

G Útlit norðvestur, mkv. 1:100

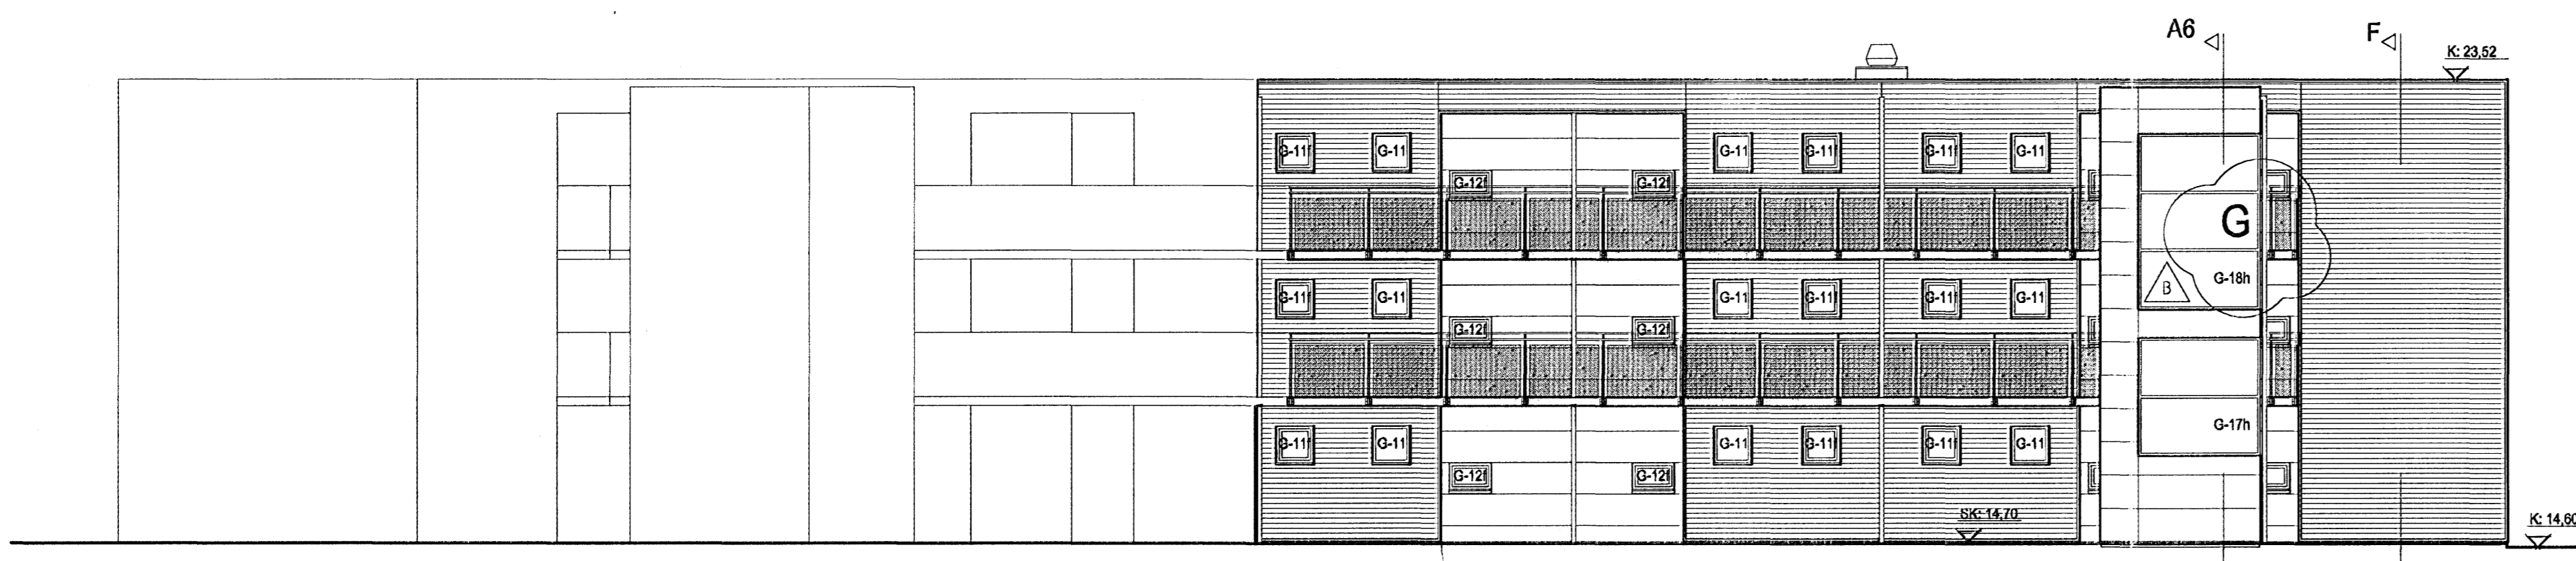

G Útlit norðaustur, mkv. 1:100

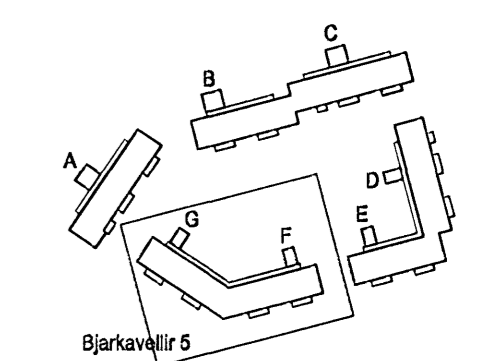

Making húsa 18.09.2006 vm
Ýsing breyting dags teiknad

ARKIS
arkitektar og ráðgjafar

Adalsteinn Brannson arkitekt hf 101151-2769
Björg Pálsson arkitekt hf 020462-4889
Egill Guðmundsson arkitekt hf 270219-6869
Ólaf Guðsson arkitekt hf 100567-4909
Hönnuður Álfgrímsson Byggingarfulltrúi hf 200270-3009

sími 911 2060 sími 911 2056 sími 911 2056 netfang ark@arkis.is



Aðalteikningar
Skýringartextill: F-G Útlit
hannað / teiknað: 164, v.m., mll
yfirlit / samþykkt: gð
málkvæði: 1:100

dagsetning: 22.02.2006
verkefni: 06-040
(99)2.13 B
teikning breyting