


ppp


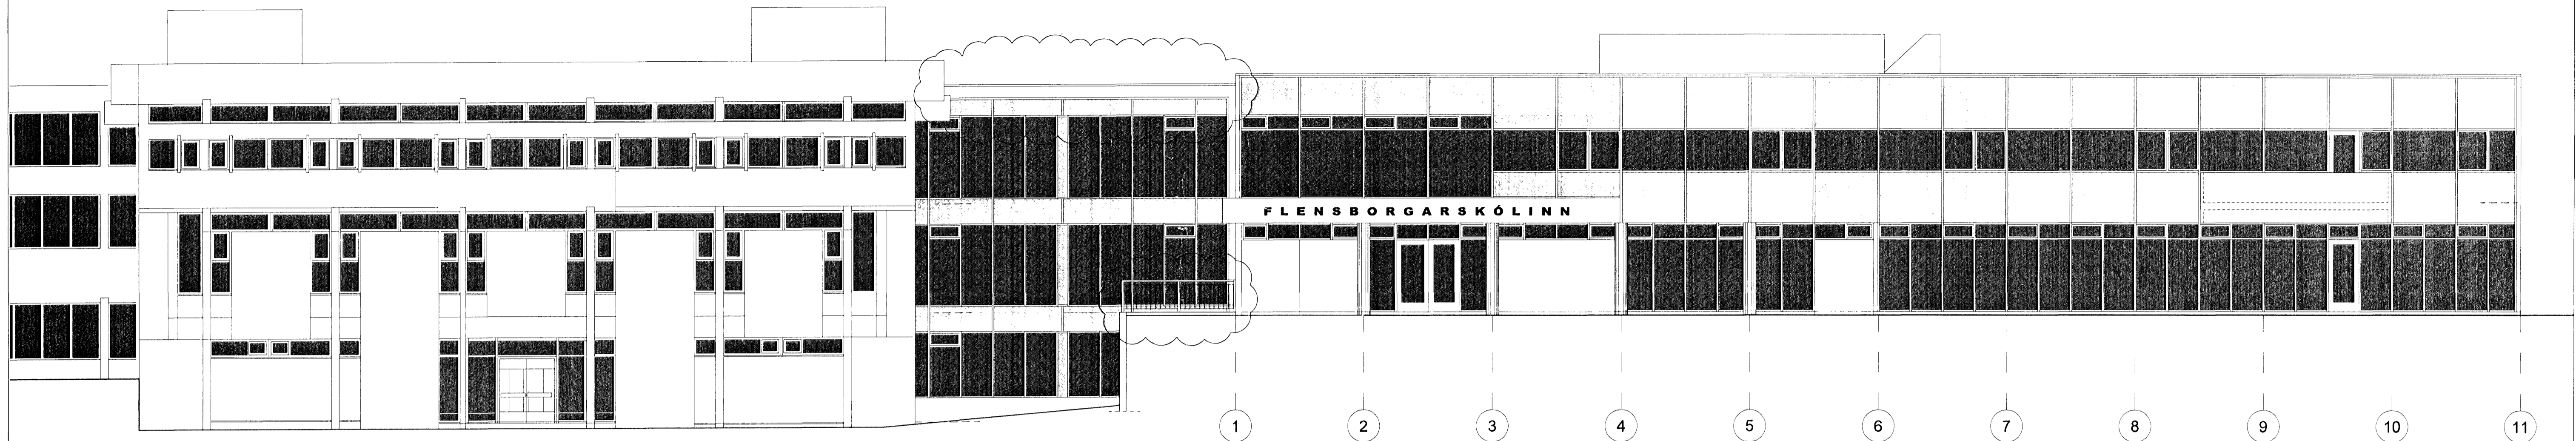


FLENSBORGARSKÓLINN

1 2 3 4 5 6 7 8 9 10 11

MHL 02 MHL 03

SUÐUR

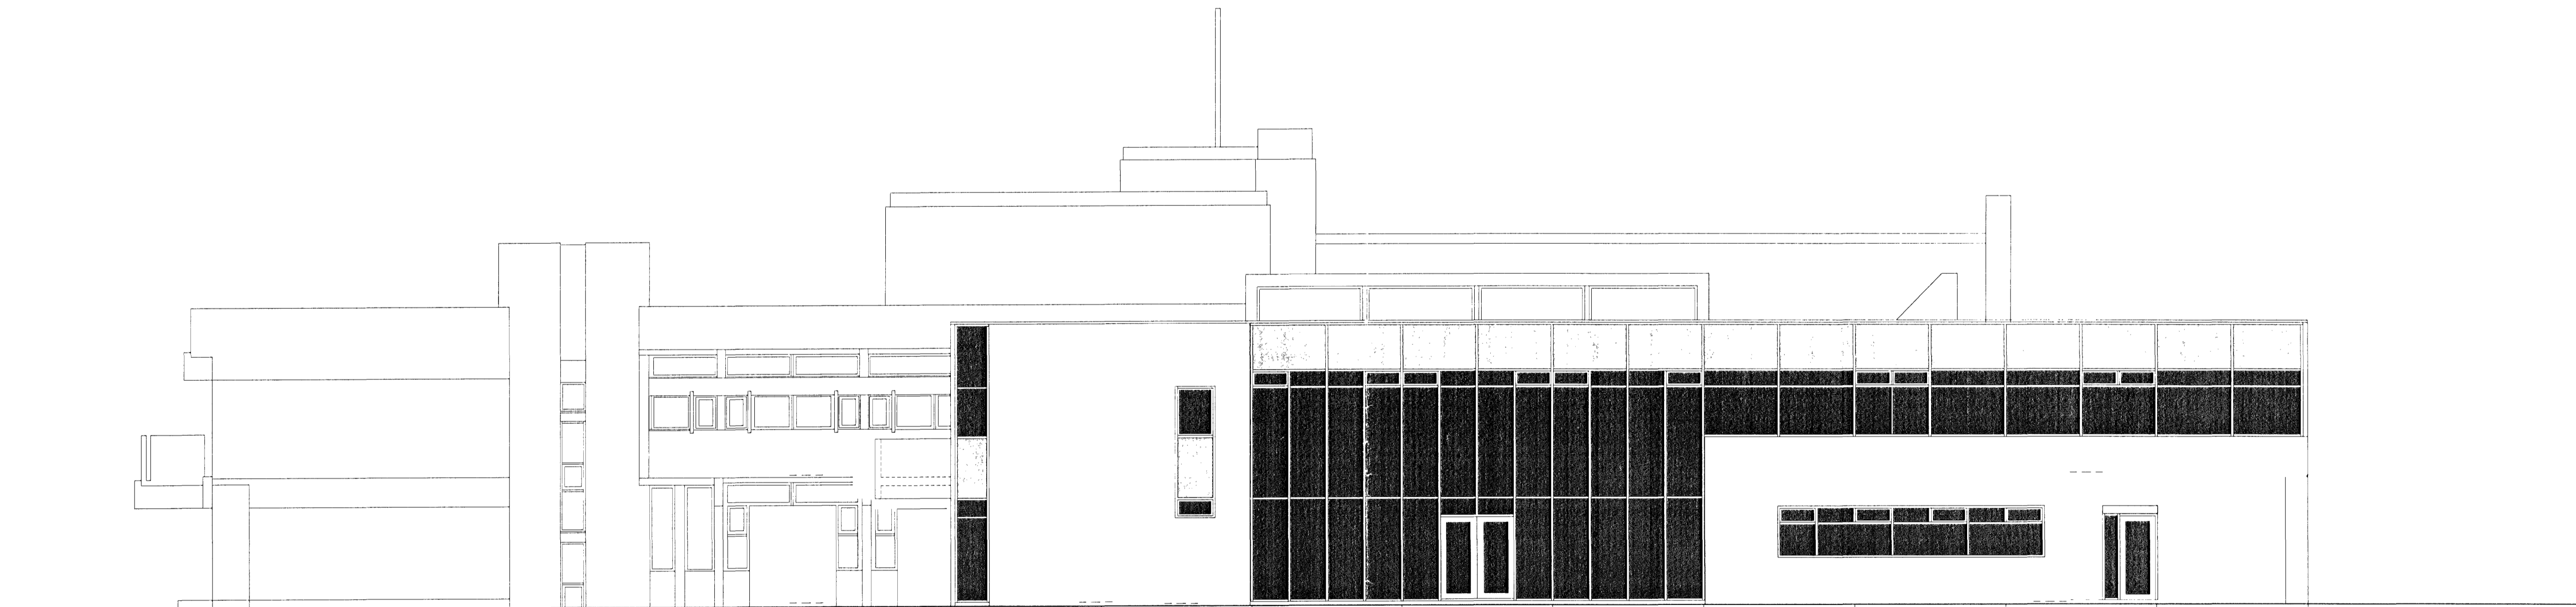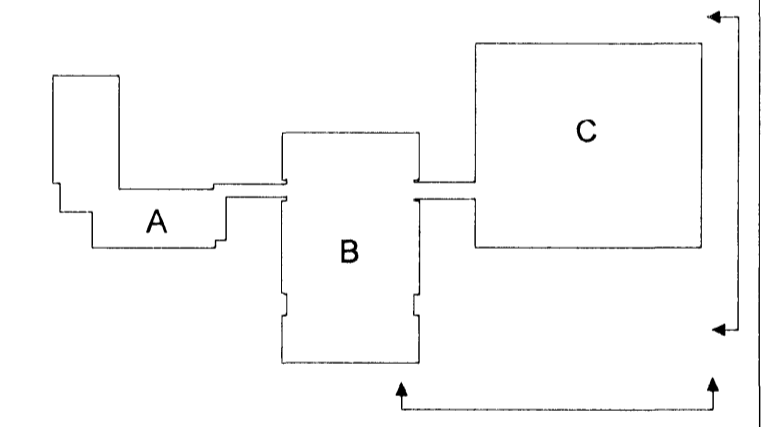

A B C D E F G H I J

AUSTUR

DAGSETNING	BREYTING	SAMÞYKKT
17.08.2006	A	GG
	B	
	C	
	D	

STAÐUR:  
BREKKUGATA 19  
HAFNARFJÖRÐUR

VERK:  
FLENSBORGARSKÓLI  
YFIRLITSMYND

TEIKNING:  
ÚTLIT SUÐUR OG AUSTUR

VERKNR:	MÆLIKVAÐI:	TEIKN NR:
171C	1:100	C105
	TEIKNAD: 14.4.2005 FSK	

**ARKITEKTASTOFAN** ehf.   
Ormar Þór Guðmundsson og Órnólfur Hall  
Sóltún 1 IS-105 Reykjavík Sími 562 6833 Fax 562 6835  
arkitektastofan@arkitektastofan.is www.arkitektastofan.is

