

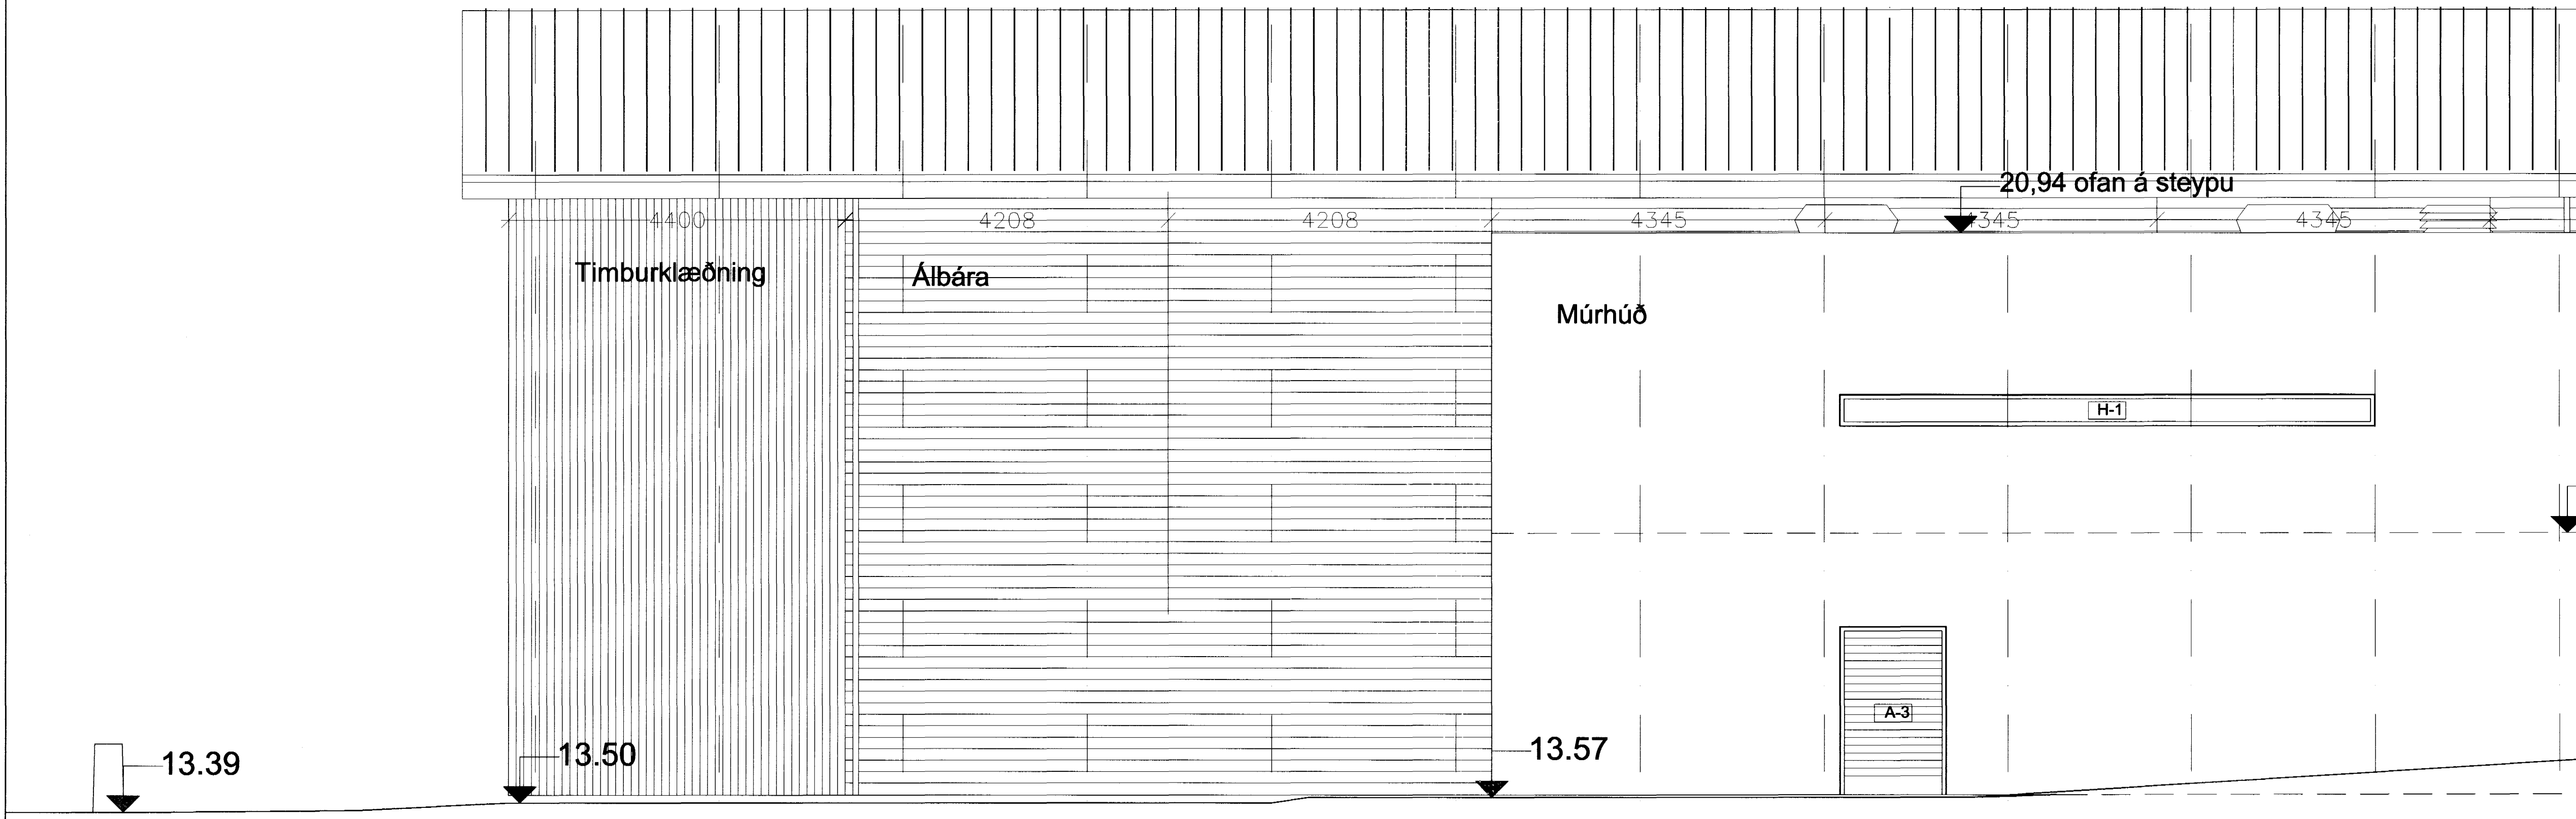



ÚTLIT TIL SUÐVESTUR

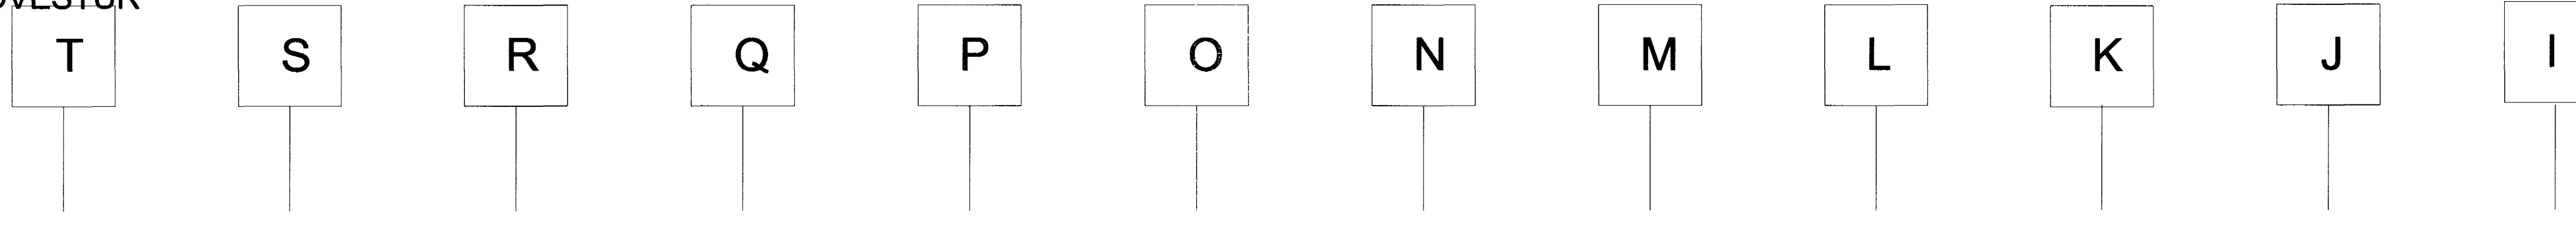

ÚTLIT TIL NORÐAUSTUR

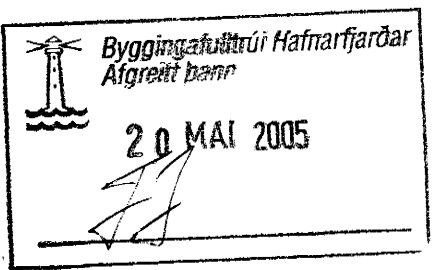

Sigríður Ólafsdóttir 011070-5069

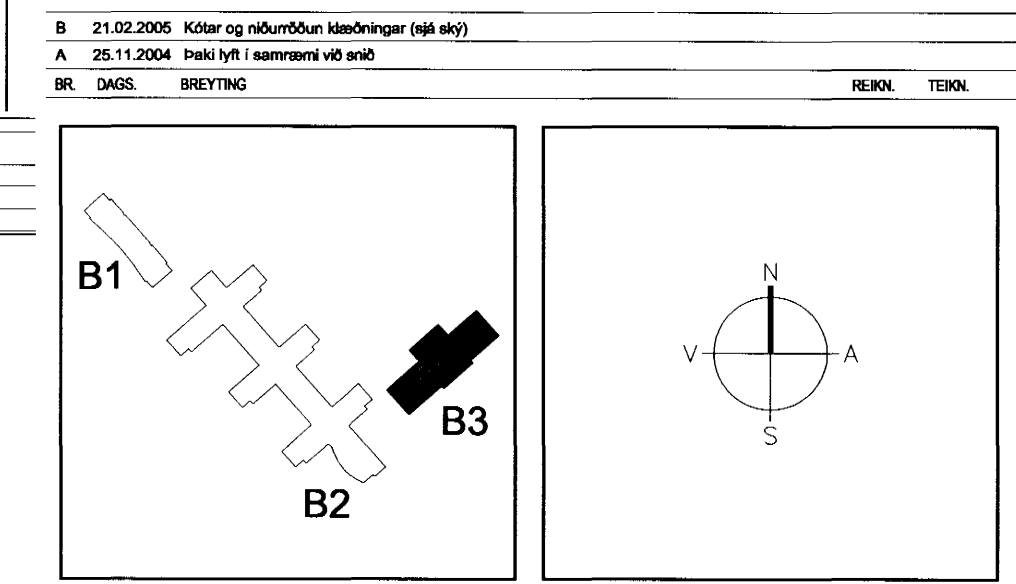

Á STOFUNNI  
ARKITEKTAR

FINNUR BJÖRGVINSSON  
HILMAR ÞÓR BJÖRNSSON  
SIGRÍÐUR ÓLAFSDÓTTIR

BERGSTADASTRÆTI 10, RVK. sími:551-1460, netfang:stofunni@stofunni.is

LANDMÖTUN

EINAR E. SÆMUNDSEN  
INGIBJÖRG KRISTJÁNSDÓTTIR  
MARGRÉT SIGURDARDÓTTIR

HYSTI, LUGUR 4 - 310 KOPAVOGUR - Sími 564 5300 - Fax 564 5300 - Netfang: landmotun@landmotun.is

VSO

VSO RÁÐGJÓF

RORGARTÚNI 20, 105 REYKJAVÍK, Sími 565 8000, Símahefi 565 8010, Netfang: vso@vso.is

SÓLVANGSVEGUR 4  
LÆKJARSKÓLI - ÍÞRÓTTAHÚSNÆÐI

ÚTLIT TIL NORÐVESTUR OG SUÐAUSTUR	HANNAÐ/TEKNI	SO
	ATH.	
	SAMÞYKKT	
	KT.	500589-1399
KVAFRÍ 1:50	REYKJAVÍK	23.09.2004
VERNRN	TEKNI. NR.	BR.
04-25	A-VU-002	B