
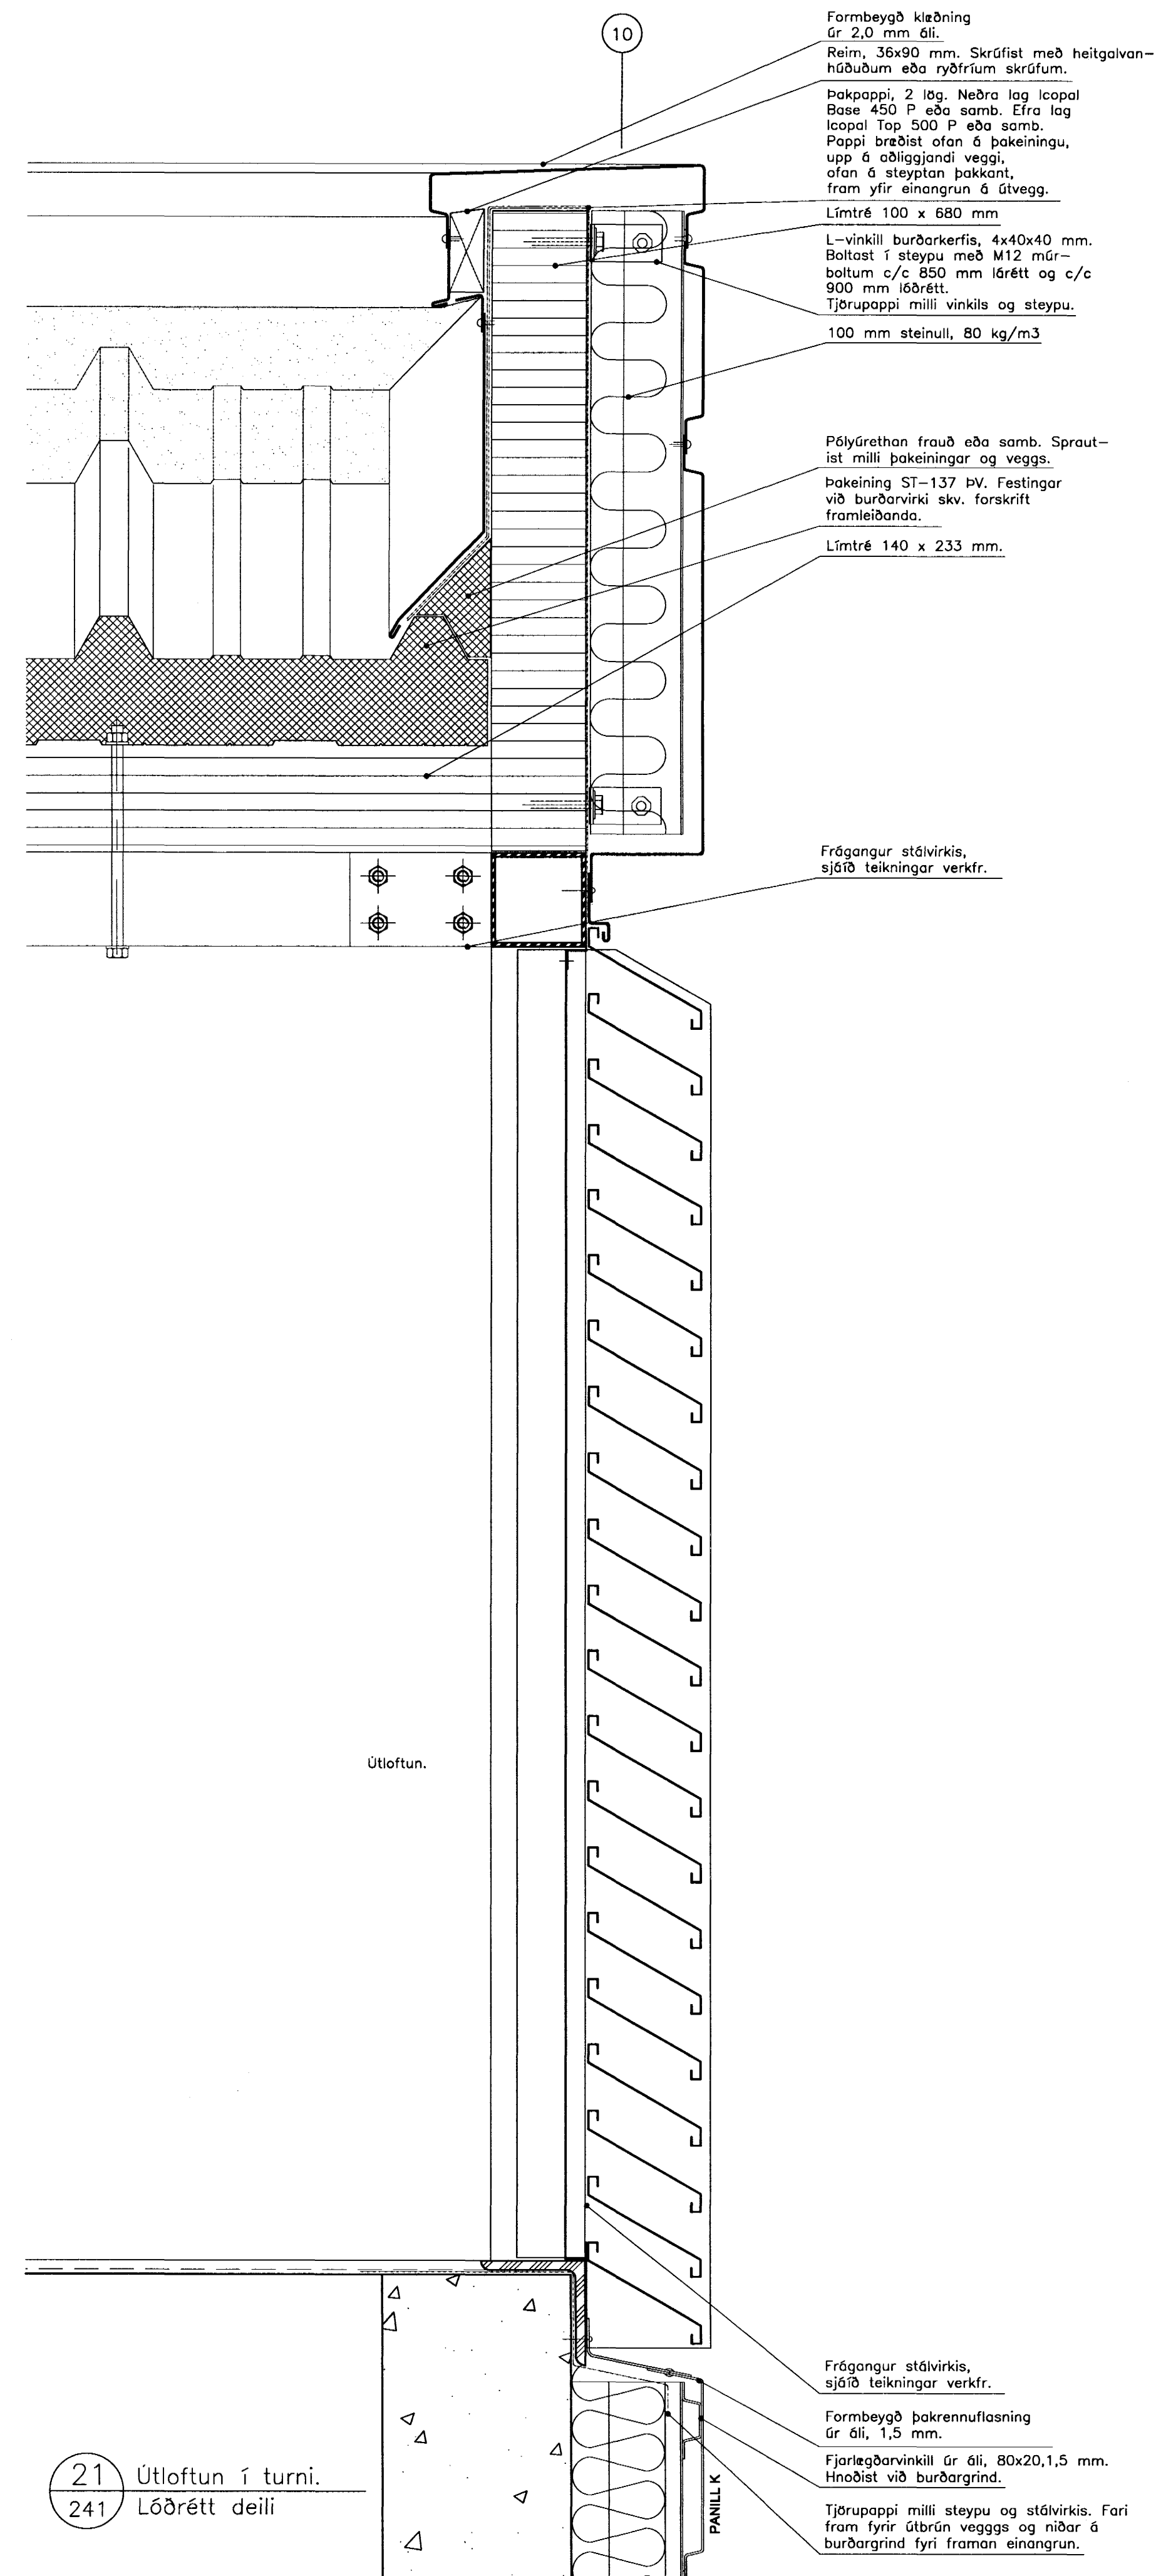
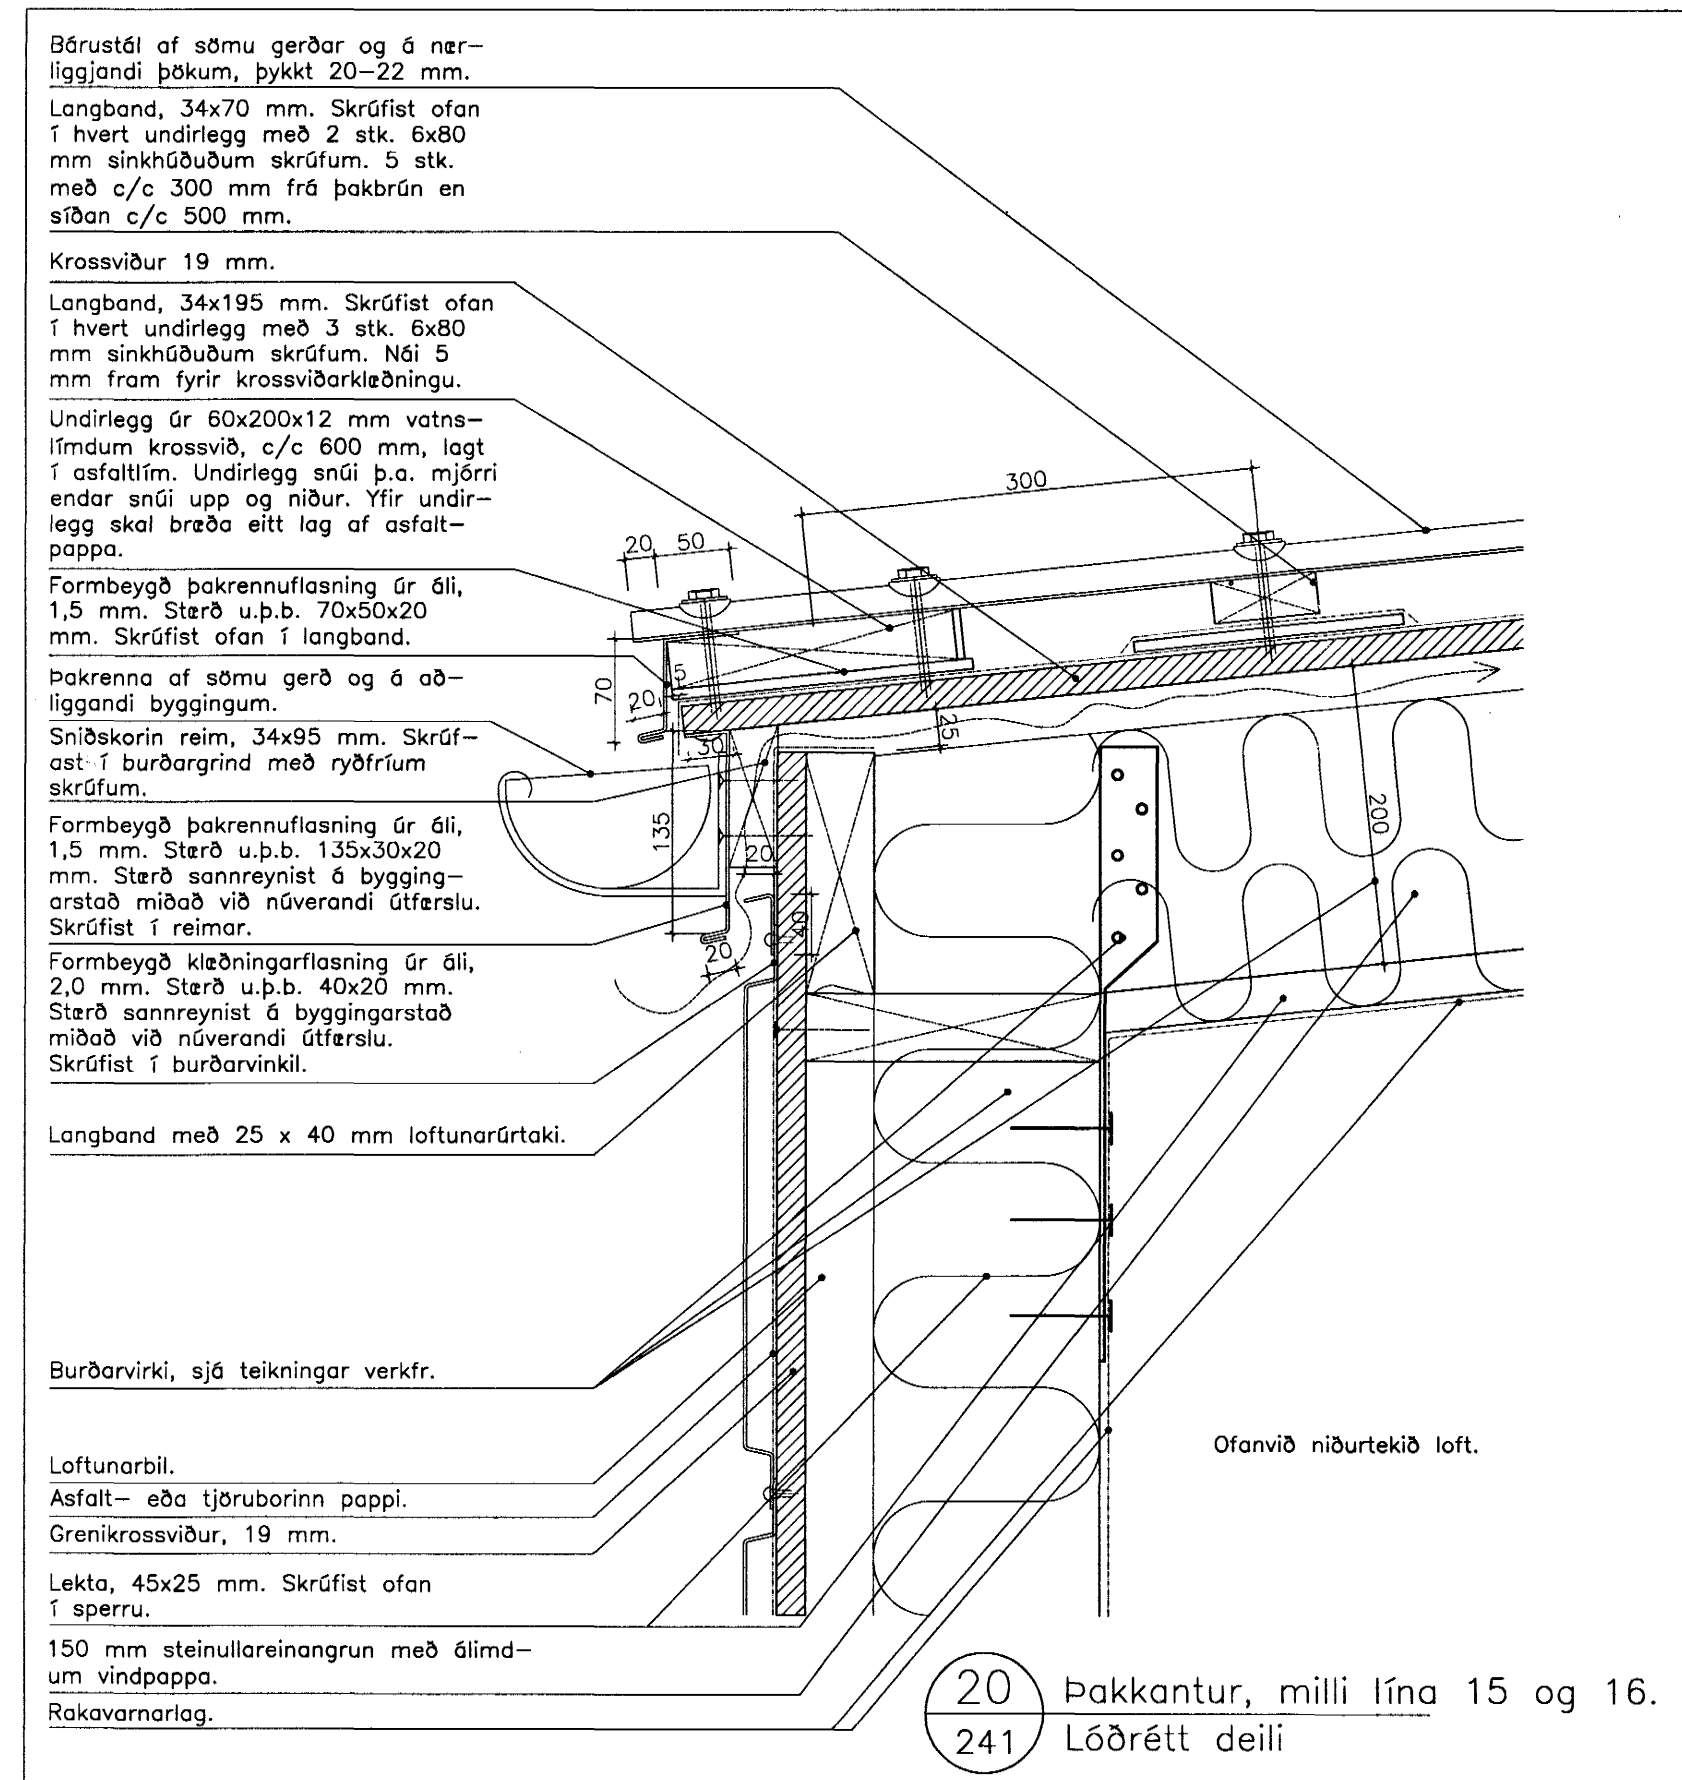


16 Veggjafrágangur
244 Lóðrétt deili

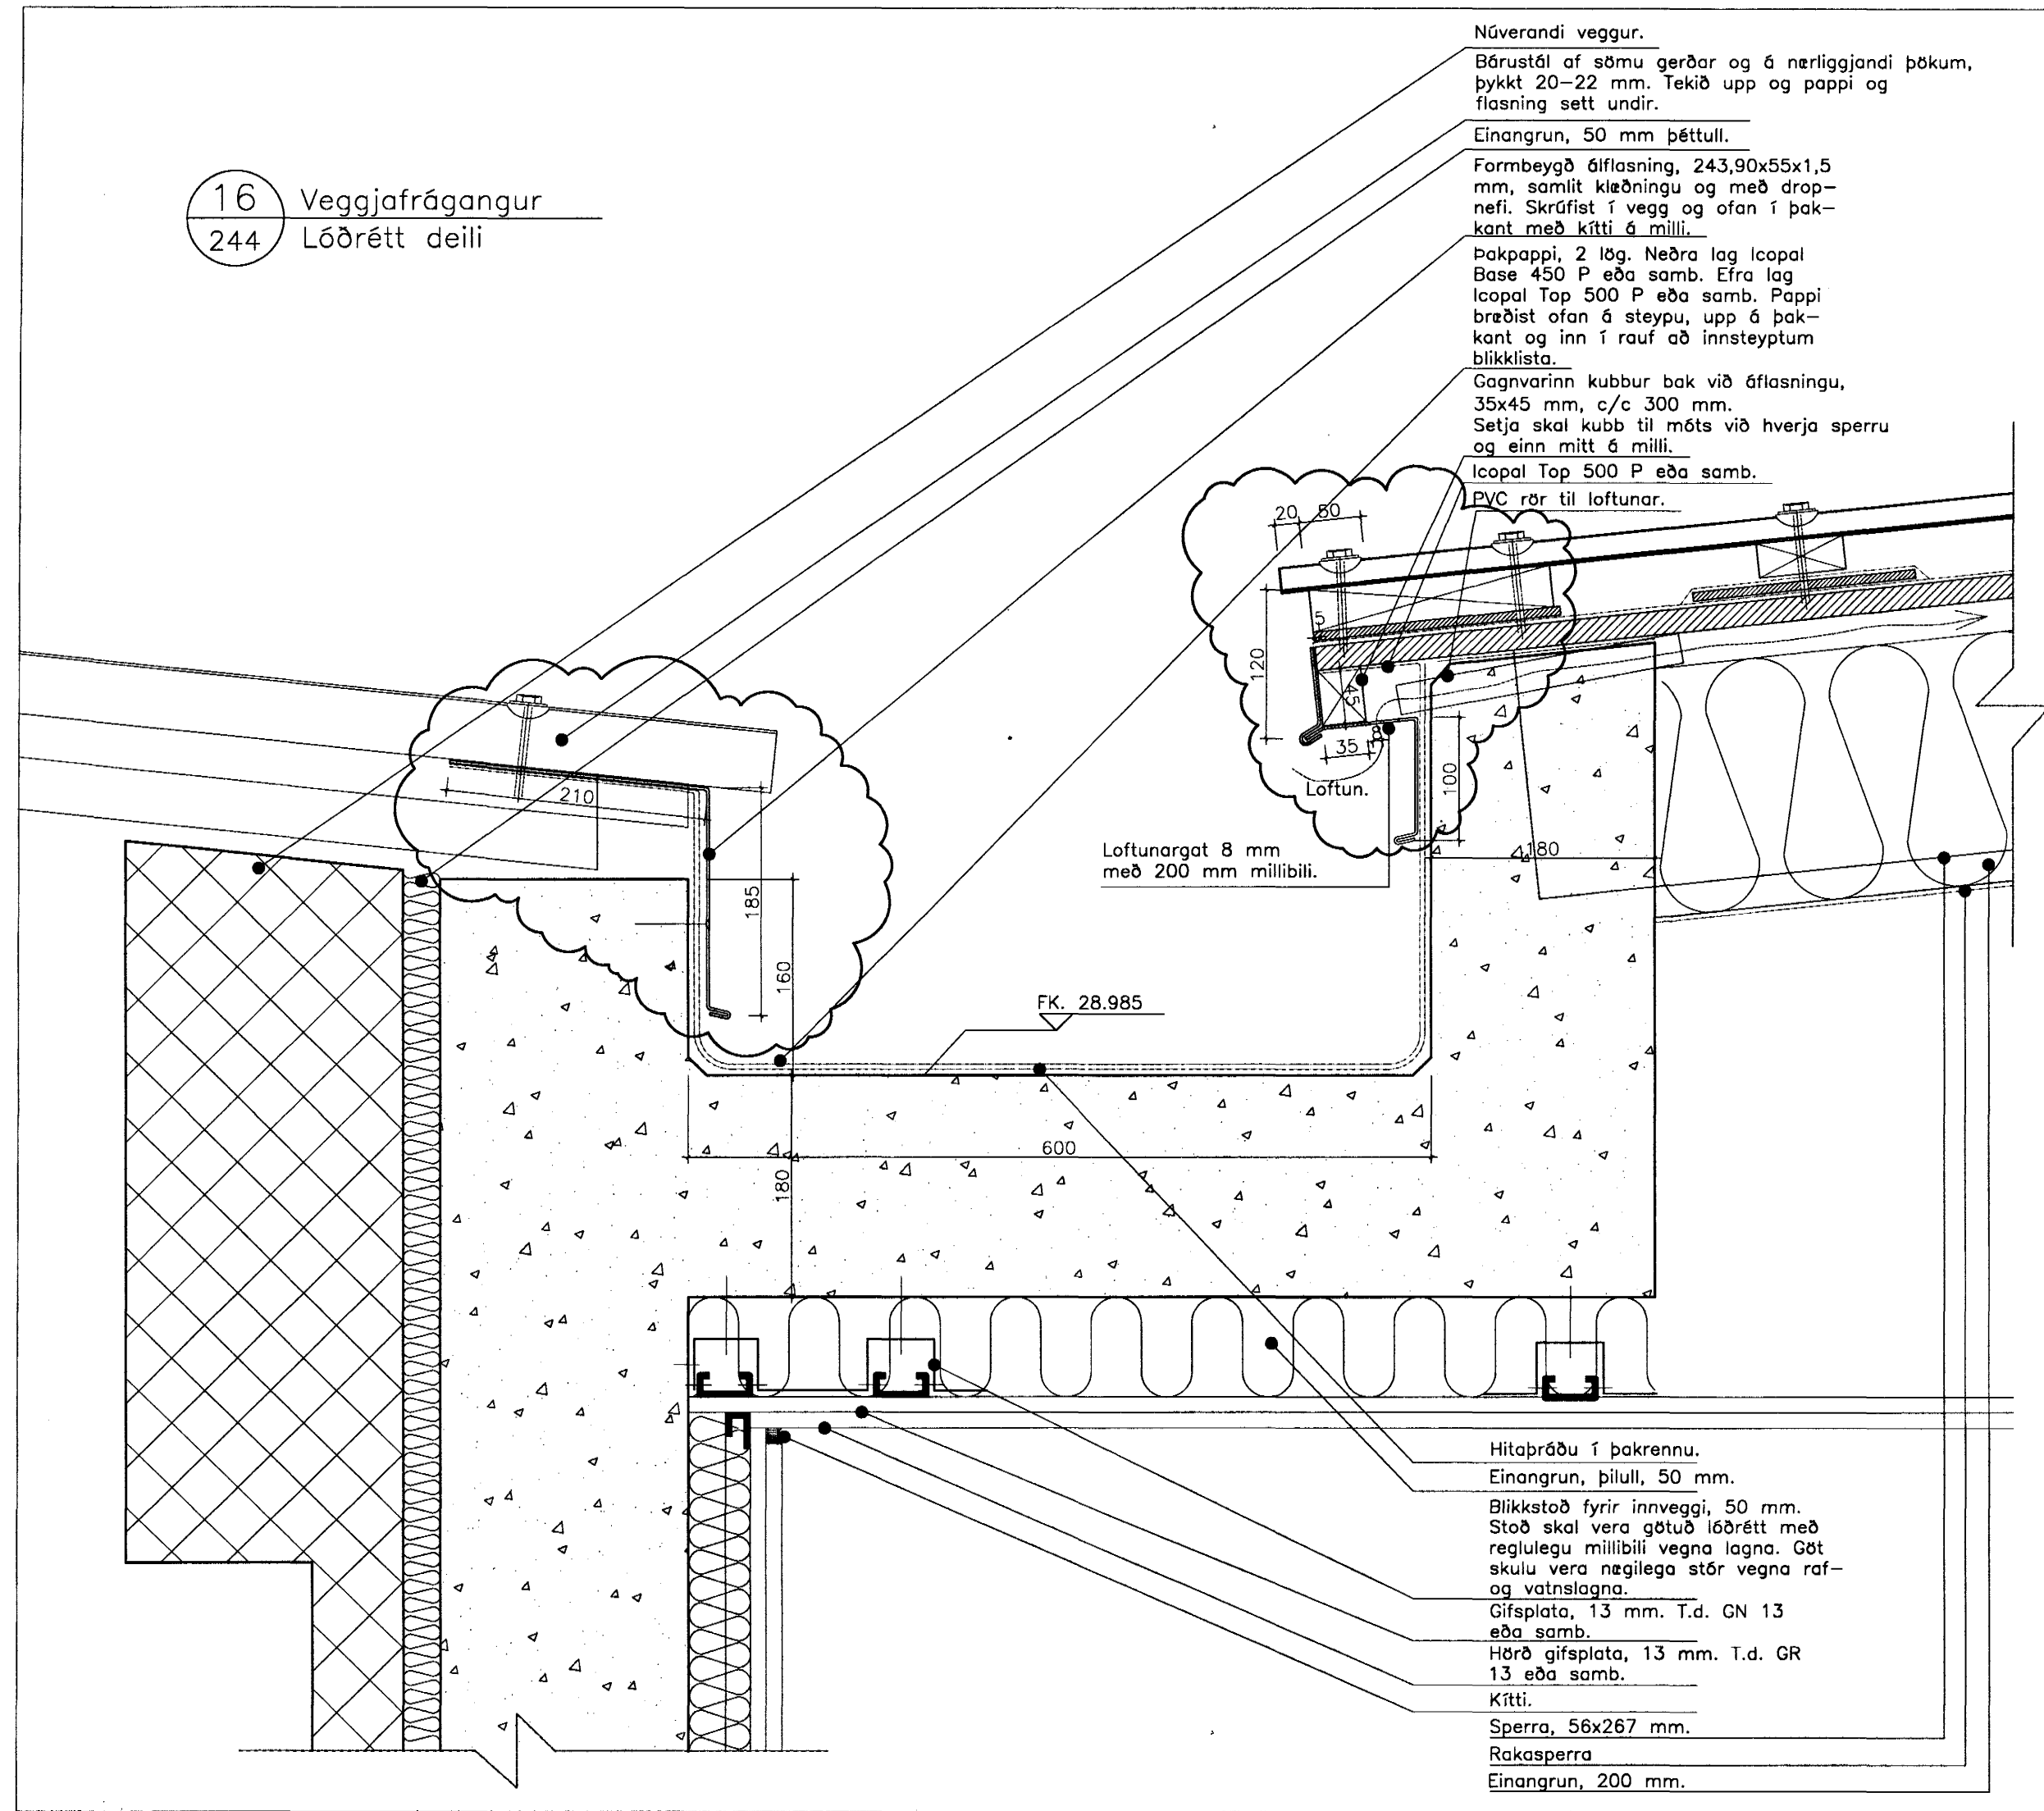

D
C:
B:
A: Sérhluti 16, sjó breytingarský. 25.01.2005
BREYTINGAR: DAGS:
LYKILMYND:
VERKKAUPI:
actavis
REYKJAVIKURVEGUR 78
BYGGINGARHLUTI: F-VERKSMIDJIA
MATSHLUTI: 223-1528 / 07
24 MAI 2005
VERKTEIKNING
LÓÐRÉTTIR SÉRHLUTAR 16, 20 og 21
VERK: DELT-0416 DAGS: 09.12.2004.
KVARDI: 1:5 TEIKNAD: pmm
SKRA: A-0308.dwg
ÚTI INNI
ARKITEKTAR
ÞINGHOLTSSTRÆTI 27 101 REYKJAVIK
SÍMAR 5527660 & 5627660 FAX 5527661
NETFANG ul@u.is
VEFFANG http://www.u.is
BALDUR Ó. SVAVARSSON ARKITEKTAR FAI
120357-5149
JÓN ÞÓR ÞORVALDSSON ARKITEKTAR FAI
021256-7579
TEIKNINGAR: A-F-0308 BREYTING: A