


E: Sjá breytingarský.	25.01.2005
D: Sjá breytingarský.	15.12.2004
C: Sjá breytingarský. / Yleiningar.	01.12.2004.
B: Sjá breytingarský.	19.11.2004.
A: Viðbætt deili 9, Sperrupak ofl.	15.11.2004.
BREYTINGAR:	DAGS:

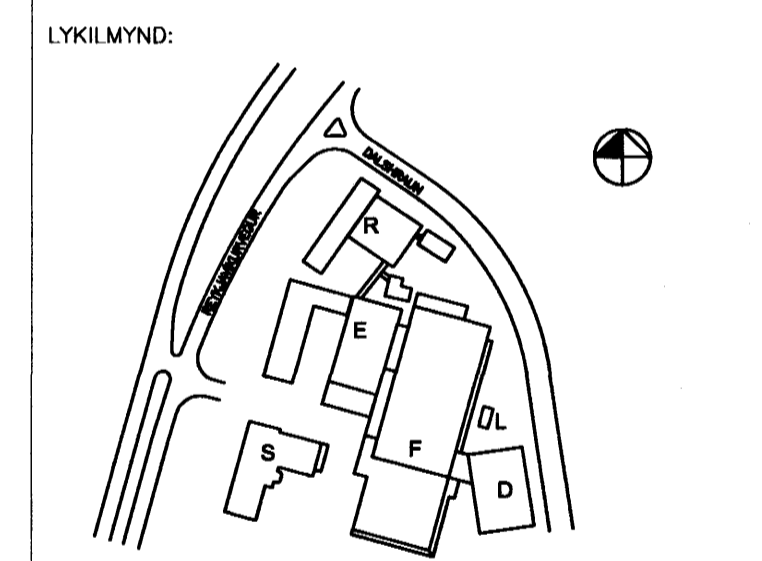

VERKKAUPI:

**actavis**

REYKJAVIKURVEGUR 78  
BYGGINGARHLUTI: F-VERKSMÍÐJA  
MATSHLUTI: 223-1528 / 07

Byggingafráttir Hafnarfjarðar  
Algreitt barn  
24 MAI 2005

VERKTEIKNING  
Löðréttir sérhlutar, 9-12.

VERK: DELT-0416 DAGS: 31.10.2004.  
KVARDI: 1:5 TEIKNAD: 09  
SKRA: A-0302.dwg

**ÚTI INNI**

**ARKITEKTAR**

ÞINGHOLTSTRETI 27 101 REYKJAVIK  
SÍMAR 5527660 & 5627660 FAX 5527661  
NETFANG u@ul.is  
VEFFANG http://www.ul.is

BALDUR Ó. SVAVARSSON ARKITEKTAR FAI  
120357-5149

JÓN ÞÓR ÞORVALDSSON ARKITEKTAR FAI  
021256-7579

TEIKNINGARN: **A-F-0302** BREYTING: **E**