


C: Sjá breytingarský. 25.01.2005.  
B: Sérmlutur 3 og 4 breyttir í sperrupak. 15.11.04  
BREYTINGAR: DAGS:

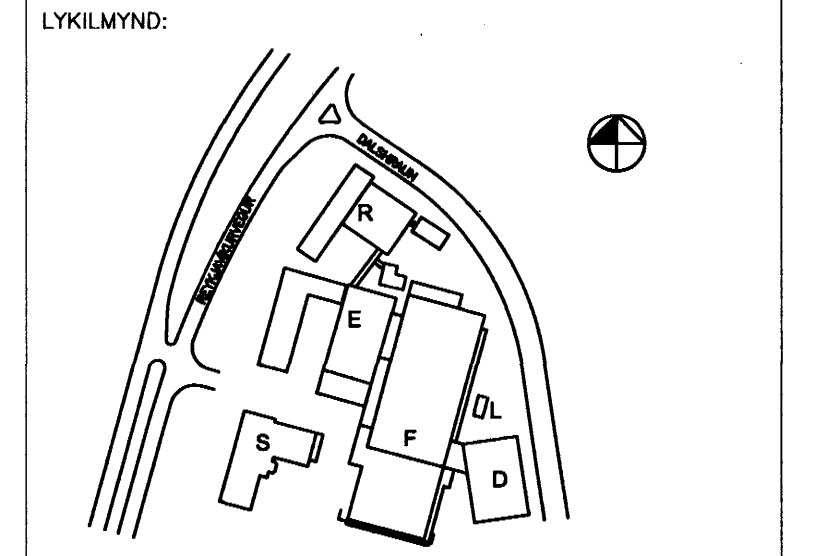

VERKKAUPI:  
**actavis**  
REYKJAVIKURVEGUR 78  
BYGGINGARHLUTI: F-VERKSMIDJA  
MATSHLUTI: 223-1528 / 07  
Byggingatillitni Hálfarflötur  
Algreitt þann  
24 MAI 2005

VERKTEIKNING  
Lóðréttir sérhlutur, 1-8  
VERK: DELT-0416 DAGS: 31.10.2004.  
KVARDI: 1:5 TEIKNAD: 08  
SKRÁ: A-0301.dwg

**UTI INNI**  
**ARKITEKTAR**  
ÞINGHOLTSTRÉTTI 27 101 REYKJAVIK  
SÍMAR 5527660 & 5627660 FAX 5527661  
NETFANG ui@ui.is  
VEFANG http://www.ui.is  
BALDUR Ó. SVARSSON ARKITEKTAR FAI  
120357-5148  
JON ÞÓR ÞORVALDSSON ARKITEKTAR FAI  
021256-7579  
TEIKNINGARN: **A-0301** BREYTING: **B**