

SKÝRINGAR:

- HK = Hrókköt.
- FK = Frögengin kóti.
- NB = Kóti í neðri brún.
- EB = Kóti í efri brún.
- NF = Niðurfall.
- BSL = Brunaslanga.


C:

B: Sjá breytingarský 03.11.2004.

A: Sjá breytingarský / Kótar. 30.09.2004.

BREYTINGAR: DAGS:


LYKILMYND:

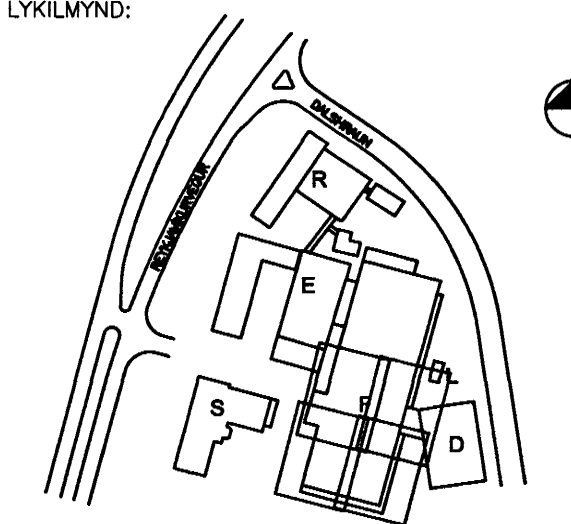

VERKKAUPI:



REYKJAVÍKURVEGUR 78
BYGGINGARHLUTI: F—VERKSMÍÐJA
MATSHLUTI: 223—1528 / 07

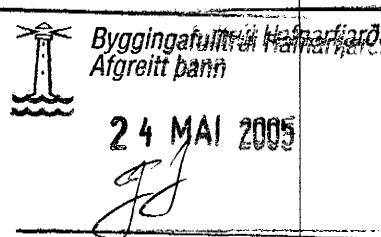

VERKTEIKNING
GRUNNMYND 2 HÆÐAR
MODUL 9—13 og D—H

VERK: DELT—0416 DAGS: 09.09.2004.
KVARDI: 1:50 TEIKNAD: PMM
SKRA: A—F—0214.dwg

ÚTI INNI

ARKITEKTAR

ÞINGHOLTSSTRÆTI 27 101 REYKJAVÍK
SÍMAR 5527660 & 5627660 FAX 5527661
NETFANG ui@ui.is
VEFFANG http://www.ui.is

BALDUR Ó. SVAVARSSON ARKITEKTAR FAI
120357—5149

JÓN ÞÓR ÞORVALDSSON ARKITEKTAR FAI

021256—7579

TEIKNINGANR: A-F-0214 BREYTING: B