



SKÝRINGAR:

- HK = Hrákkti.
- FK = Frégengin kfti.
- NB = Kéti í neðri brún.
- EB = Kéti í efri brún.
- NF = Niðurfali.
- BSL = Brunaslanga.

C:

B:


A: Sjá breytingarský.

15.11.2004.

BREYTINGAR:

DAGS:


LYKILMYND:

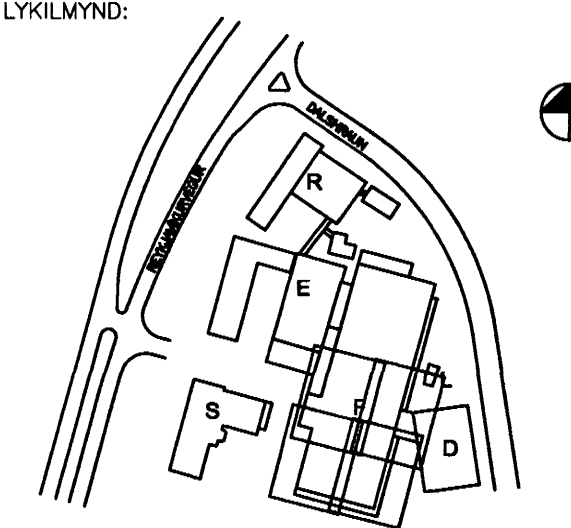

VERKKAUPI:



REYKJAVIKURVEGUR 78
 BYGGINGARHLUTI: F-VERKSMÍÐJA
 MATSHLUTI: 223-1528 / 07

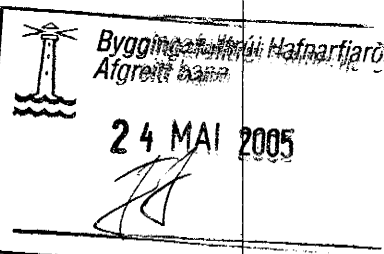

VERKTEIKNING
 GRUNNMYND 2 HÆÐAR
 MODUL 12-16 og A-Da

VERK: DELT-0416 DAGS: 09.09.2004.
 KVARDI: 1:50 TEIKNAD: PMM
 SKRÁ: A-F-0212.dwg

ÚTI INNI

ARKITEKTAR

HINGHOLTSSTRÆTI 27 101 REYKJAVÍK
 Símar 5527660 & 5627661 Fax 5527661
 Netfang: u@u.li.is
 Veffang: http://www.u.li.is

BALDUR Ó. SVARSSON ARKITEKTAR FAI
 120357-5149

JÓN ÞÓR ÞORVALDSSON ARKITEKTAR FAI
 021256-7579

TEIKNINGANR: **A-F-0212**

BREYTING: **A**