


Hönnuður:
Gunnar Sverrisson

Yfirfarir:
Sambýkkt *D. S. Sverrisson* kt. 100356-3339

Breytingar:
17.01.2005 Ýmsar breytingar

Fjölbýlishús
Herjólfsgata 36
220 Hafnarfjörður

Brunaviðvörunarkerfi
3 hæð
Mkv: 1:50

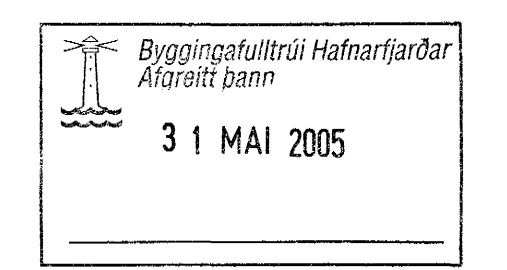

RTS
VERKFRÆÐISTOFA
Grensasvegur 3
108 Reykjavík
Sími 520 9900
Fax 520 9901
www.rts.is



83-1535-1- 033401 B1
27.05.2004

