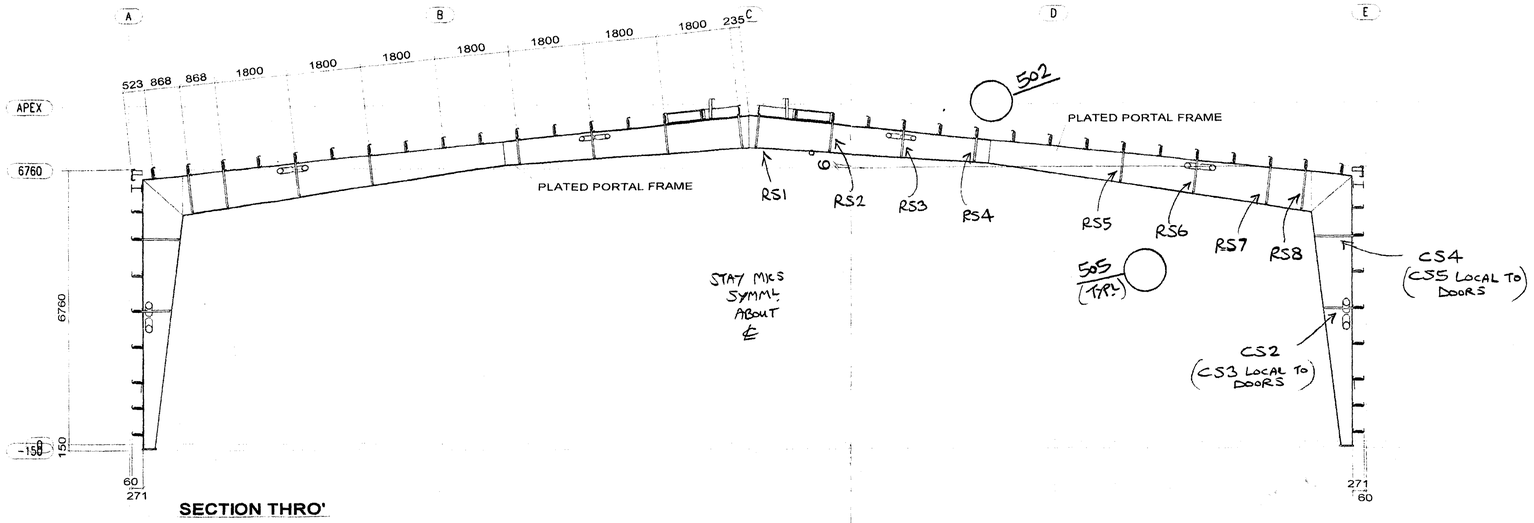

SECTION THRO'

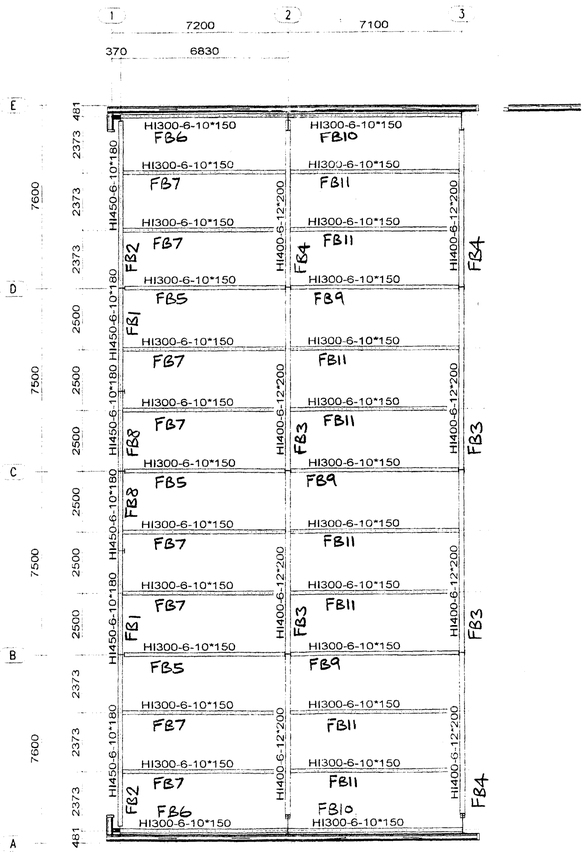

FLOOR PLAN +3370 T O S

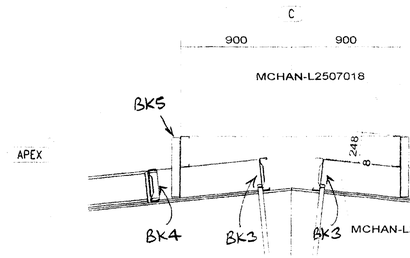

ROOF LIGHT SUPPORTS

MARKING PLAN ONLY

Verkfræðistofa
Hauks Ásgeirssonar ehf.
Dalvegi 18, 201 Kópavogur

REV	DATE	DESCRIPTION
B	4/8/04	MARKS ADDED
A	2/7/04	UPDATED

WARD
ATLAS BUILDING SYSTEMS LTD
SHERBURN, MALTON
NORTH YORKSHIRE YO17 8PZ
ENGLAND
TEL.(01944)710000 FAX:(01944)710907

Byggingafulltrúi Hafnarfjarðar
Afgreitt þann
09 JÚNÍ 2005

PROJECT: STEINHELLA 10		SCALE: 1/125	FAB SYM:
		QUOTE No/PROJECT No:	
DRAWING TITLE: FLOOR PLAN & SECTION		CONTRACT NO: 04001	
DRAWN: BR	DATE: 10.07.2004	CHKD:	DATE:
DRAWING No: (4) 6		REVISION: A B	