
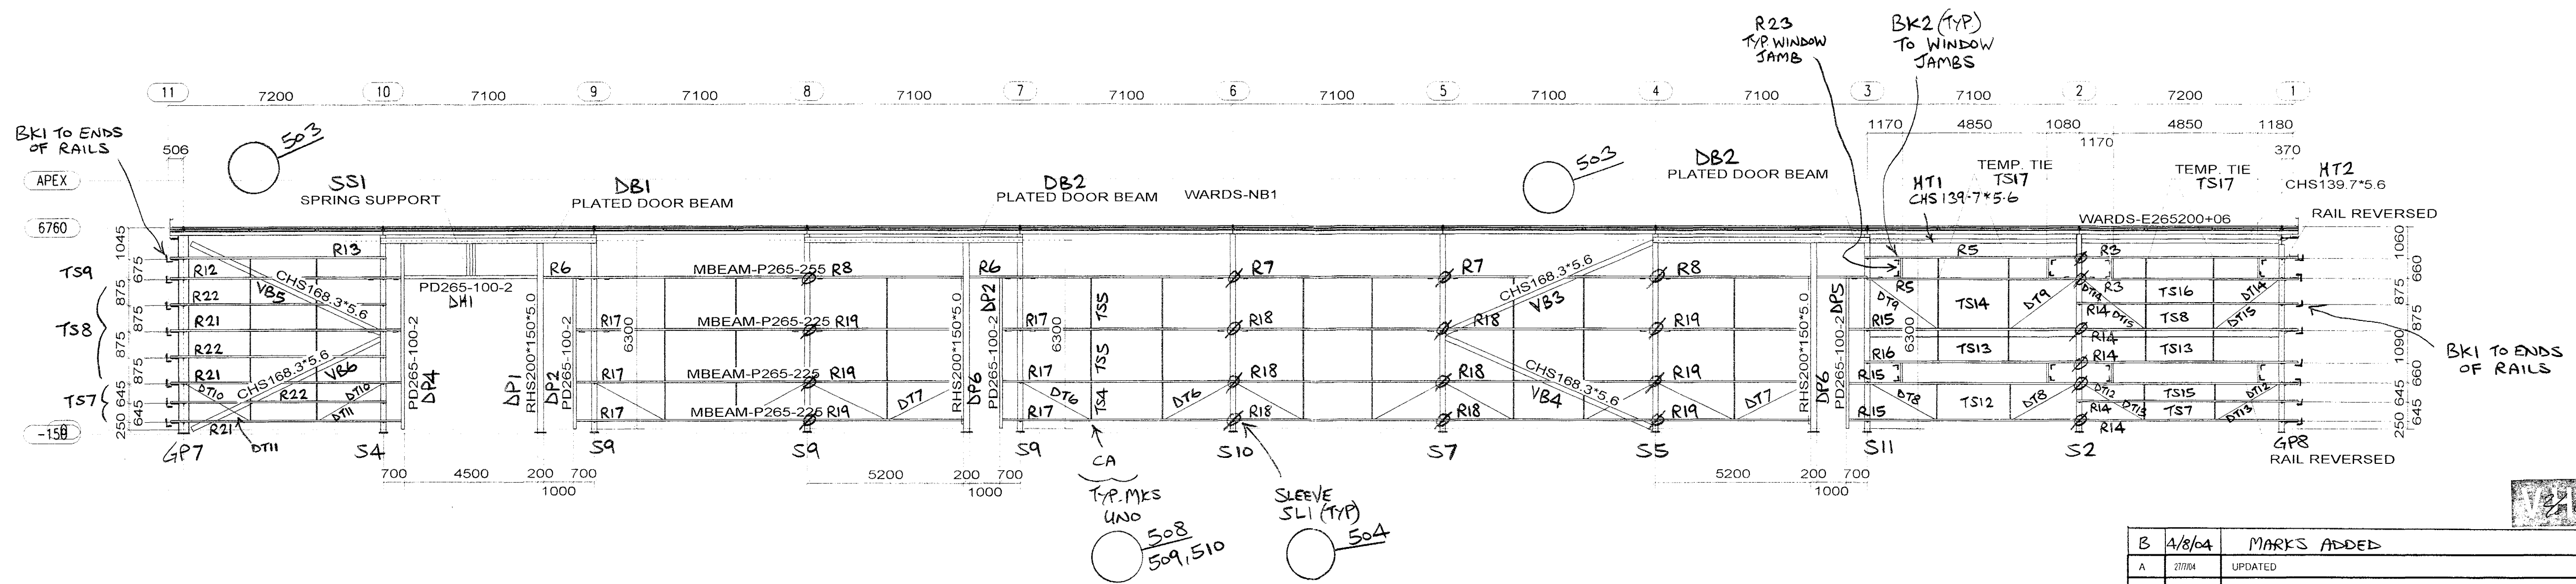


LINE A

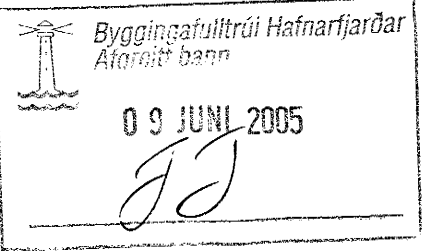

LINE E

MARKING PLAN ONLY

B	A/8/04	MARKS ADDED
A	2/004	UPDATED
REV	DATE	DESCRIPTION
WARD		 09 JUNI 2005 <i>JJ</i>
ATLAS BUILDING SYSTEMS LTD		
SHERBURN, MALTON NORTH YORKSHIRE, YO17 8PZ, ENGLAND TEL: (01944) 710000 FAX: (01944) 710907		
PROJECT STEINHELLA 10		SCALE 1/125
		FAB SYM
		QUOTE No/PROJECT No
DRAWING TITLE SIDE ELEVATIONS		CONTRACT NO 04001
DRAWN BR	DATE 10.07.2004	CHKD
DATE	DATE	DRAWING No
		4
		REVISION AB