Format A1 (841x594 mm) is 20 mm outside of this frame

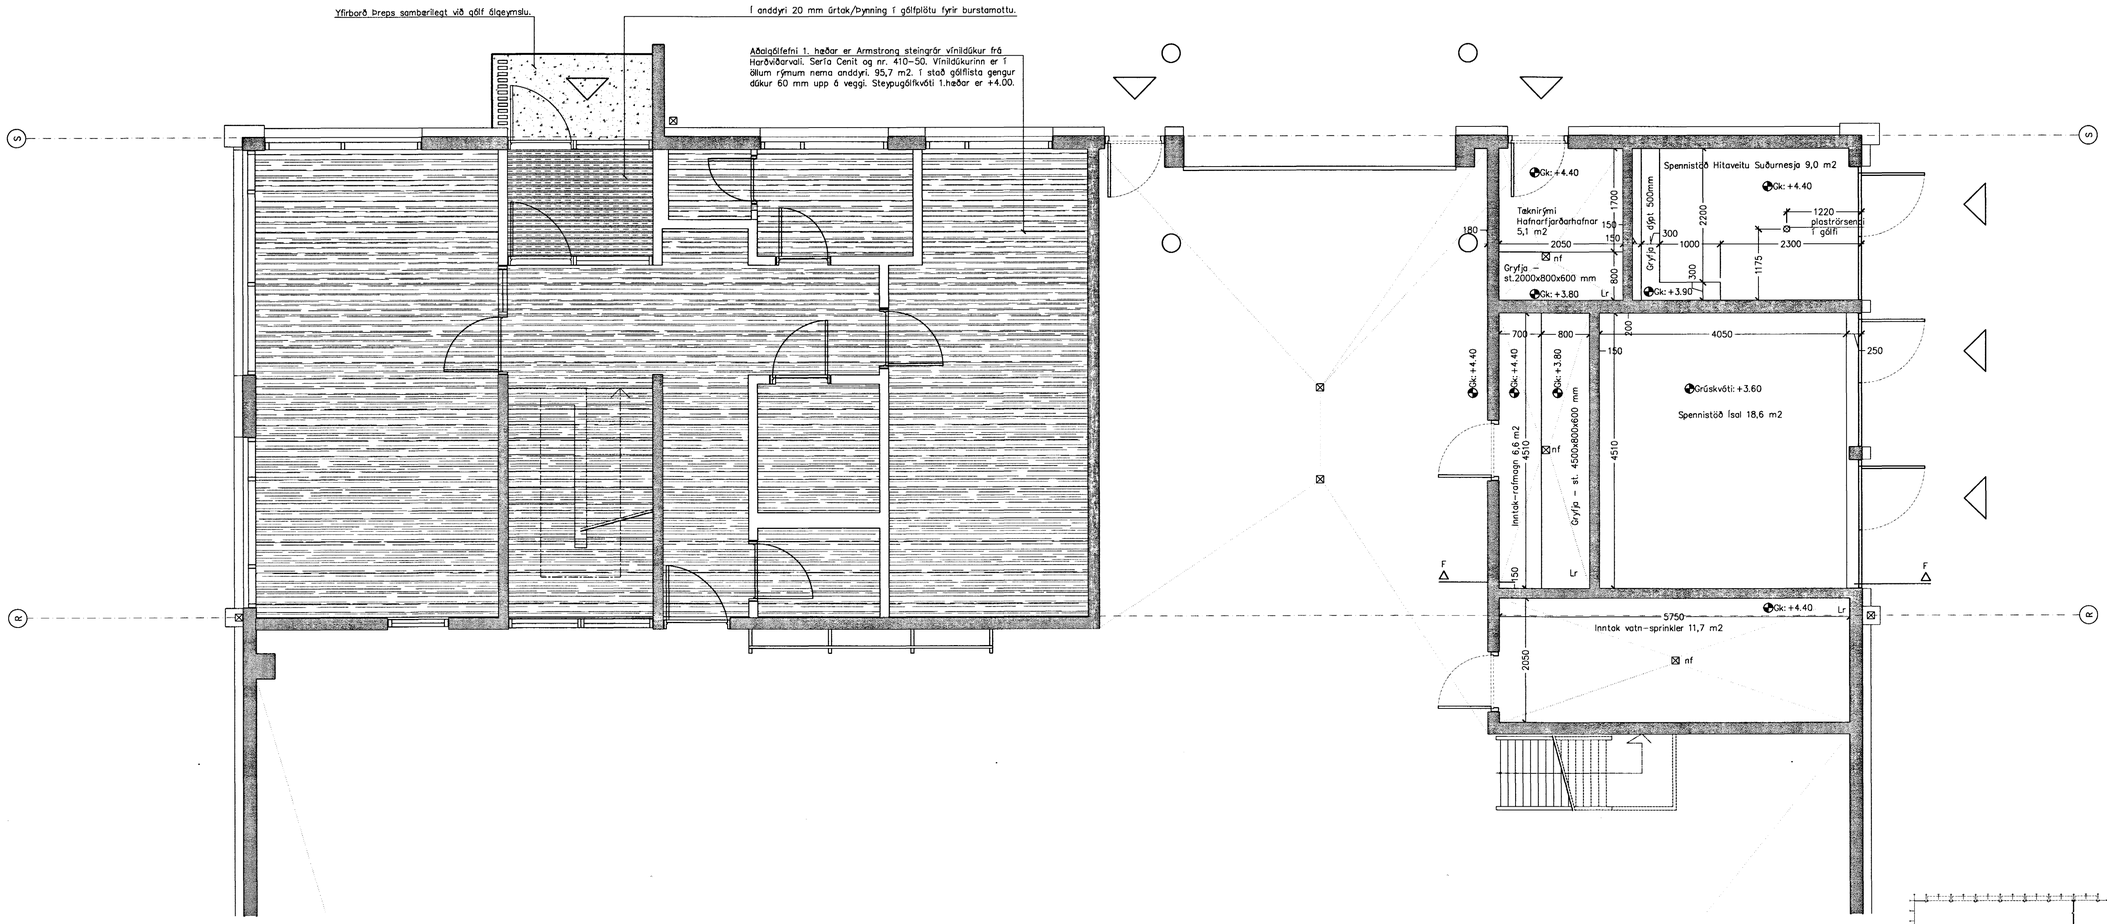

Gólfefnayfirlit 1.hæðar – mkv. 1: 50

Byggingafulltrúi Hafnarfjarðar
Afgreitt þann
14 JUNI 2005

Skýringar:
Explanations:

ARK ÍS ehf
arkitektar ráðgjafar

Aðalsteinn Snorrason arkitekt faí 161161-2769
Egill Guðmundsson arkitekt faí 270152-6869
Gísli Gíslason arkitekt faí 160657-4809
Skólavörðustíg 11 101 reykjavík
sími 511 2060
fax 511 2066
netfang arks@ark.is

Breyt. Rev.	Breyting Revision	Dags. Date	Samþ. Approved	Notk. heimil Released
A	Reyndarteikning	08.06.05	hi	
2	Tilferslur í málsetningum.	28.01.04	ms	
1	Kótum breitt	09.12.03	hk	

Tilv.teikningar nr. ISAL / Ref.drawing no. of ISAL
Samsetn.teikningar nr. ISAL / Assembly drawing no. of ISAL

This drawing is the property of the Alcan Iceland Ltd. and handed out for personal use only. It may neither be copied nor made available to others without permission of the Alcan Iceland Ltd. The receiver is liable for any misuse.

Fjöldi stykkja / Number of pieces: IV III II I

Hlutur / Object	Atriði / Item	Efni / Material	ea.:stk / Weight	total: í heild (kg) / Dynad	Athugasemdir / Remarks

Mhl.01 Víkurgata 7 / ál–og tækjageymsla
Gólfefnayfirlit og gryfjur
starfsmannarýma á 1.hæð. Grunnmynd

Stærð / Format: A1 — Mkv. / Scale: 1: 50
Kostn.nr.–bún.nr. / CCno.–Eq.no.: 7510 12094
AKS no.: US33
Verktaki / Supplier: ARKÍS ehf
Teikn.nr. verktaka / Drw.no. of suppl.: (43)3.01 — Breyt./Rev.: A
Teiknað / Drawn: gg jg ms ee 26.09.03 — Yfirfarið / Checked: as — Samþykkt / Approved: as

ALCAN PRIMARY METAL EUROPE
ISAL — Alcan Iceland Ltd — Straumsvík — IS-222 Hafnarfjörður — ALCAN
Drw.no. of ISAL / Teikn.nr. ISAL: 168523 — Breyt./Rev.: A
Teiknað / Drawn — Yfirfarið og skráð / Checked and filed — Notkun heimiluð / Released