


C:
 B:
 A: Gluggi G12 fjarlægður, niðurföll 6 svölum. 14.02.05
 BREYTINGAR: DAGS:

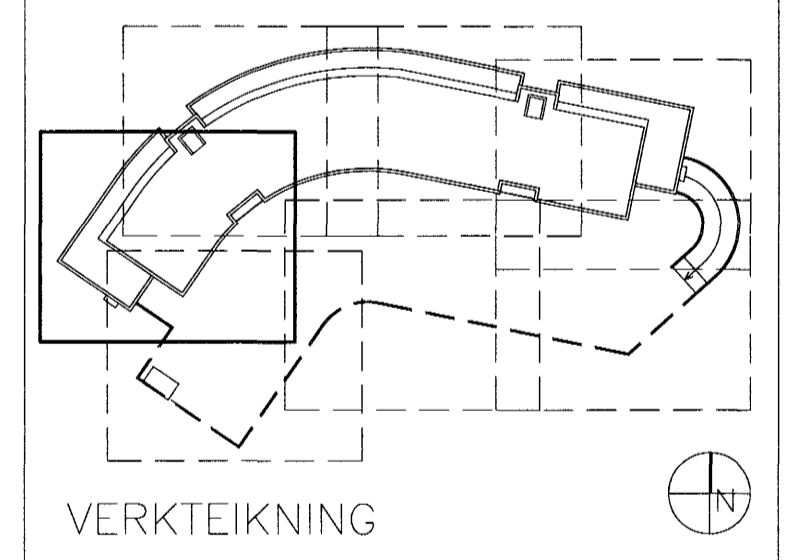

Dalshraun 1, Hafnarfirði
 RIS ehf
 VERK: DALS 0406
 KVARDI: 1:50
 DAGS: 03.12.04
 GRUNNMYND 5. HÆÐAR TEIKN: 0B
 BLAD 1 AF 4 SKRÁ: 0406-grunnur-SH.dwg

ÚTI INNI

ARKITEKTAR
 23 FEB. 2005
 Þinghóltsstráti 27 101 REYKJAVÍK
 Símar 5527660 & 5627660 FAX 5527661
 Netfang: netfang@uti.is
 Veffang: <http://www.uti.is>
 Baldur Ó. Svavarsson ARKITEKTAR FAI
 120357-5149
 Jón Þór Þorvaldsson ARKITEKTAR FAI
 021256-7579

Sampylur þann
 23 FEB. 2005
 Byggingaráhráðgjafi
 E. Sigurðar Halldórsson
A
229