


C:
 B:
 A: Gluggi G12 fjarlægður, niðurfalið 6 svölum. 14.02.05
 BREYTINGAR: DAGS:

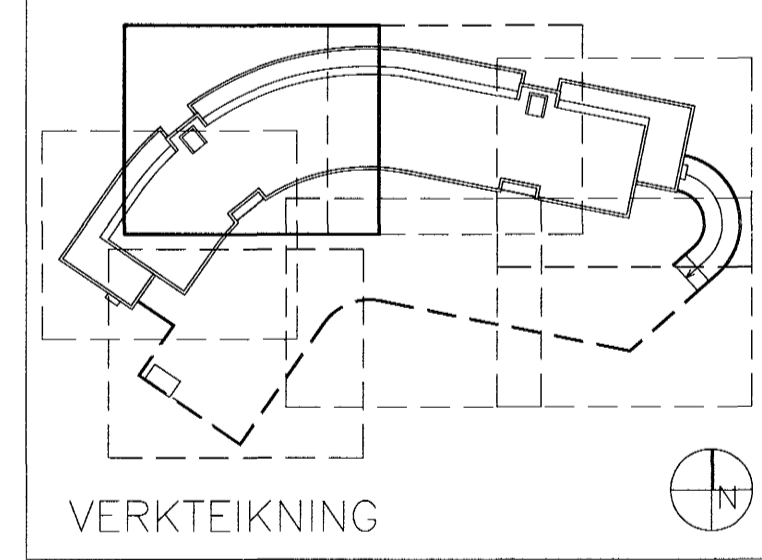

Dalshraun 1, Hafnarfirði
 RIS ehf
 GRUNNMYND 5. HÆÐAR
 BLAD 2 AF 4

VERK: DALS 0406
 KVARDI: 1:50
 DAGS: 03.12.04
 TEIKN: 0B
 SKRÁ: 0406-grunnur-0H.dwg

ÚTI INNI

ARKITEKTAR Samþykkt bann
 BINGHOLTSSTRÆTI 27 101 REYKJAHÖL
 SIMAR 5527660 & 5627660 FAX 5527661
 NETFANG: g@bui.is
 VEFANG: http://www.bui.is
 BALDUR Ó. SVAVARSSON ARKITEKTAR FAI
 120357-5149
 JÓN ÞÓR ÞÓRVALDSSON ARKITEKTAR FAI
 021256-7579

23. FEB. 2005
 Byggingarmyndun í Hafnarfirði
 E.h. Guðbjartur Halldórsson

A
230