




A-1
2 stk.

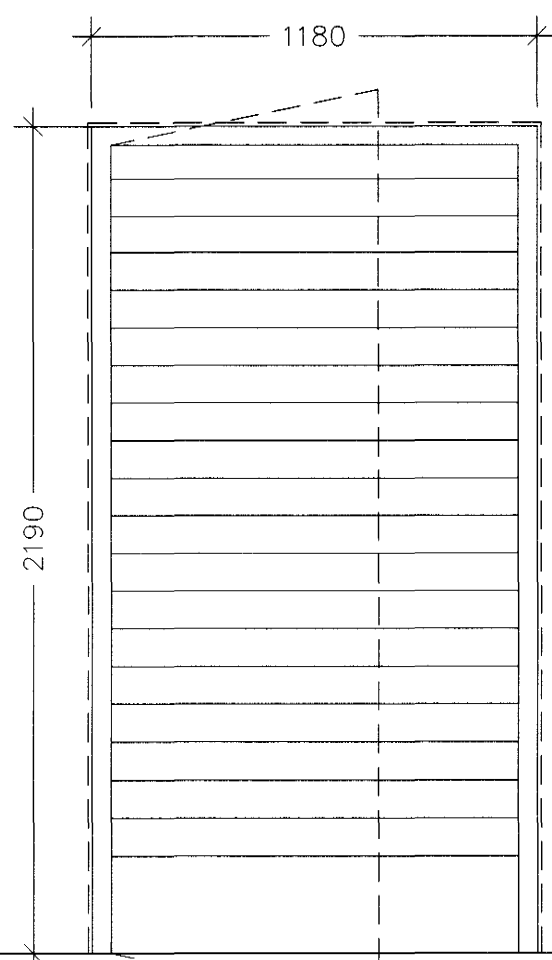


A-2
1 stk.

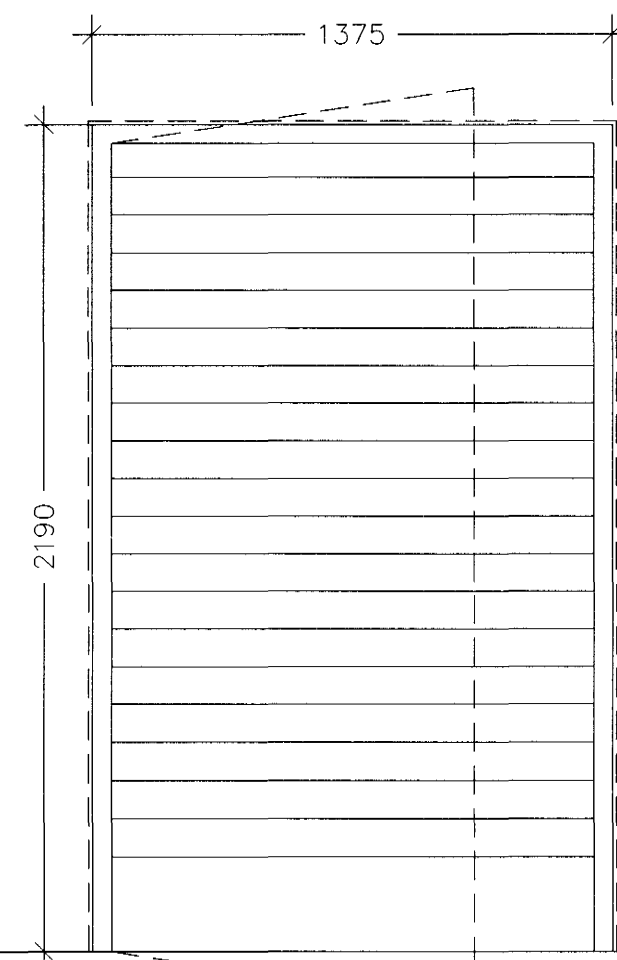

A-3
1 stk.

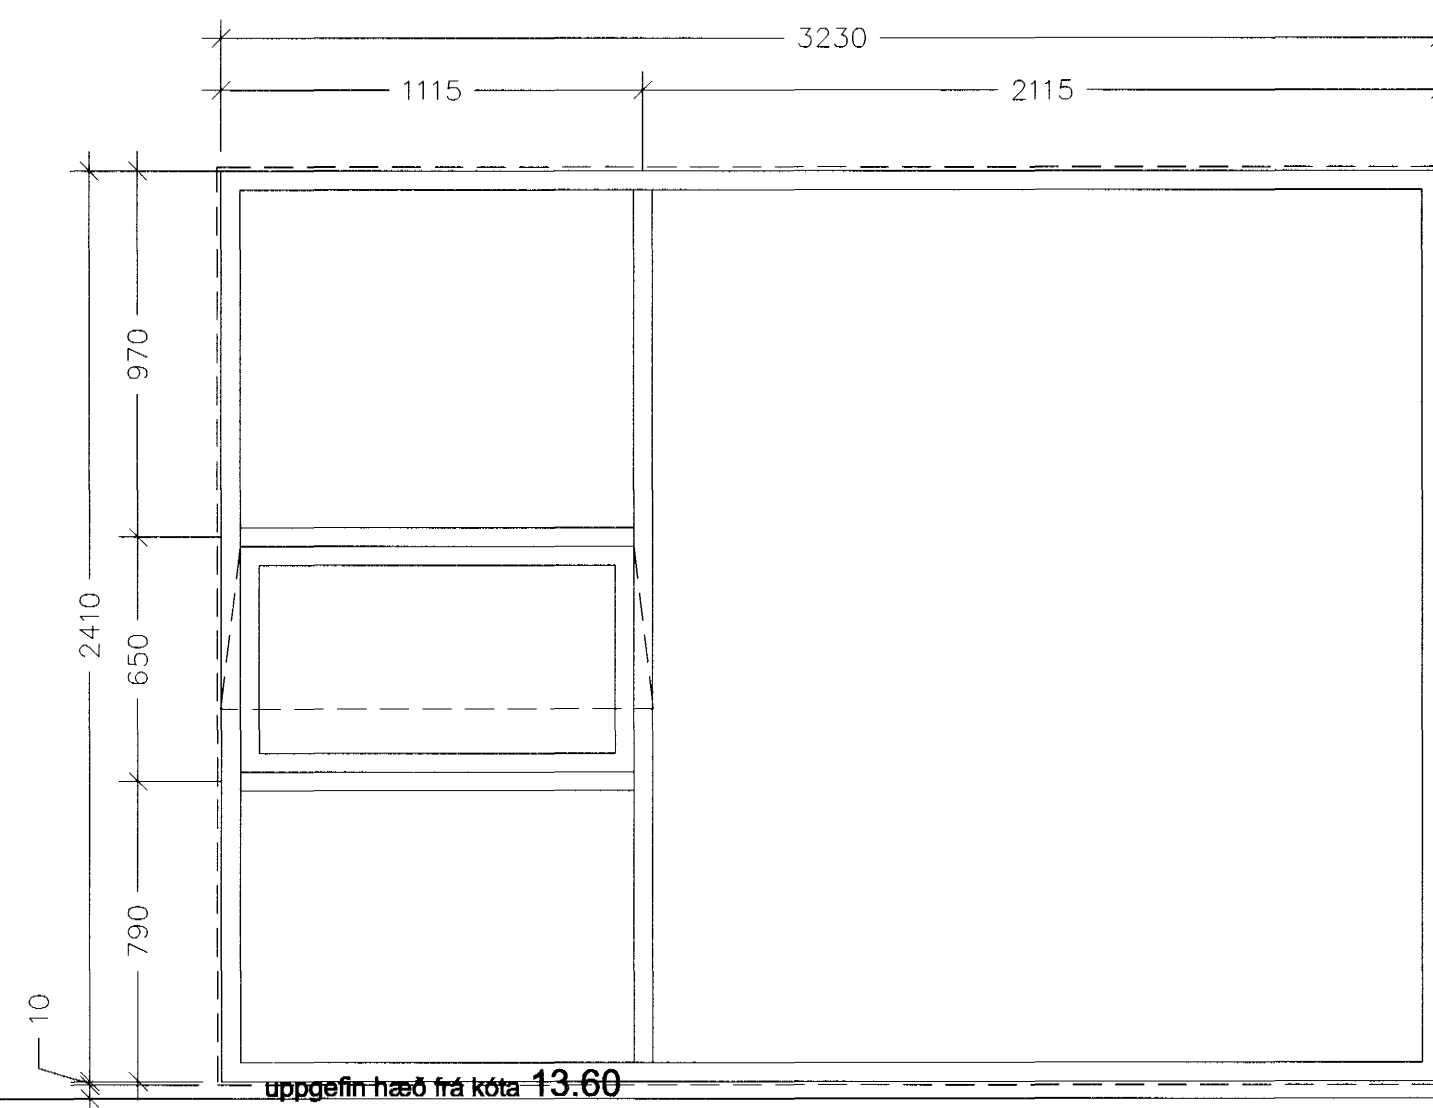


B-1
1 stk.

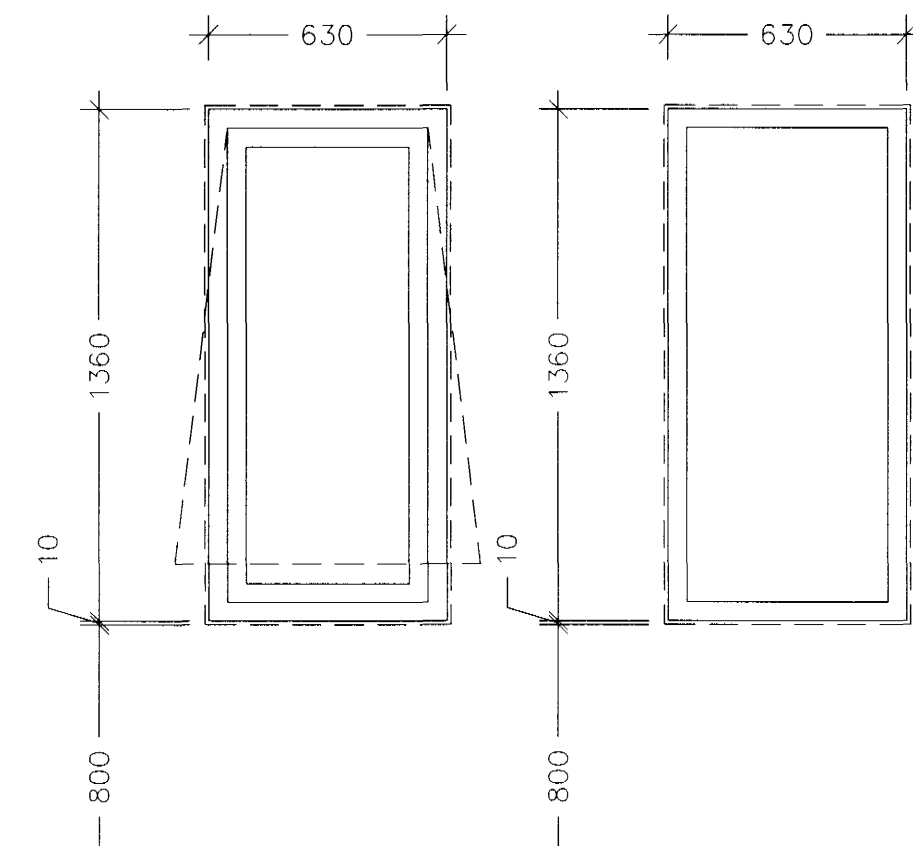


E-1
9 stk.

E-2
2 stk.

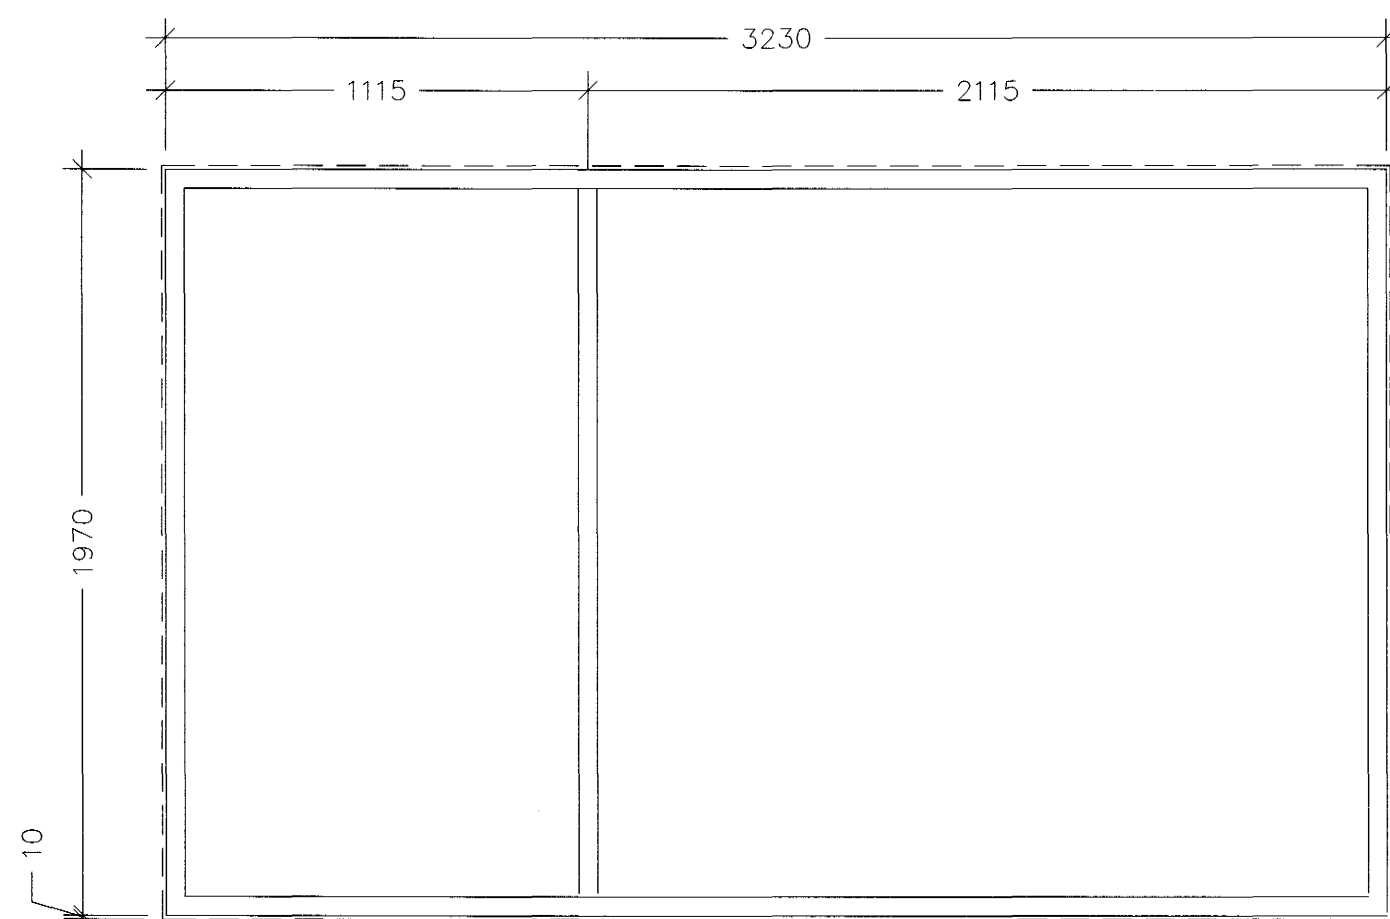


B-2
1 stk.

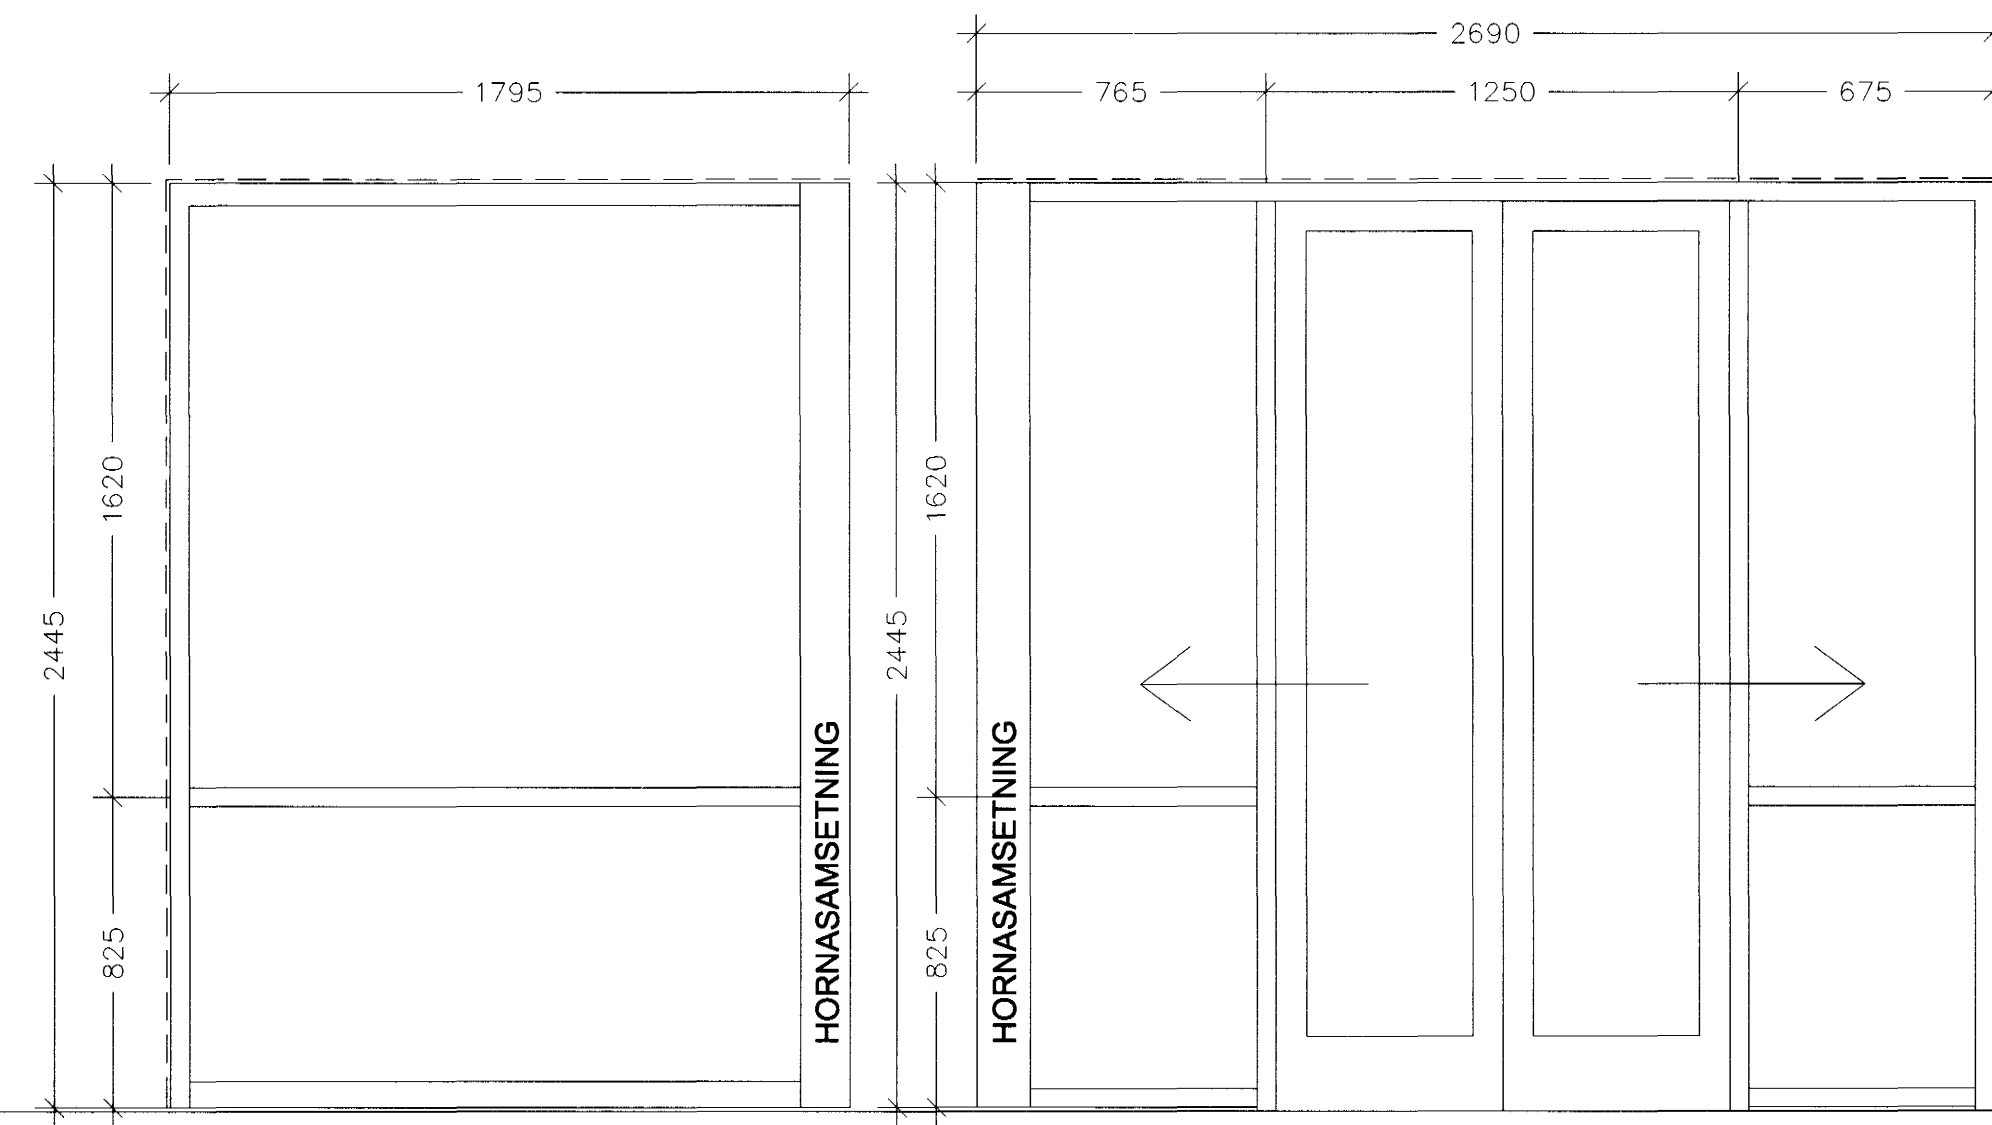


C-1
1 stk.


C-2
1 stk.

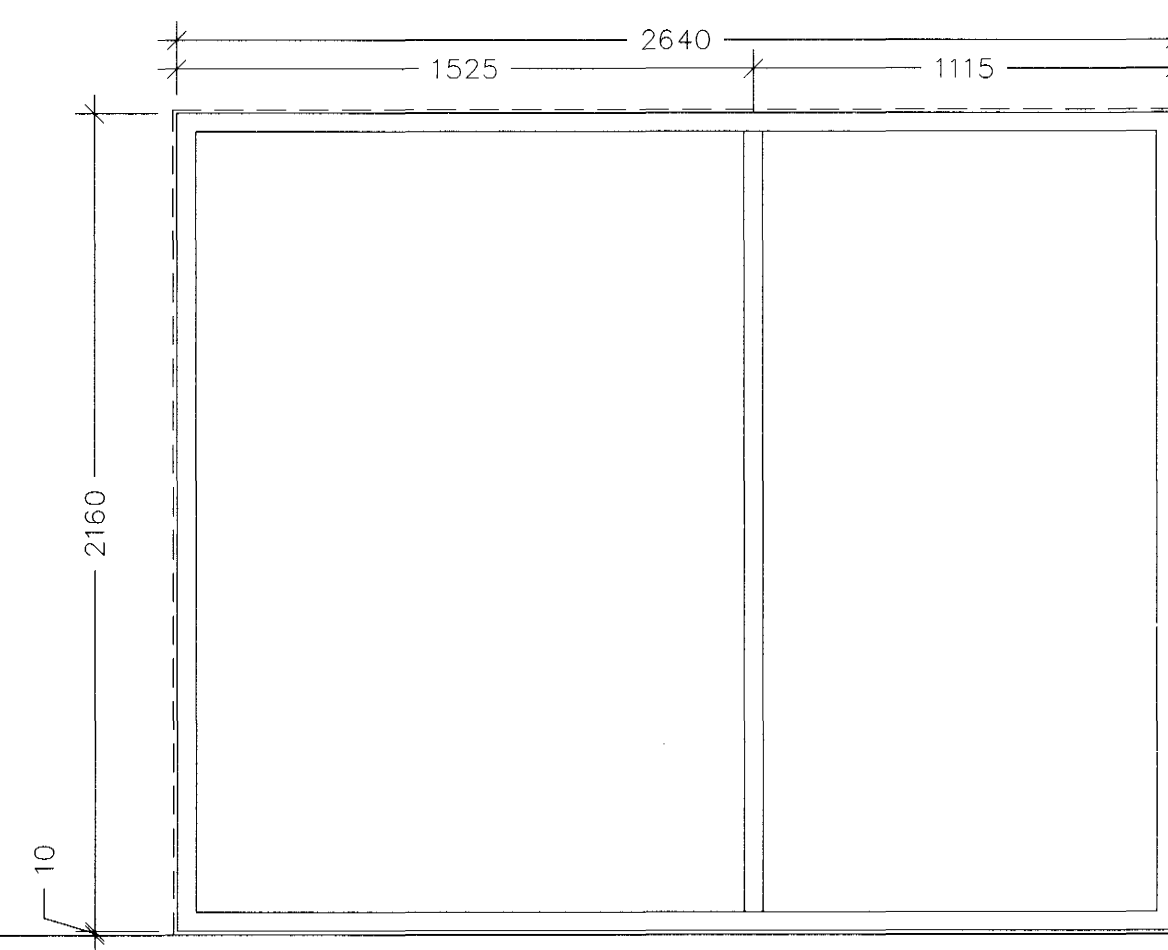


F-1
1 stk.

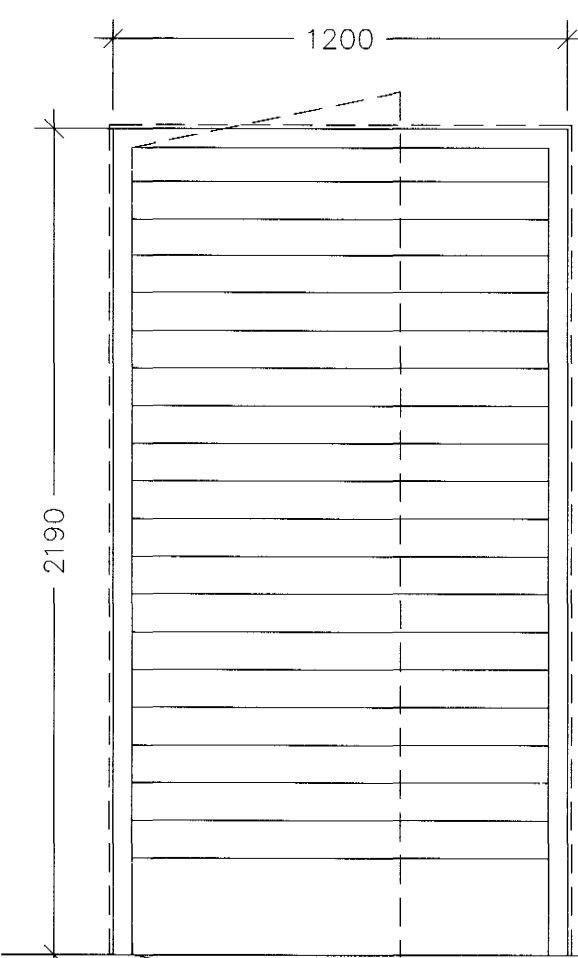

A-4
1 stk.

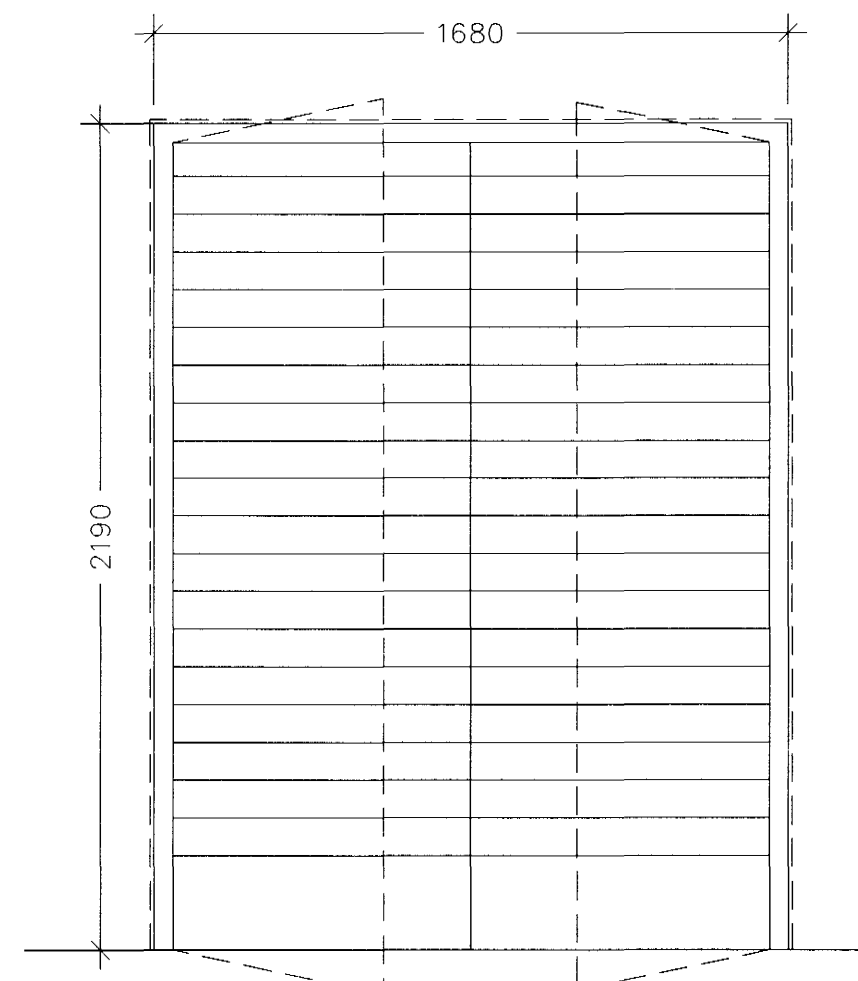


G-1
1 stk.

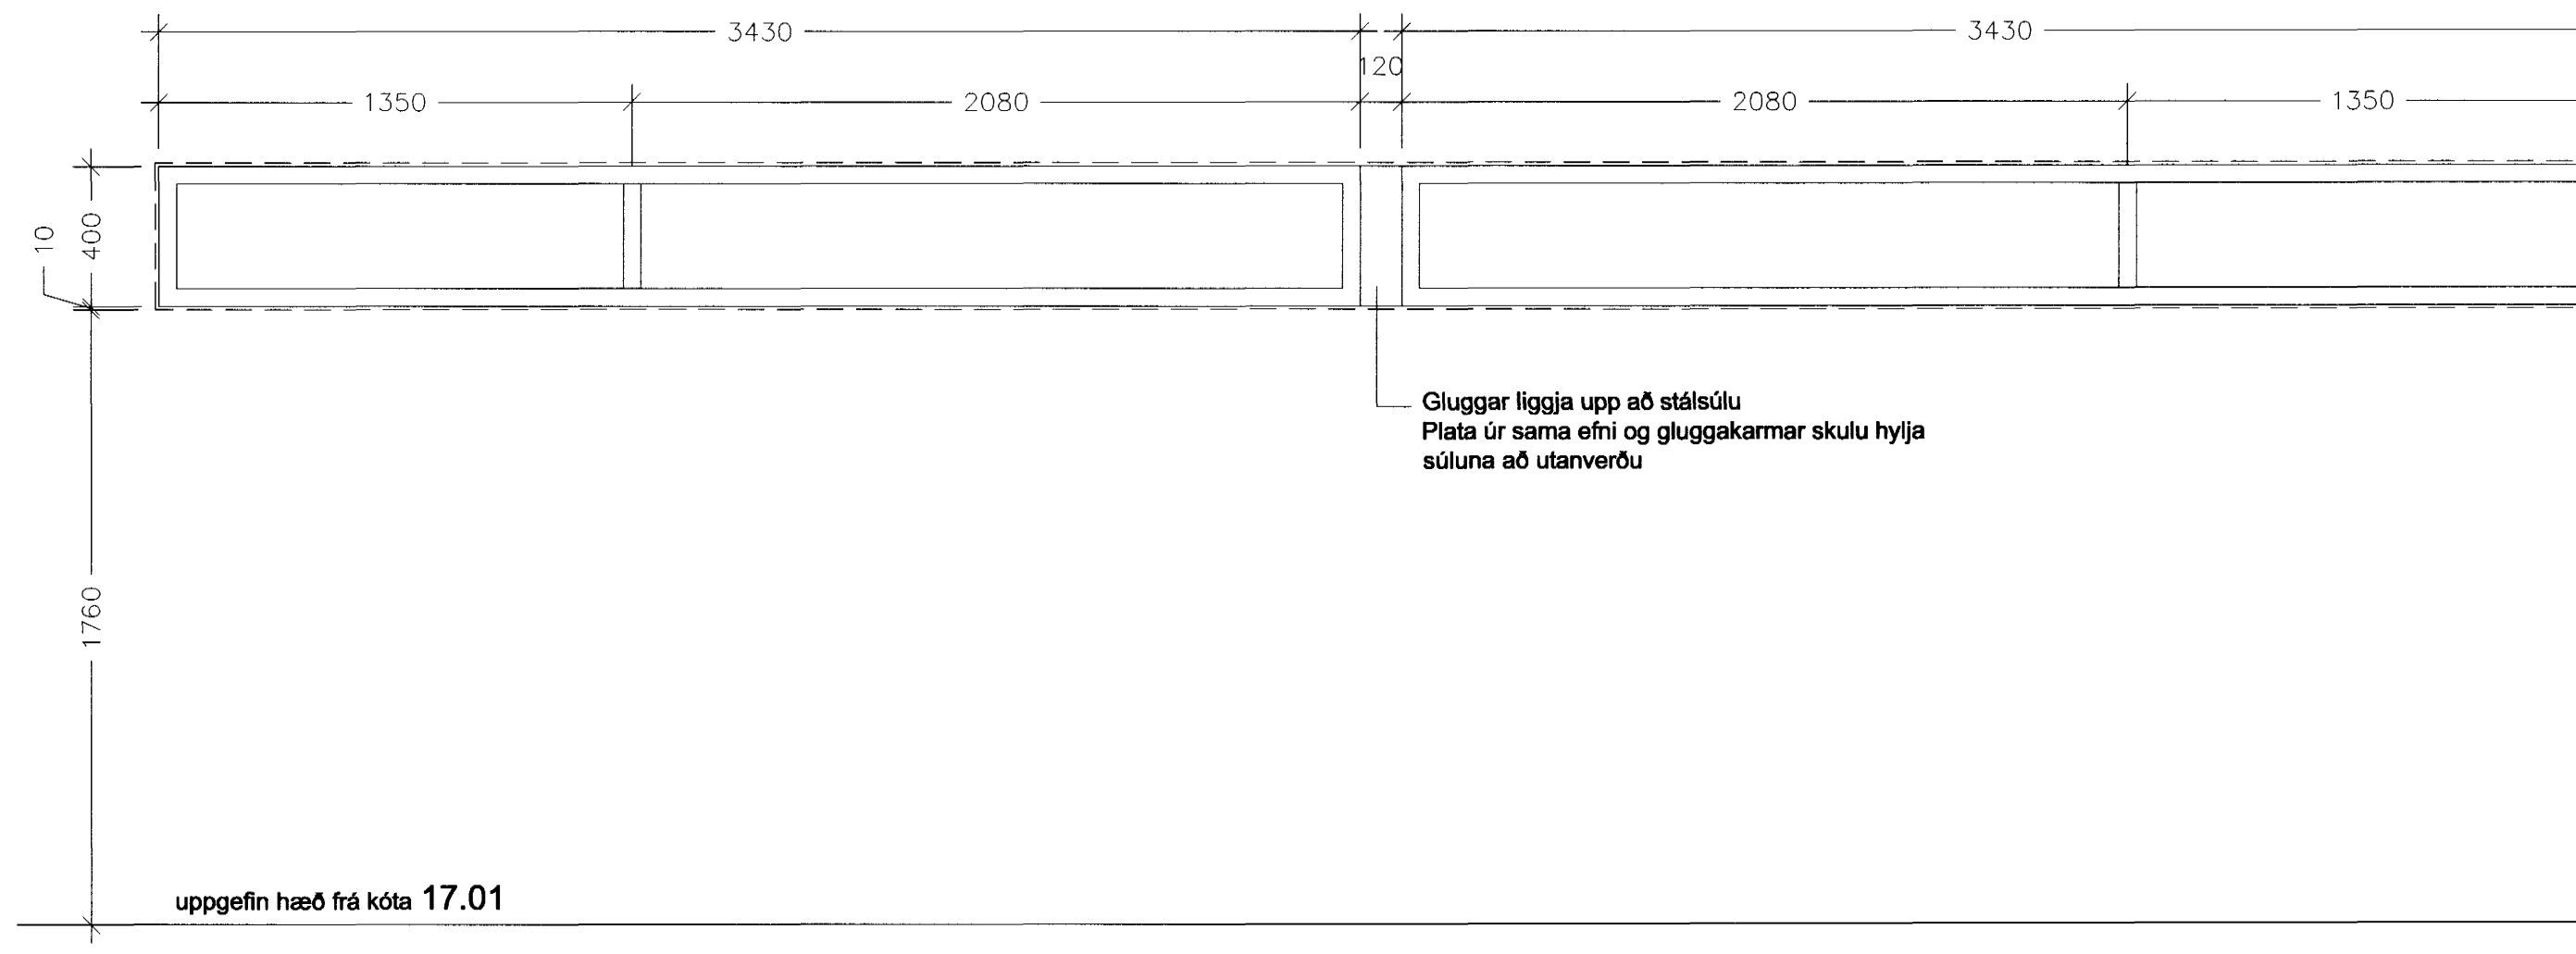

H-1
1 stk.

Sigríður Ólafsdóttir 071070-7069

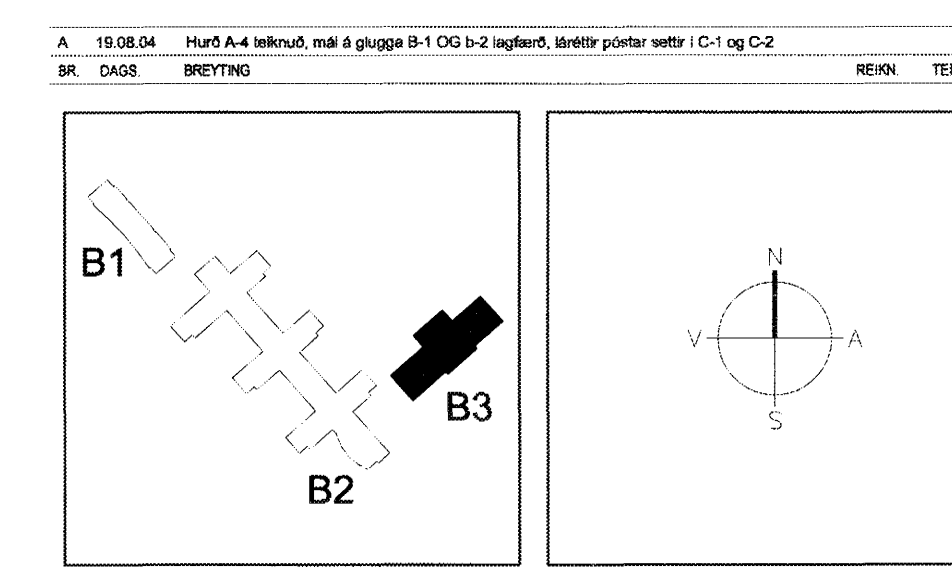

Á STOFUNNI
ARKITEKTAR

FINNUR BJÖRGVINSSON
HILMAR ÞÓR BJÖRNSSON
SIGRÍÐUR ÓLAFSDÓTTIR

LANDMÖTUN
VSD

SÖLVANGSVEGUR 4
LÆKJARSKÓLI - ÍPRÓTTAHÚSNÆÐI

GLUGGAYFIRLIT	HANNAÞEKN.	SD
	ATH.	
	SAMÞYKKT	
	KT.	06059-1399
	REYKJAVÍK	09.07.2004
KVARNR. 1:20	TEIKN. NR.	
VERÐNR.		
04-25	A-VD-001	A