



SNID F-F

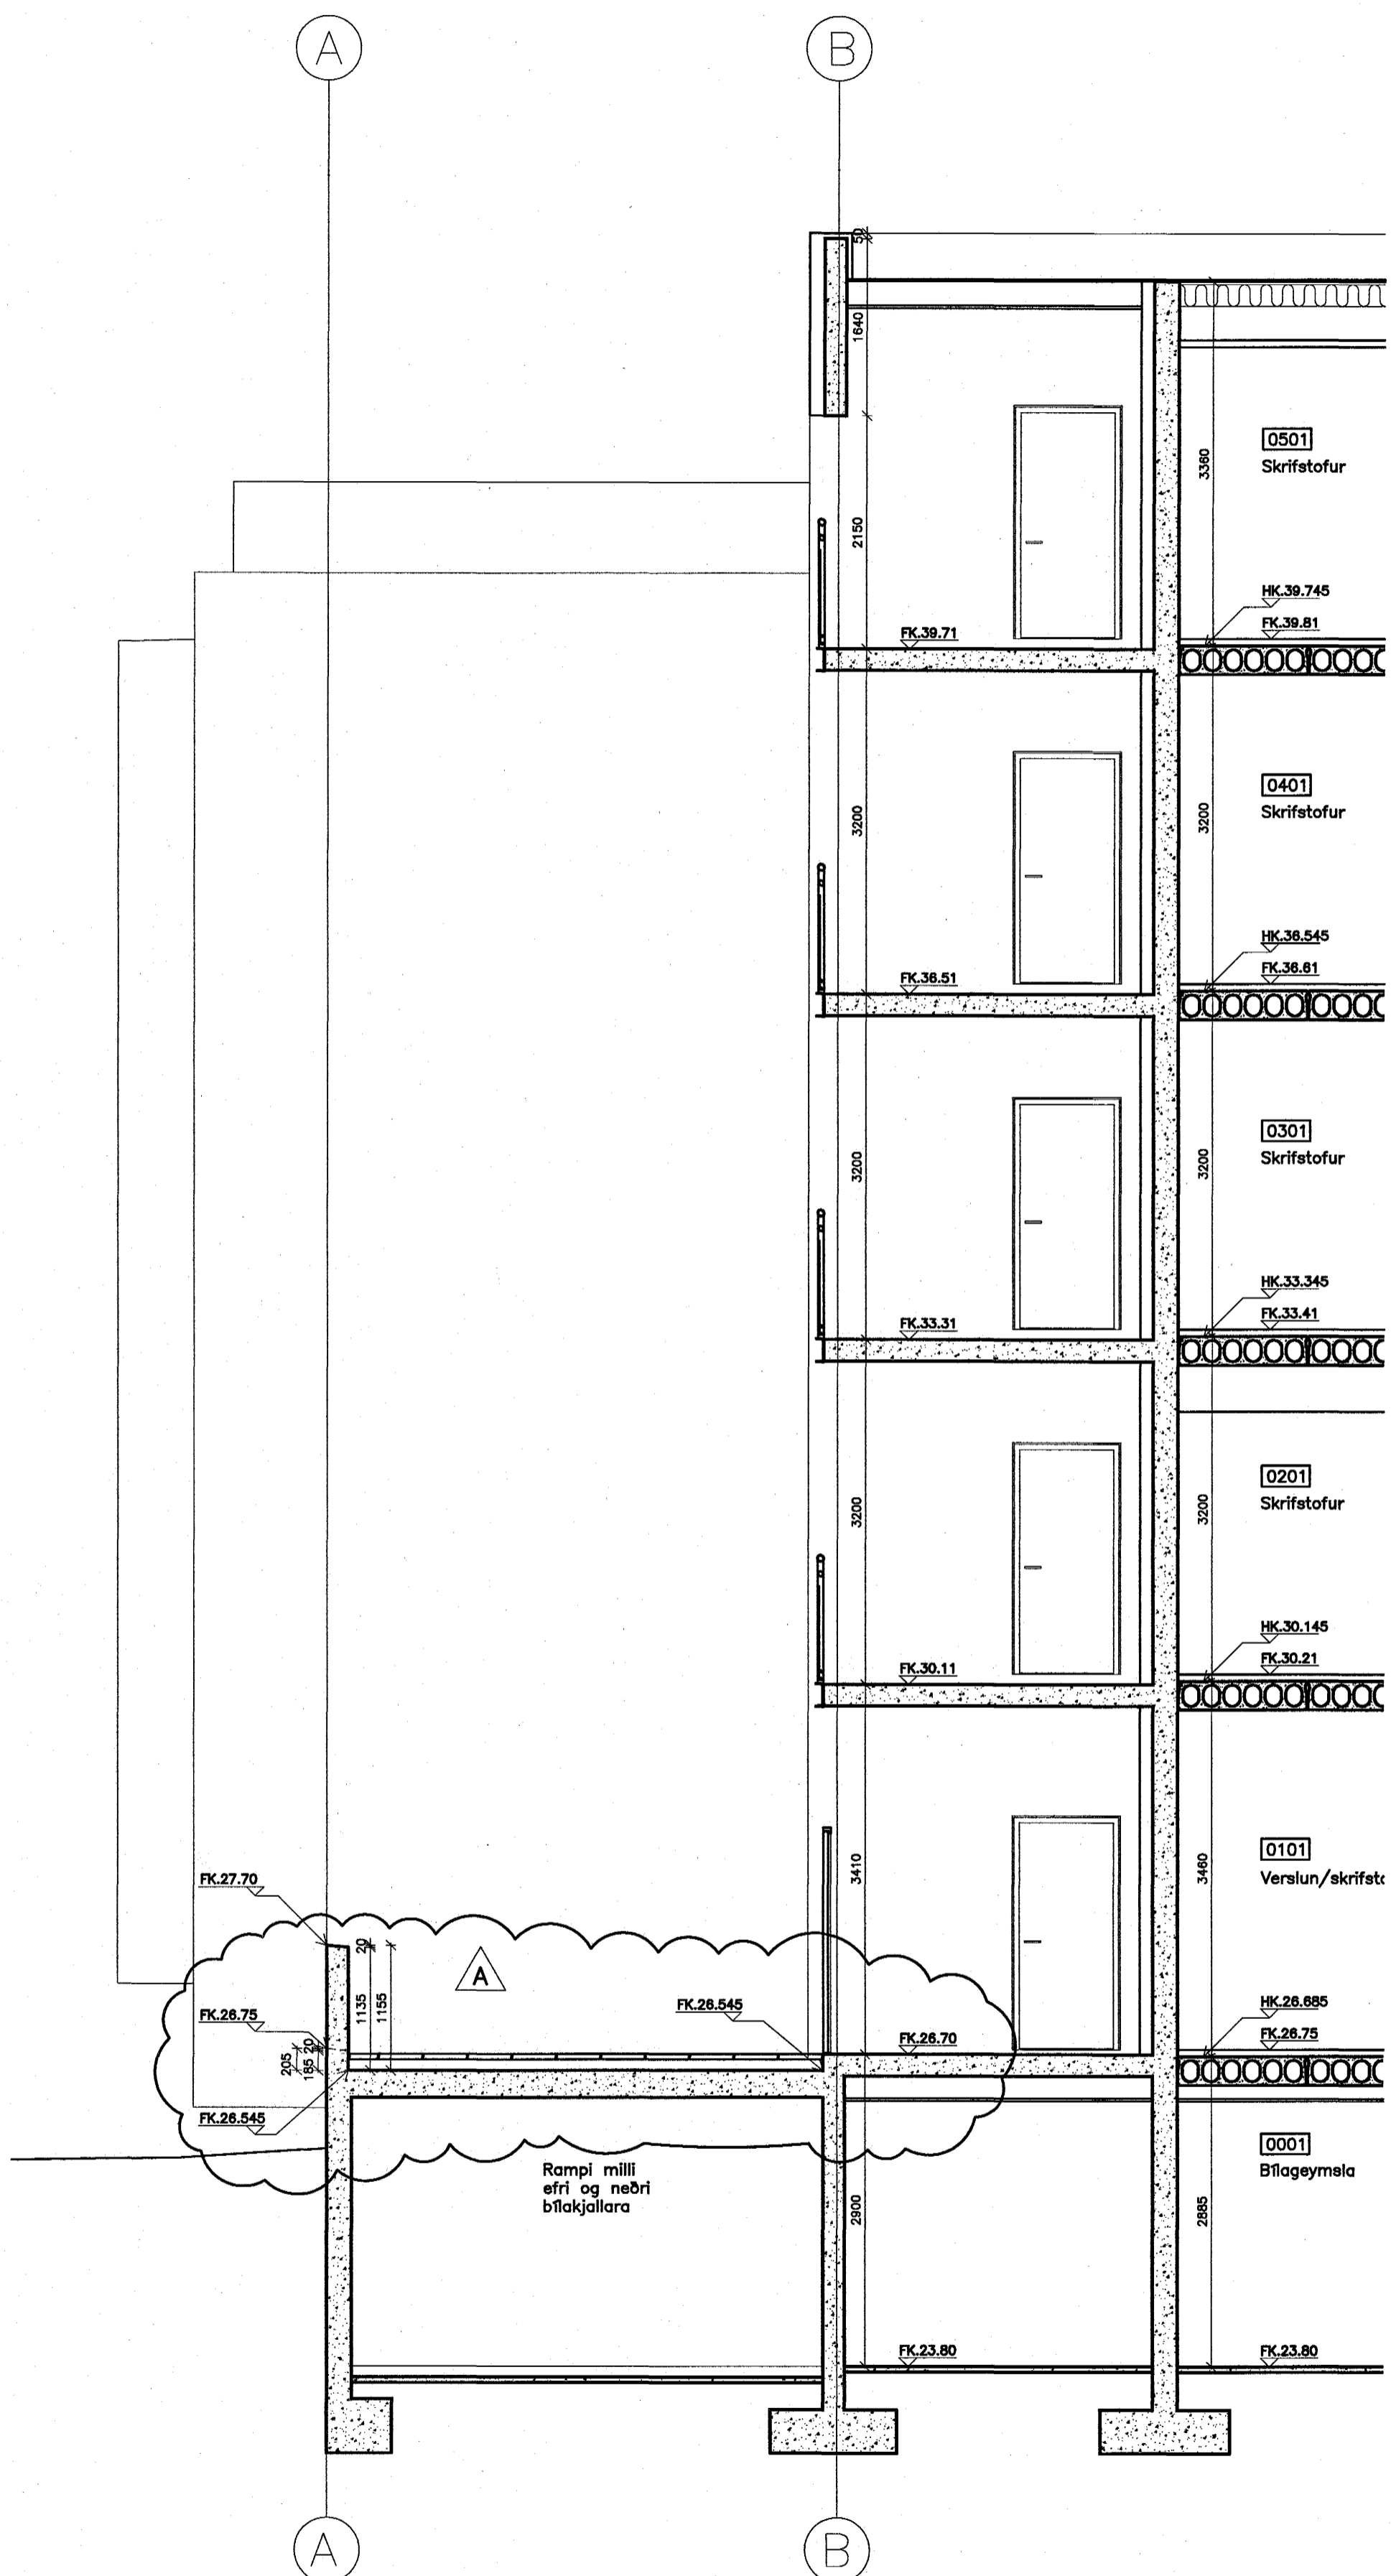

SNID H-H

C:  
B:  
A: Plata yfir vestari rampa einhalla. 19.10.04  
BREYTINGAR: DAGS:

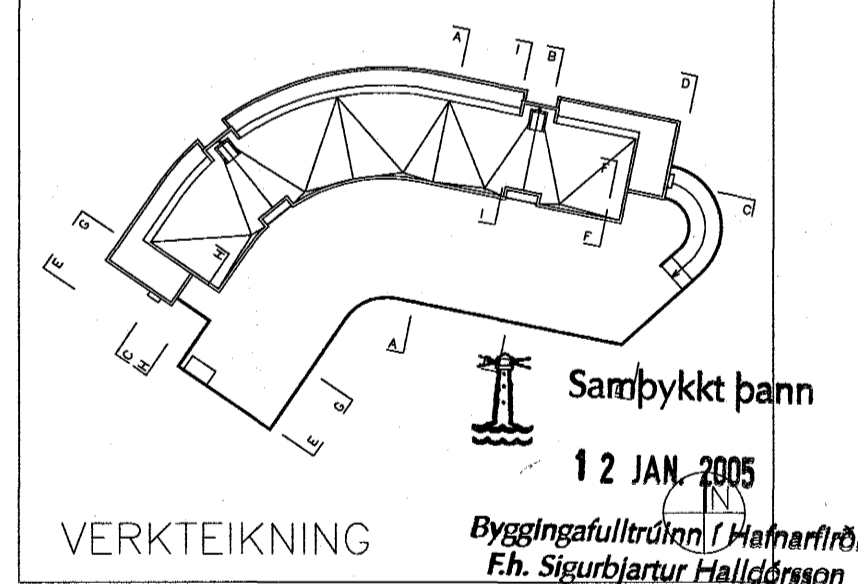

VERKTEIKNING  
DALS 0406  
Ris ehf  
VERK: DALS 0406  
KVARDI: 1:50  
DAGS: 09.09.04  
TEIKN: 08  
SNID F-F og H-H  
SKRÁ: 0406-08 og 08f.08p

**ÚTI INNI**  
**ARKITEKTAR**  
ÞINGHOLTSTRÆTI 27 101 REYKJAVÍK  
SÍMAR 5527880 & 5627880 FAX 5527881  
NETFANG veffang http://www.uti.is  
BALDUR Ó. SVAVARSSON ARKITEKTAR FAI  
120357-5149  
JÓN ÞÓR ÞORVALDSSON ARKITEKTAR FAI  
021256-7579

A  
A-240