
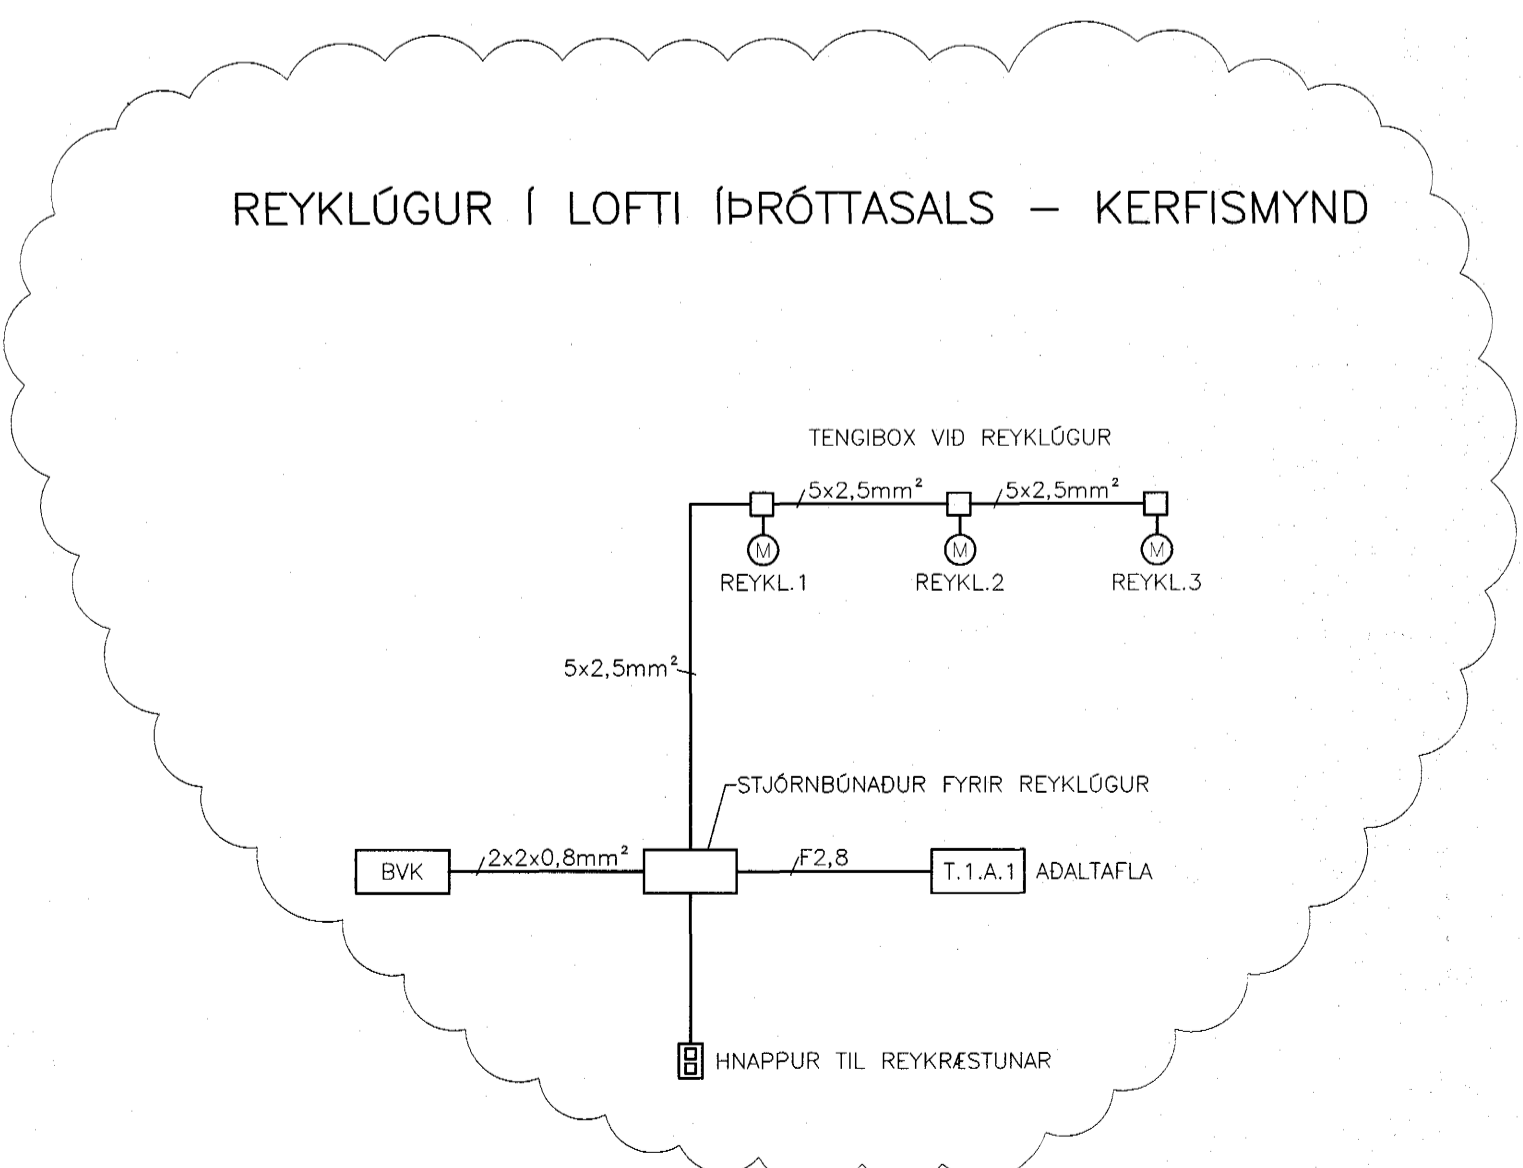



BRUNAVÍÐVÖRUNARKERFI — KERFISMYND

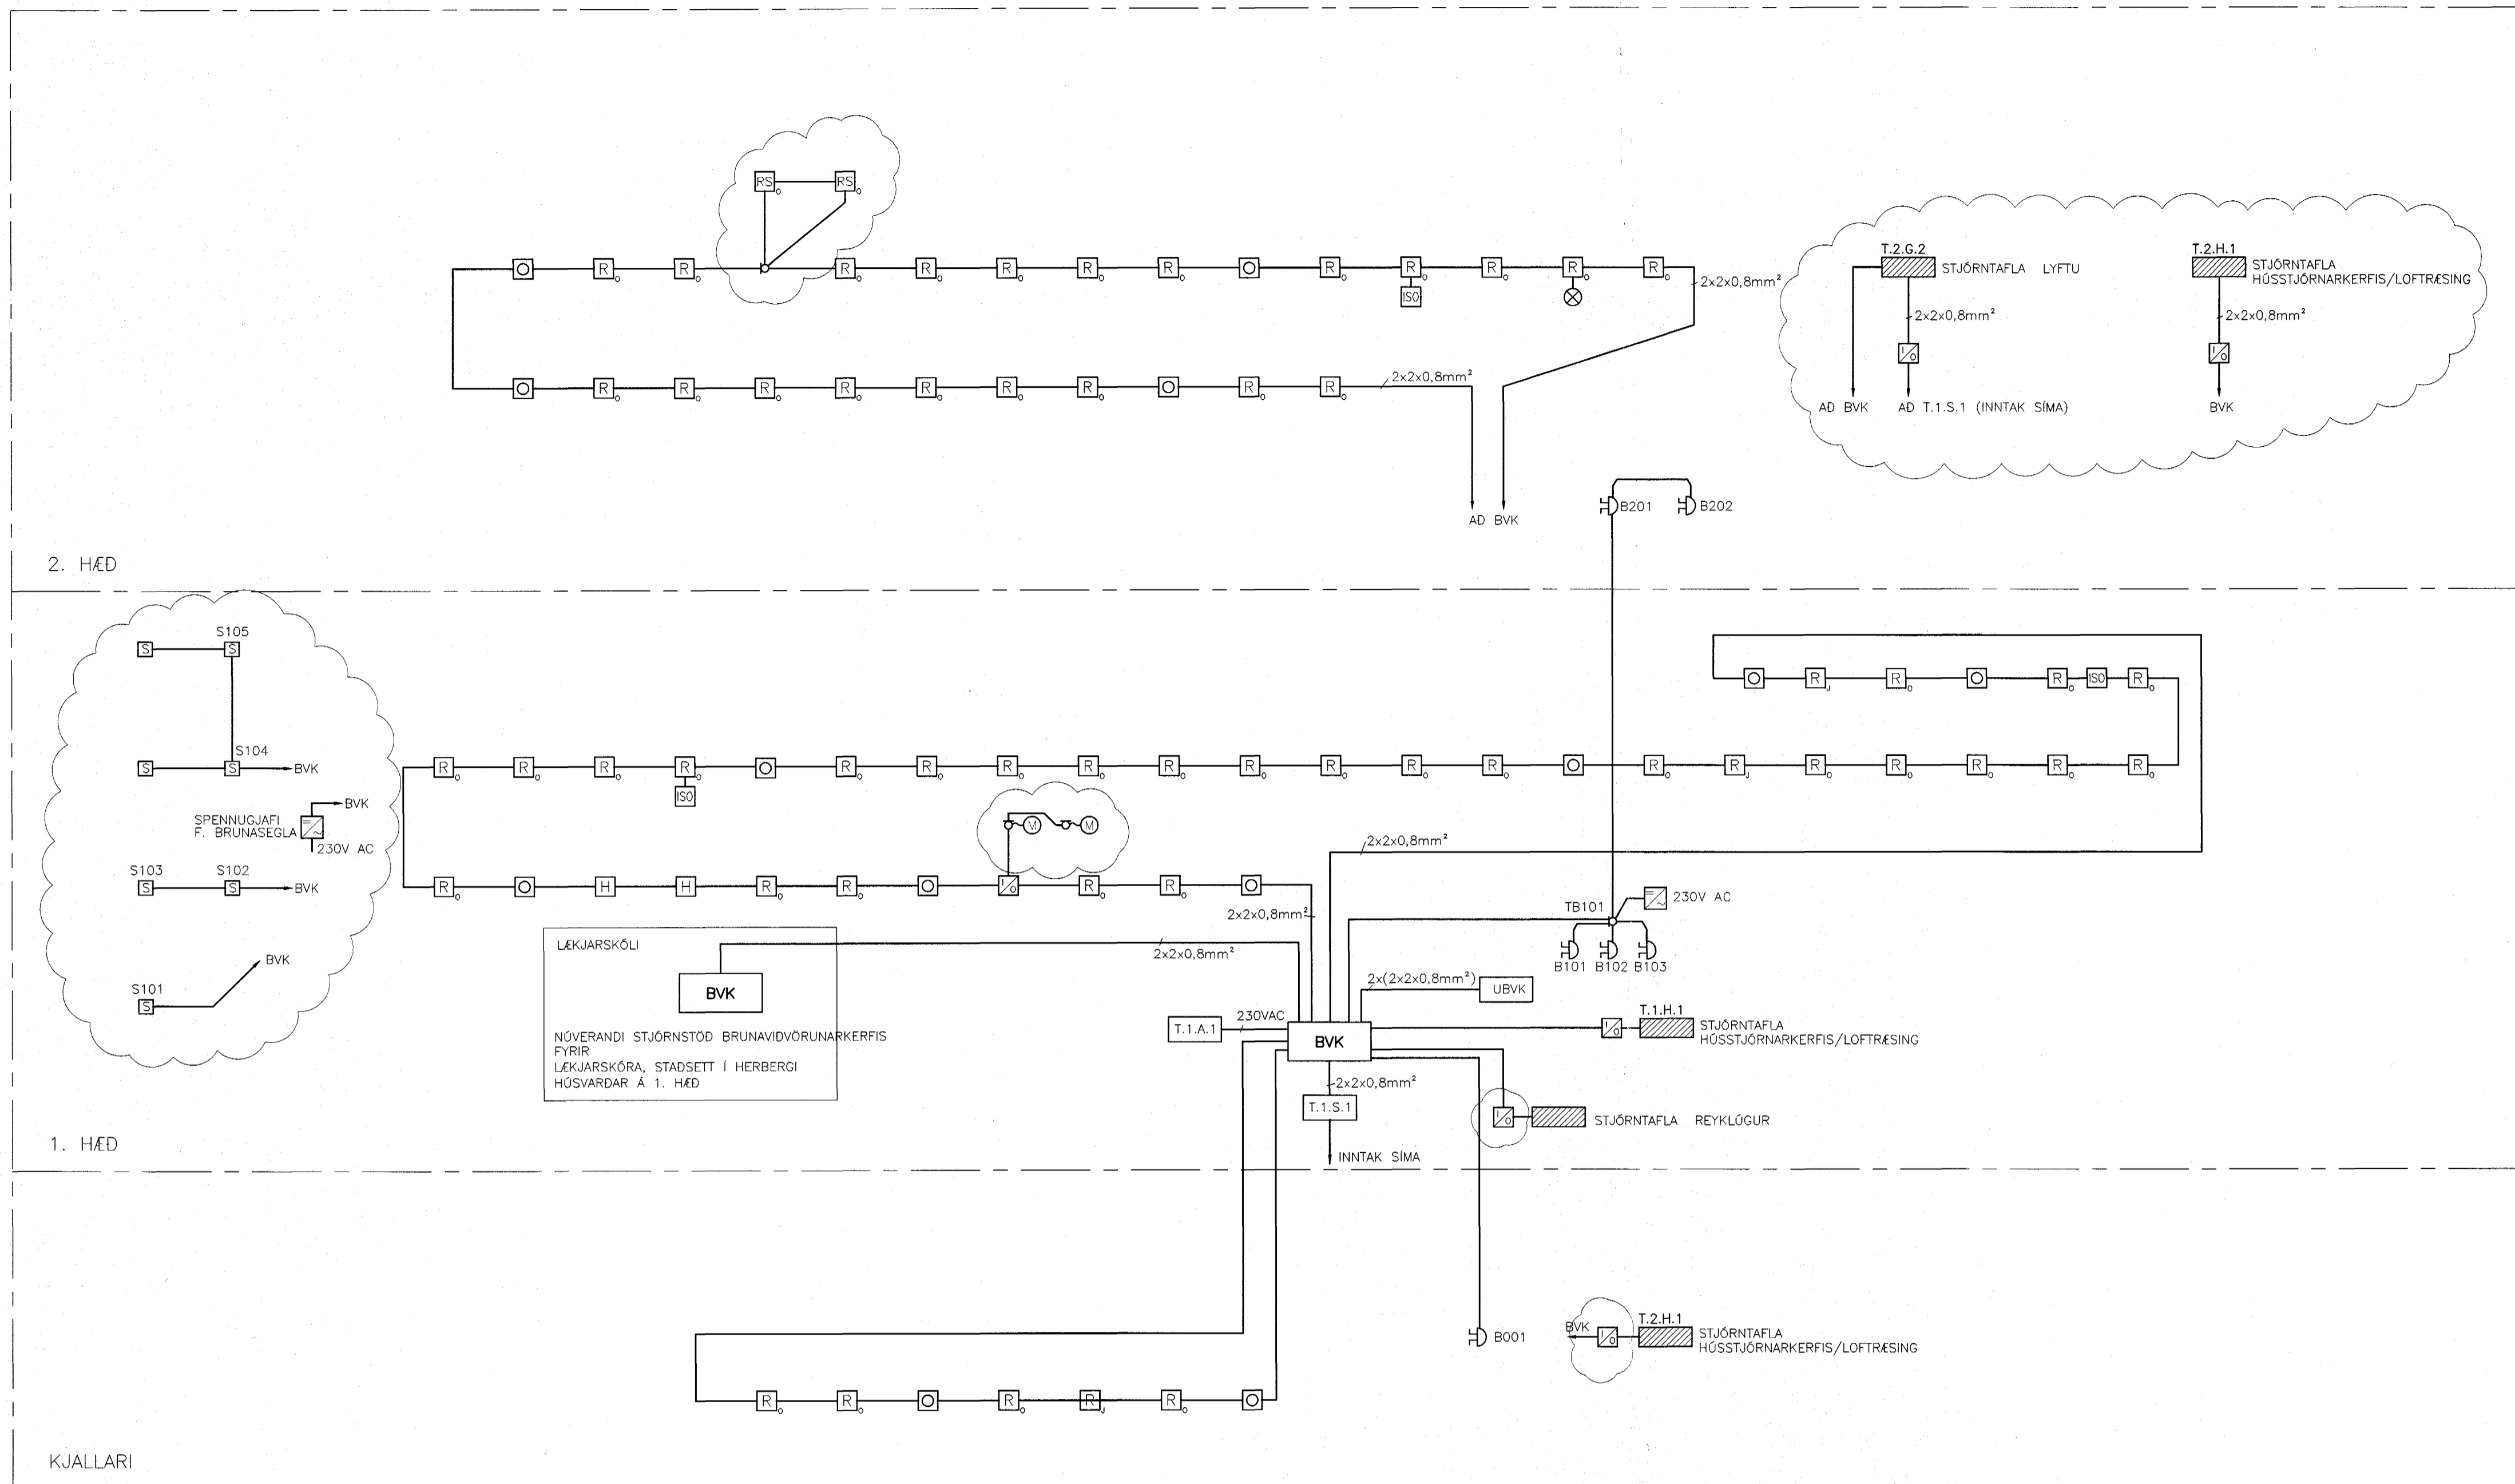

TILVÍSANIR:
ALMENNAR SKÝRINGAR SJÁ BL. NR. B3-R0-A-1

SC 071070-5069

A	13.12.04	ÞÍMASAR	BREYTINGAR	JJ	LL
BR.	DAGS	BREYTING		REIKN.	TEIKN.

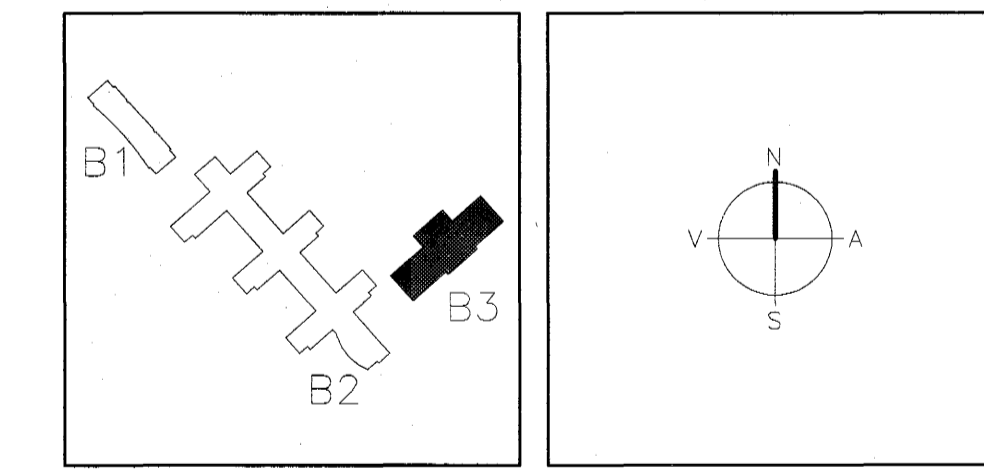

ARKITEKTAR
BERGSTADASTRÆTI 10, RVK.
sími:551-1460, netfang:arkitekt@ishof.is

FINNUR BJÖRGVINSSON
HILMAR ÞÓR BJÖRNSSON
SIGRÍÐUR ÓLAFSDÓTTIR

LANDMÖTUN.
NÝTTLA AVSÖLUR 6 - 200 KOPAVOGUR - Sími: 564 5000 - Fax: 564 5000 - Netfang: landmotun@landmotun.is

Samþykkt þann
04 JAN. 2005

VSÓ RÁÐGJÖF
BORGARTUN 20, 105 REYKJAVÍK, Sími 565-9000, SímiRéf 565-9010, Netfang vs@vs.is

SÓLVANGSVEGUR 4
LÆKJARKÓLI - ÍÞRÓTTAHÚSNÆÐI

RAFORKUVRKI BRUNAKERFI REYKLÖGUR KERFISMYND	HANNAÐ/TEIKN. ATH. <i>KBJ</i> SAMÞYKKT <i>sc</i> KT. <i>sc</i>	JJ/LL Simon Unndósson 110956-7769 28.11.2004
SVARDI VERKNR. 00258	TEIKN. NR. B3-R6-K-1	BR. A