



ÞAKKANTUR. MKV. 1:5

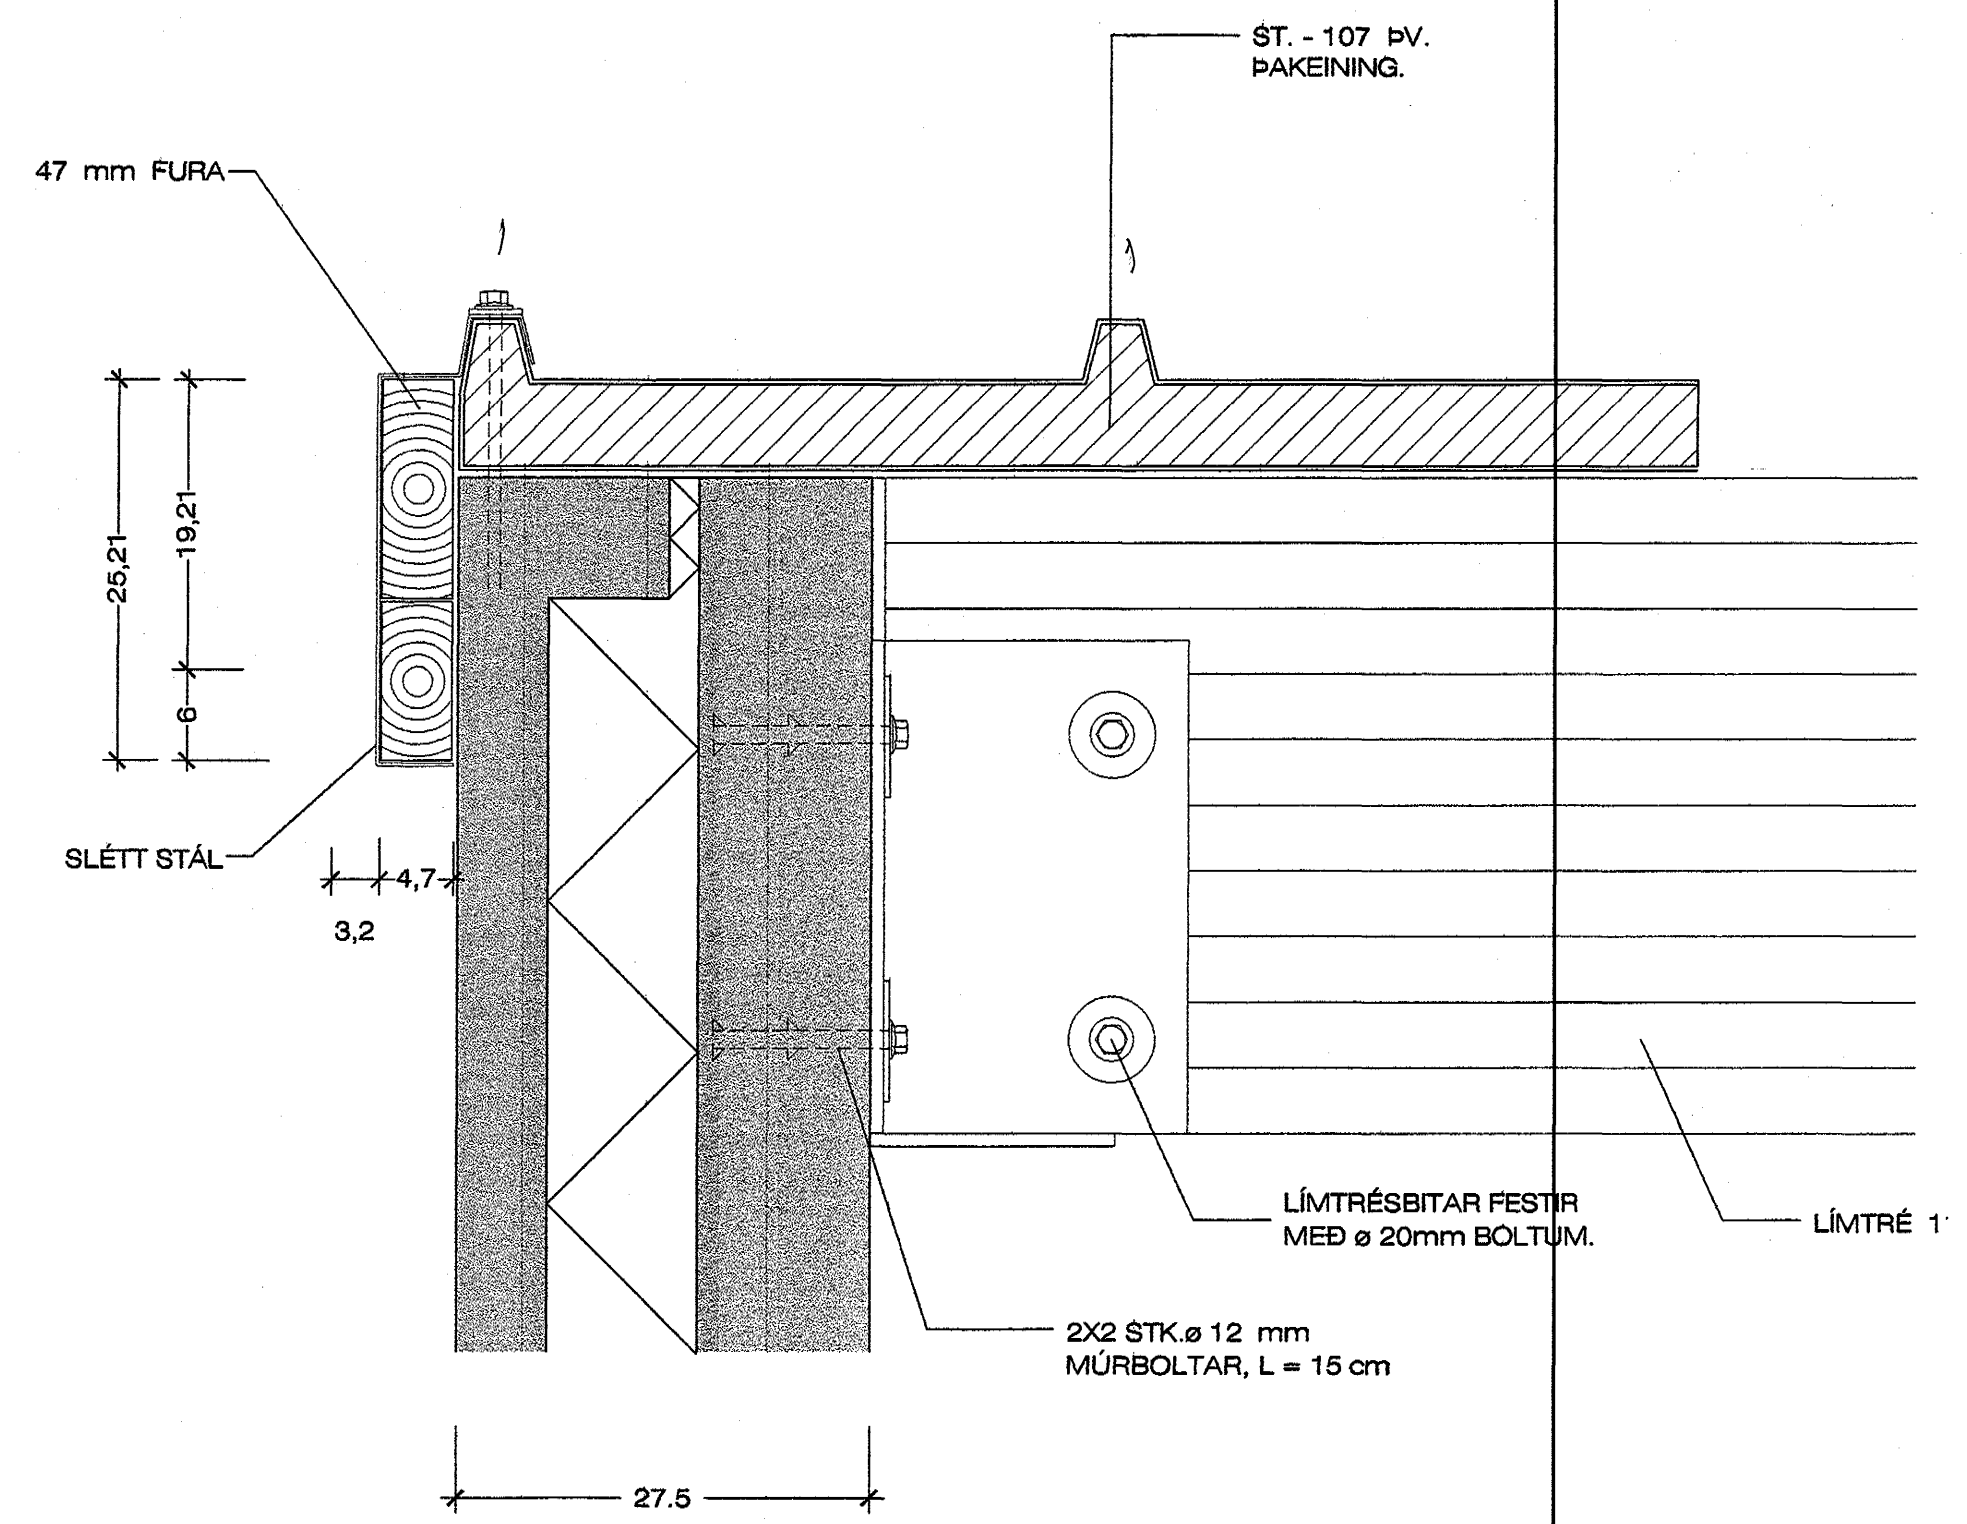

ÞAKKANTUR Á GAFLI MKV 1:5

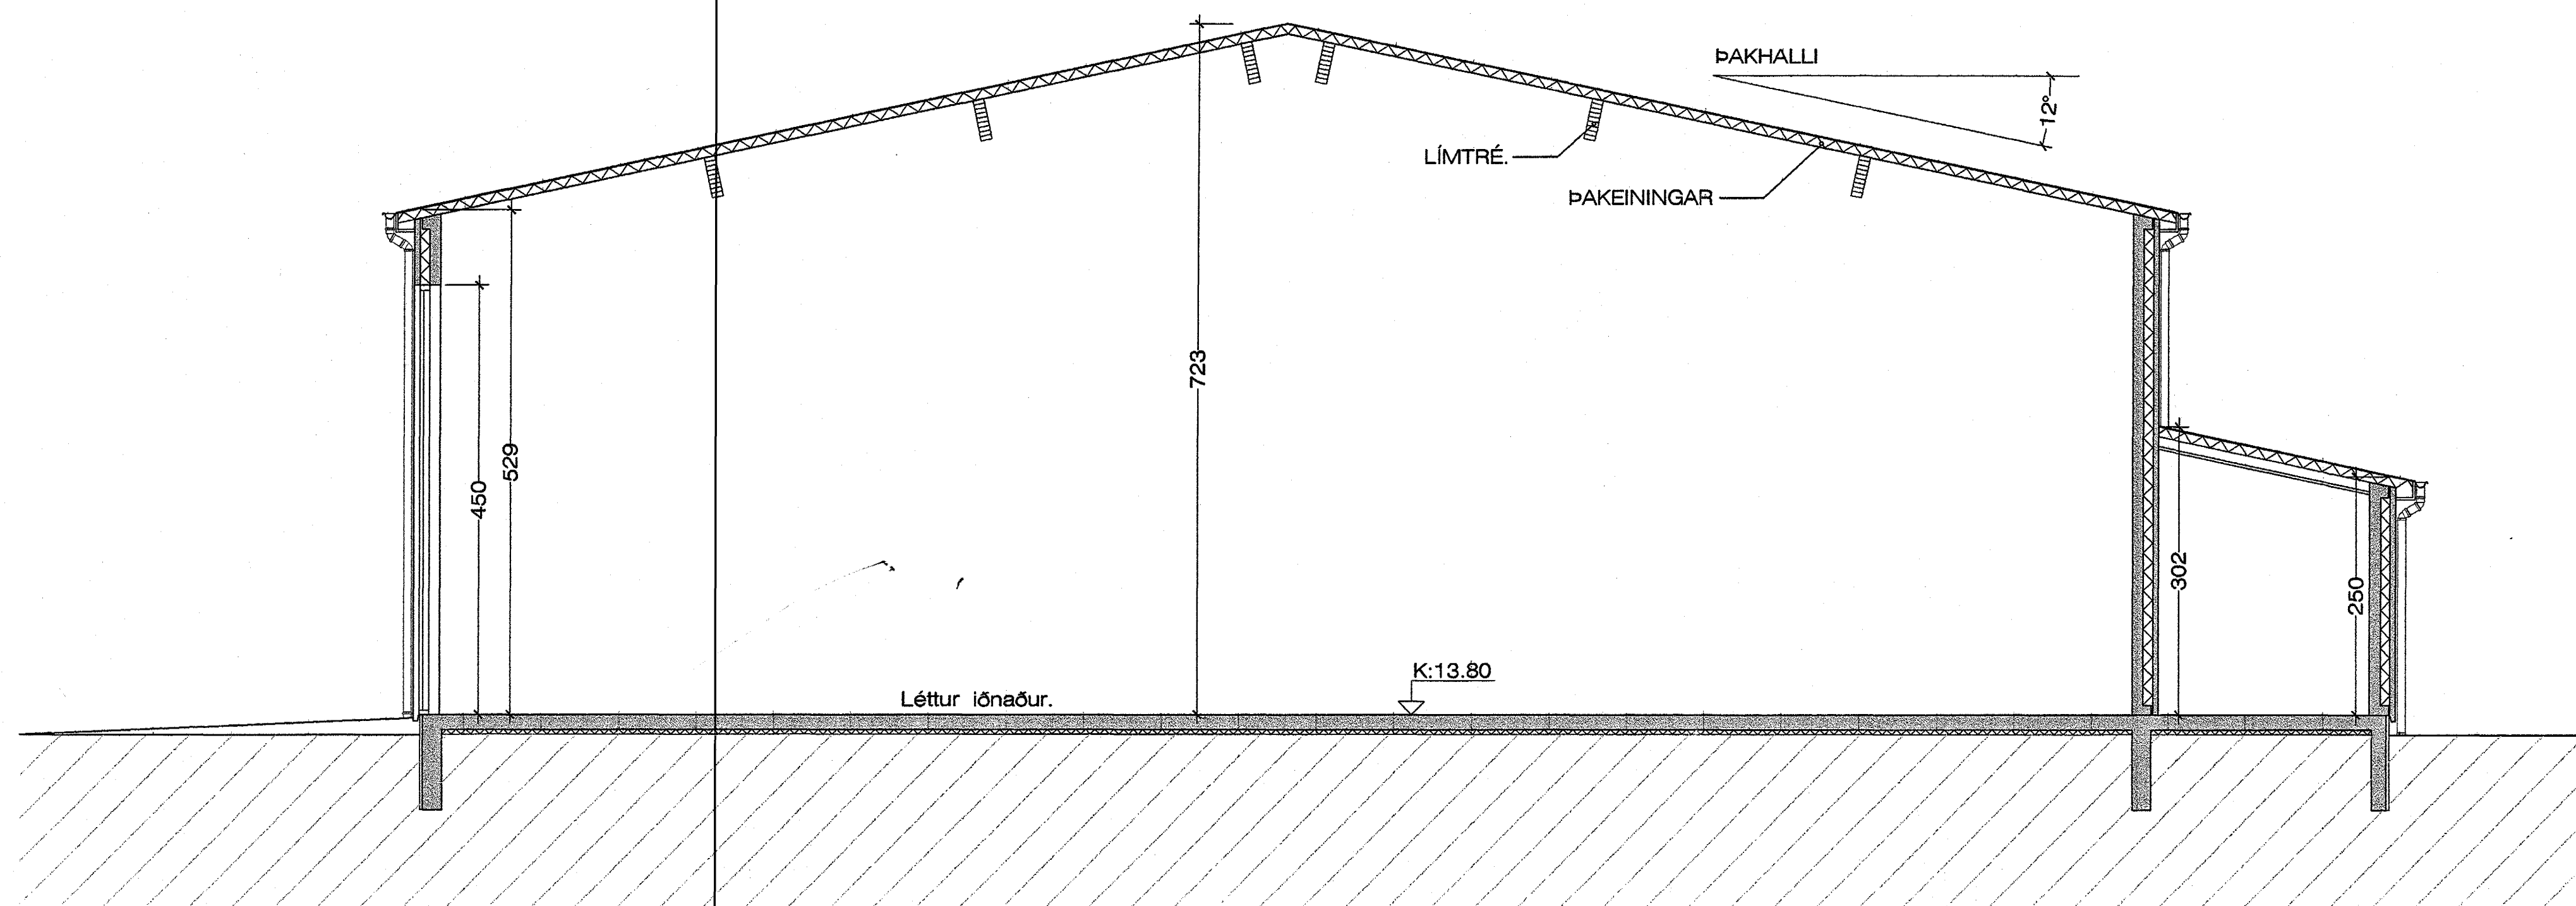

SNEIDING A - A Mkv 1:50

Algreitt þann  
21 JUNI 2004  
Hó

Útveggjum breytt í einingar  
15.08.2002

RAUÐHELLA 7 HAFNARFIRDI SNEIÐ & HLUTAM.

VERK NR. 253 DAGS. 10.05.2002 MÁL. 1:50 & 1:5  
TEIKN. NR. 203 BREYTT.

JÓN GUÐMUNDSSON ARKITEKT  
VINNUSTOFA SUBURLANDSBRÁUT 18 REYKJAVÍK Sími 552 5055

Bogi Kristjánsson Magnúsen, Jón Guðmundsson, Teiknistofa Raúðhella 7 1901.dwg 10.05.2002 09:21