
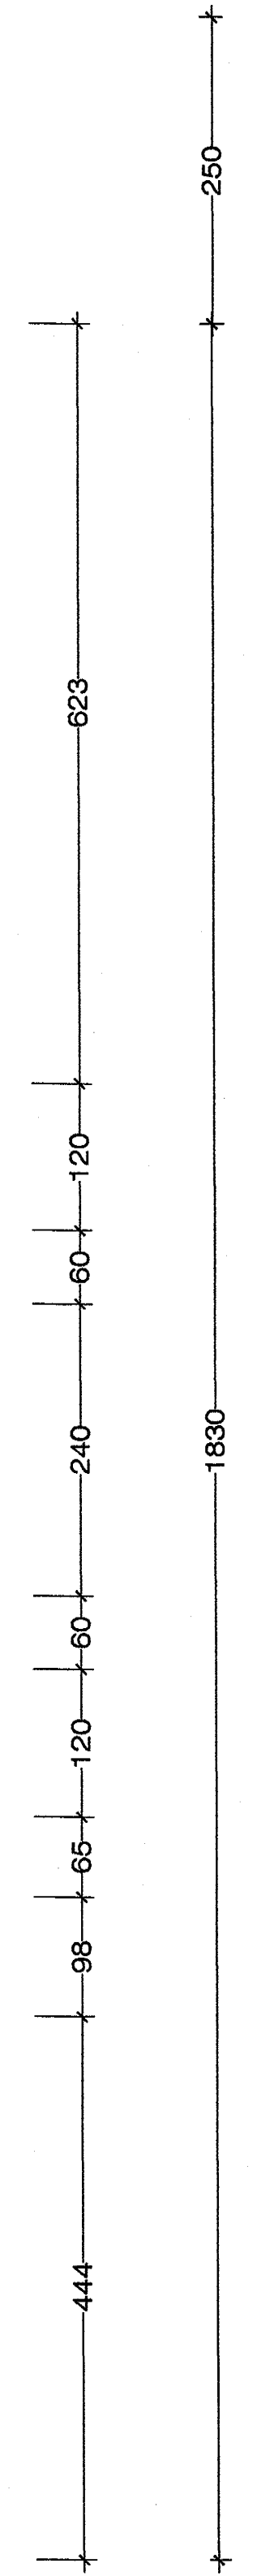


Bogi Kristinnson Magnúsen, Jón Guðmundsson, Teiknistofa 10.05.2002 09:21 Raúðhella 7 1901.dwg

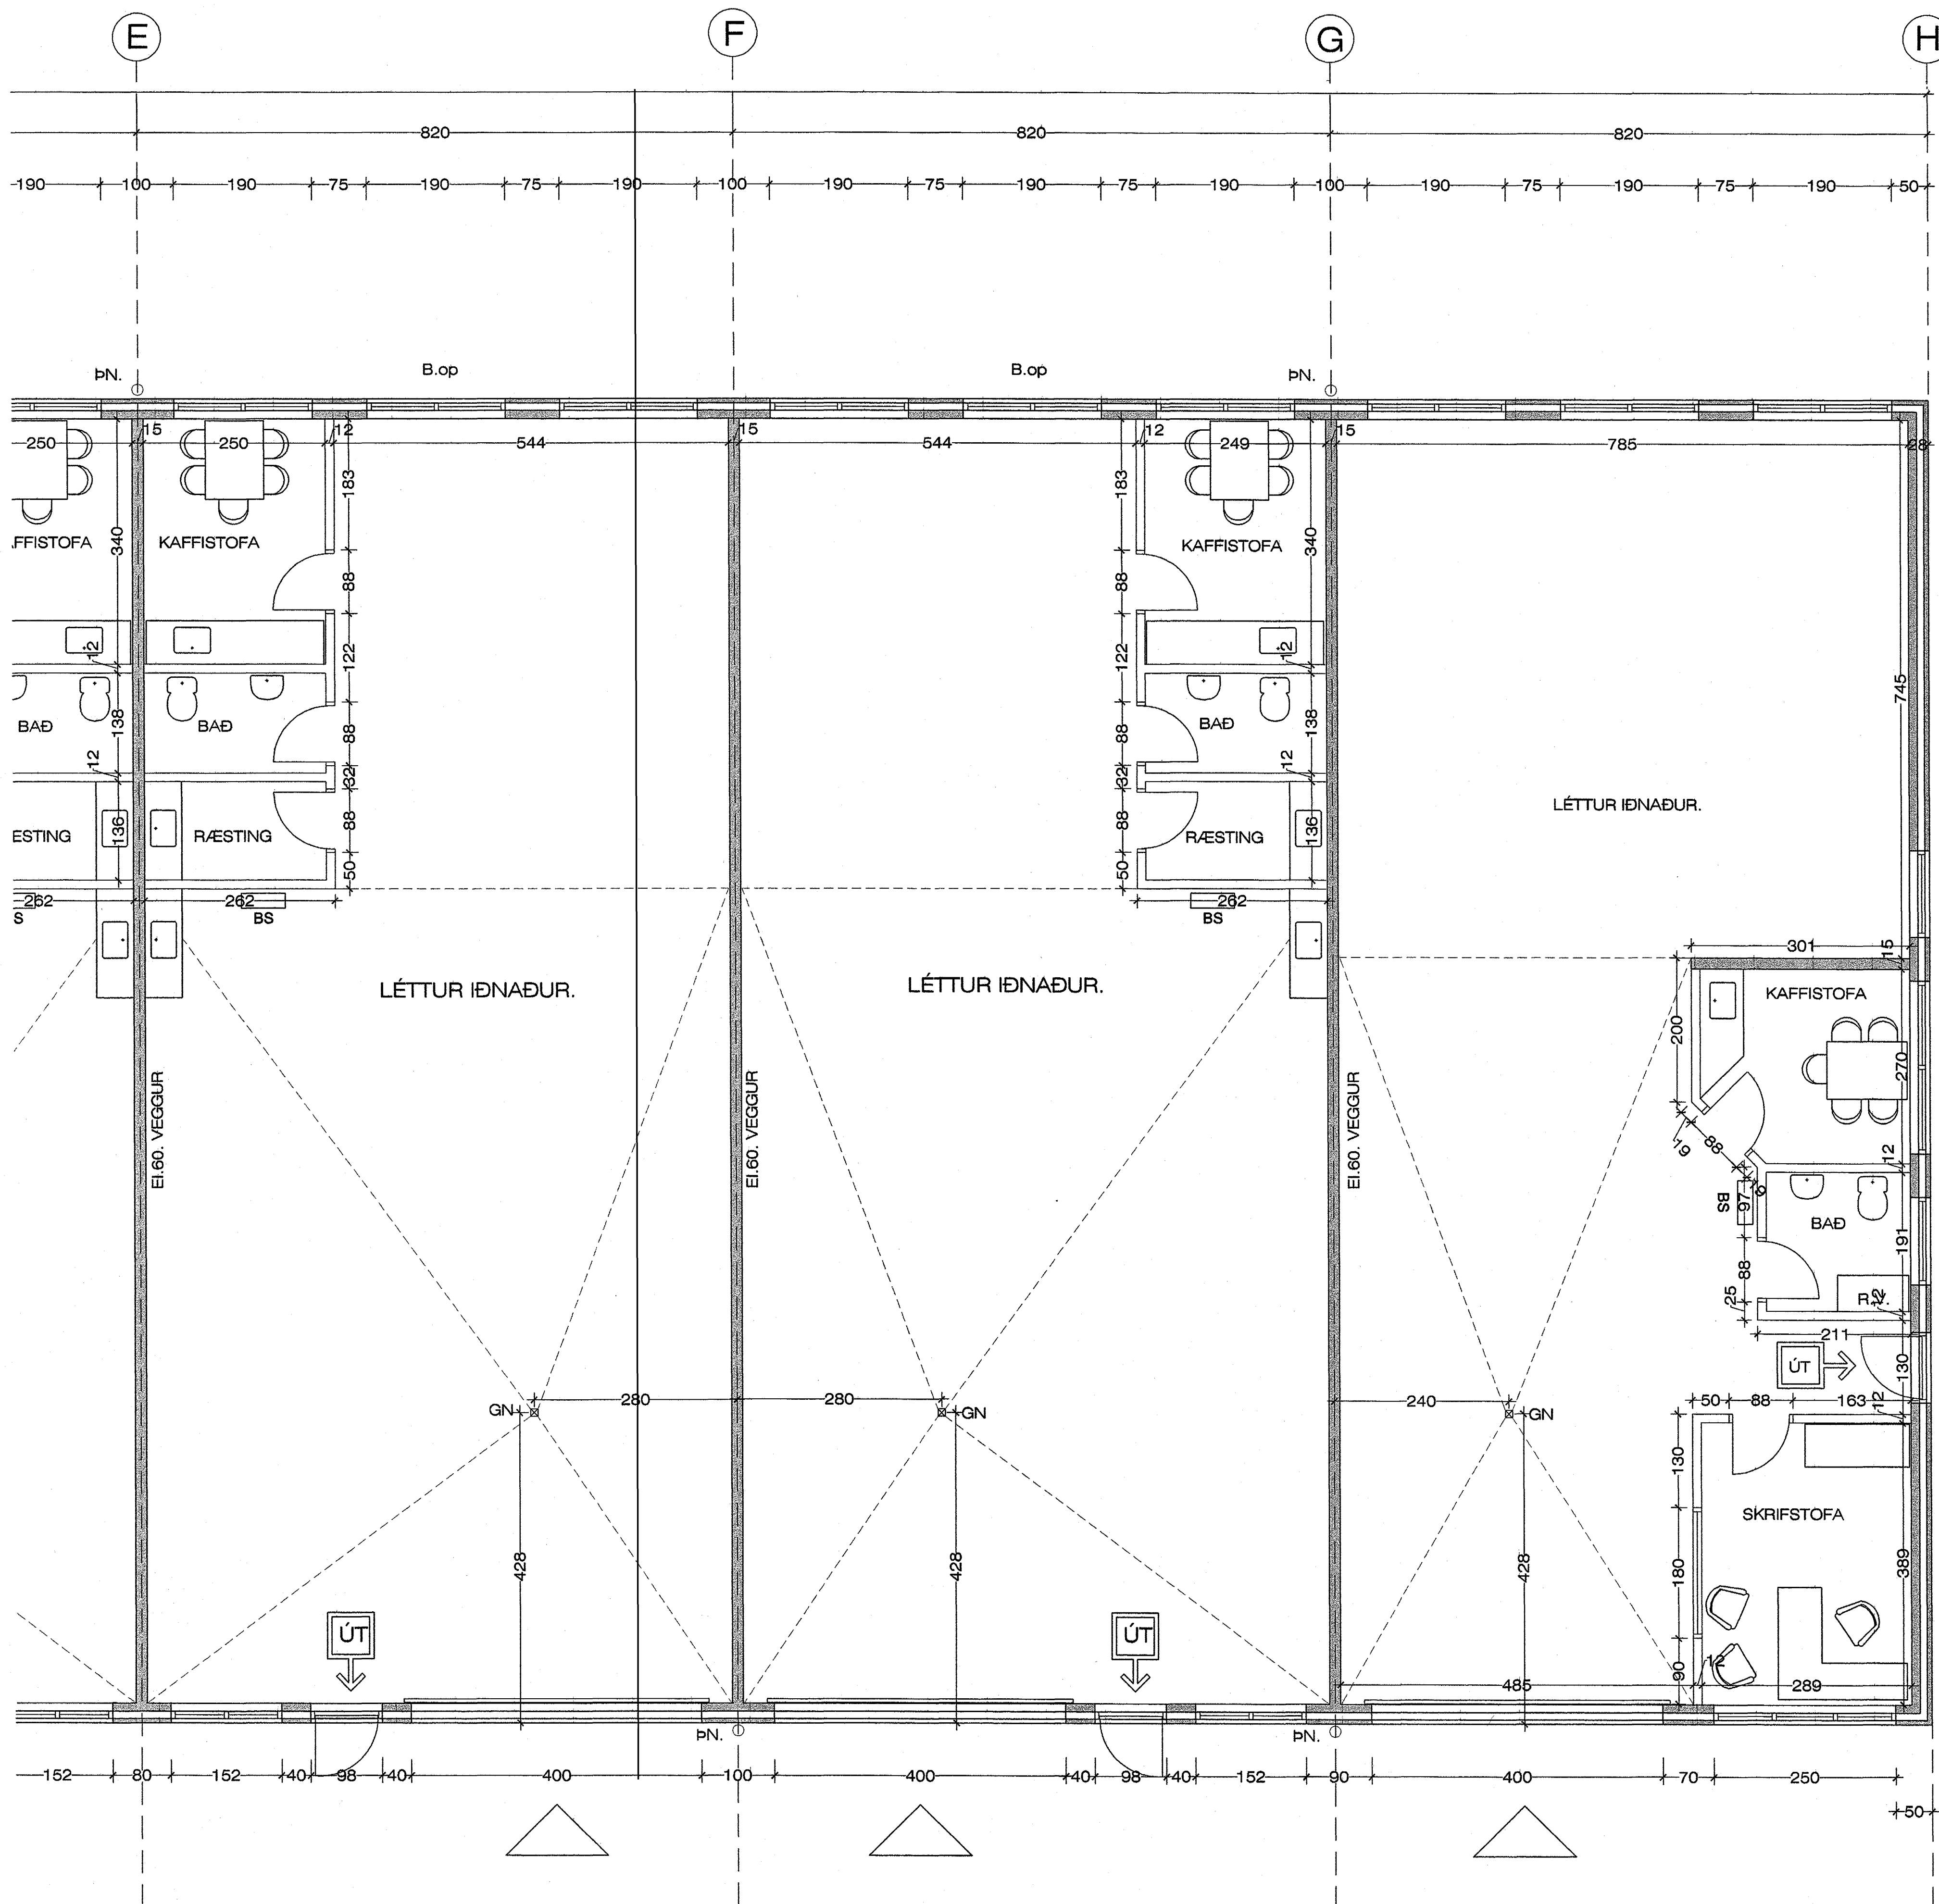

Byggingatillit HAFNARFIRÐI
 Aigrent þann
 21 JUNI 2004
 Hó

Útveggjum breytt í einingar
 15.08.2002

GRUNNMYND JARÐHÆÐ. Mkv 1:50 HLUÐI 2.

RAÚÐHELLA 7 HAFNARFIRÐI GRUNNMYND 2

VERK NR. 253 DAGS. 10.05.2002 MÁL. 1:50
 TEIKN. NR. 202 BREYTT.

JÓN GUÐMUNDSSON ARKITEKT
 VINNUSTOFA SUDURLANDSBRÁUT 16 REYKJÁVIK Sími 552 5055