

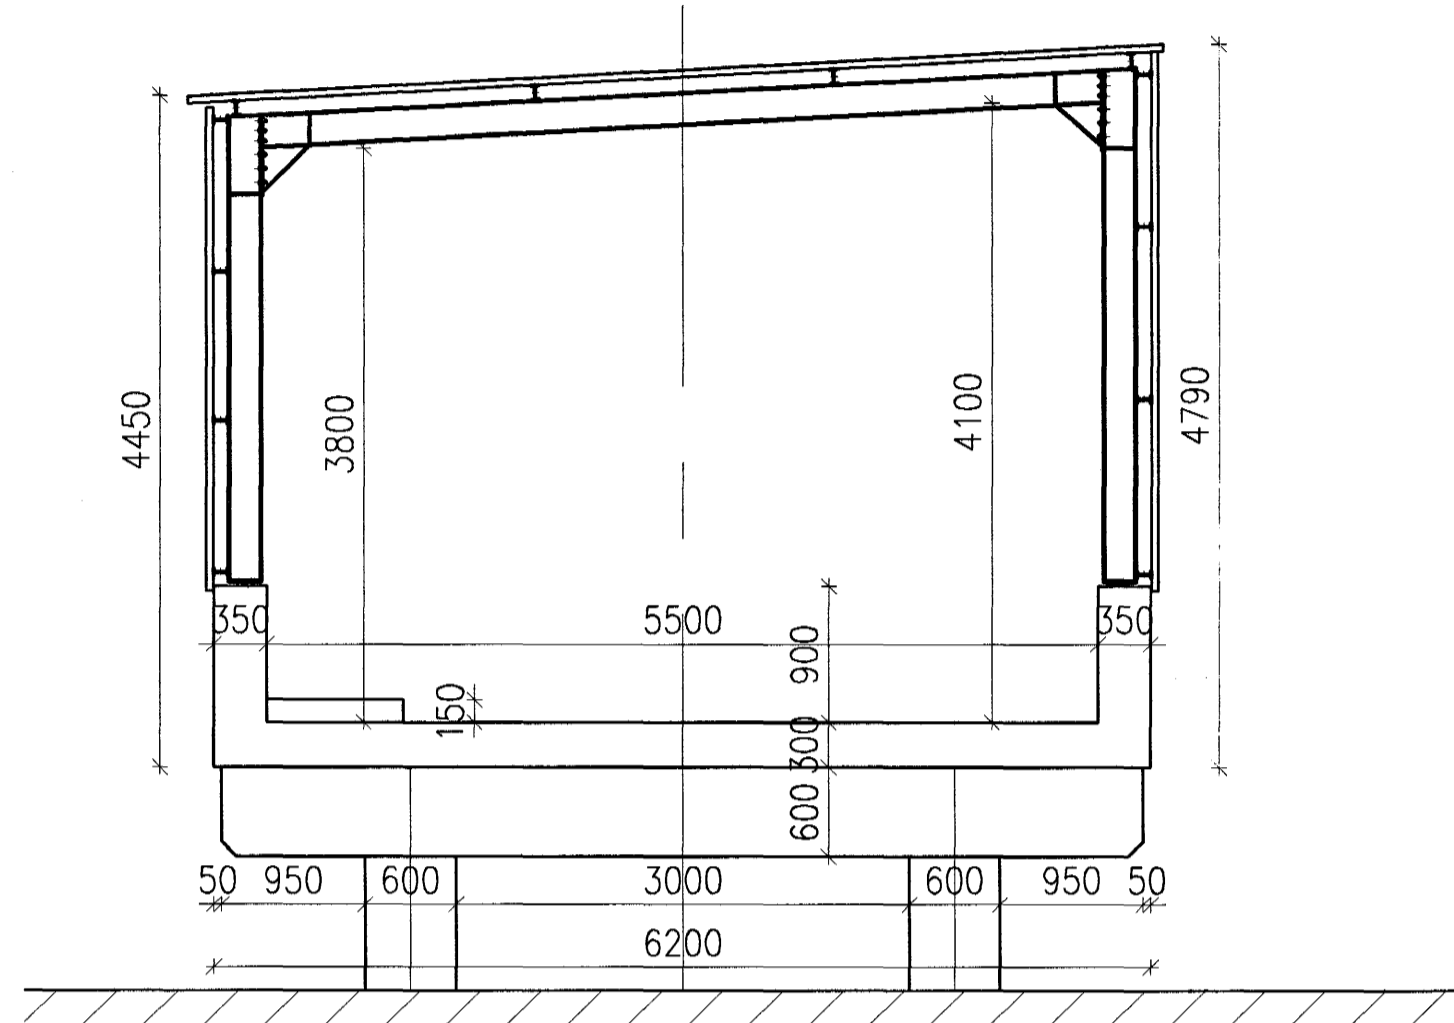
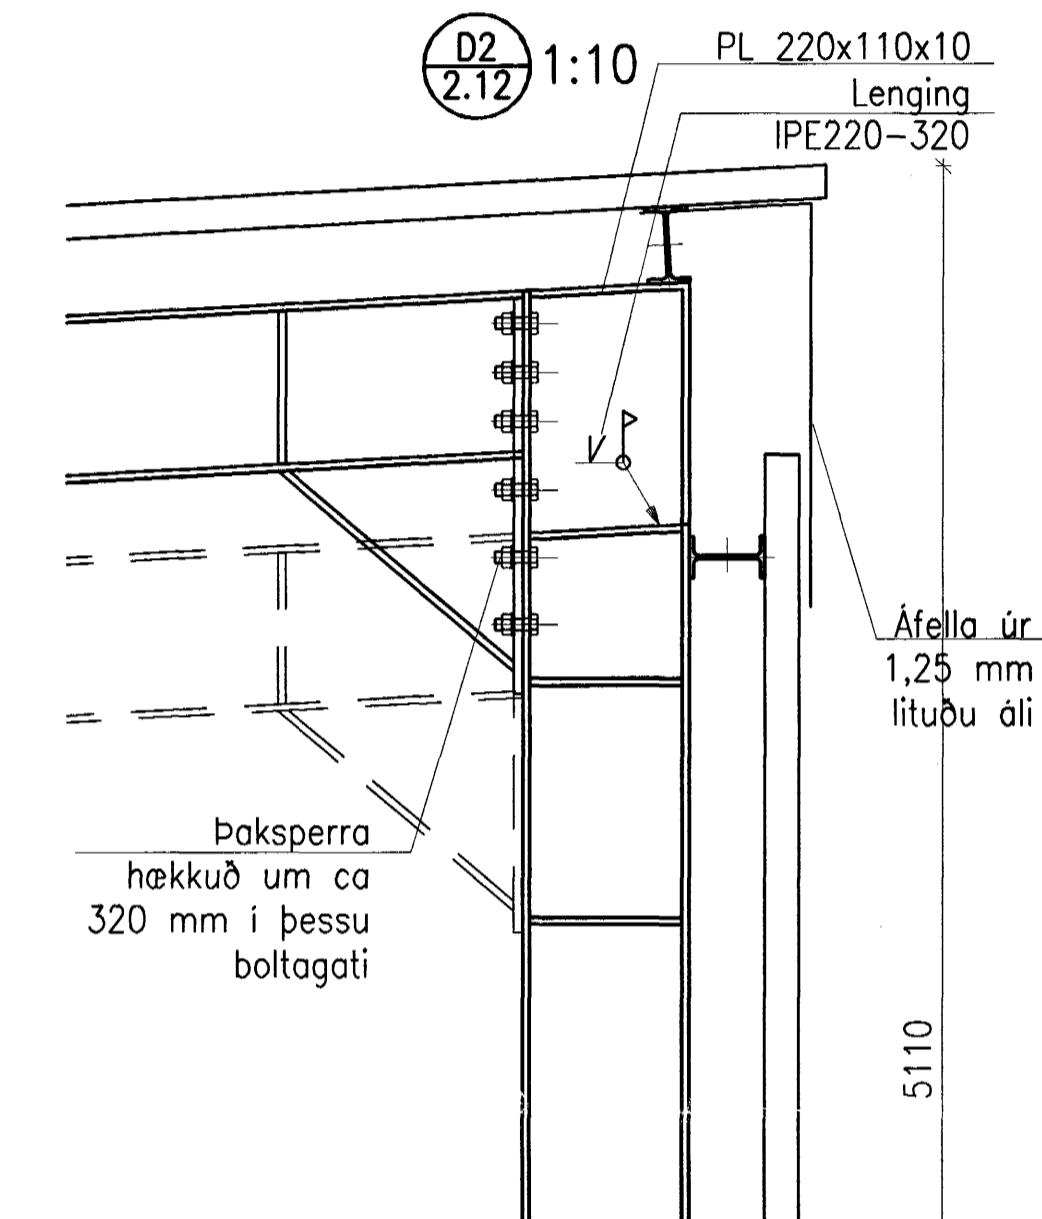



ÞVERSNIÐ – FYRIR BREYTINGU, 1:50

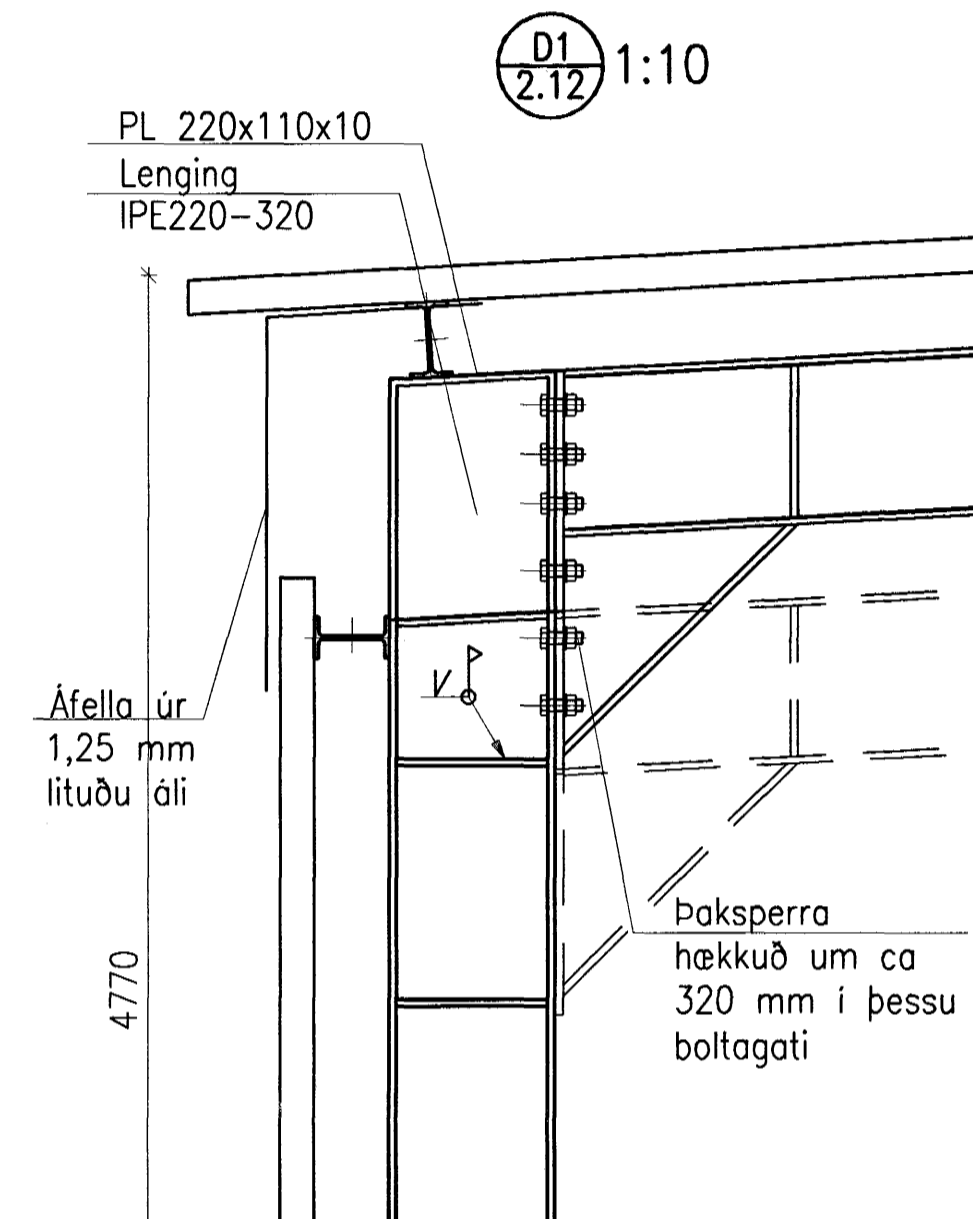



ÞVERSNIÐ – EFTIR BREYTINGU, 1:50

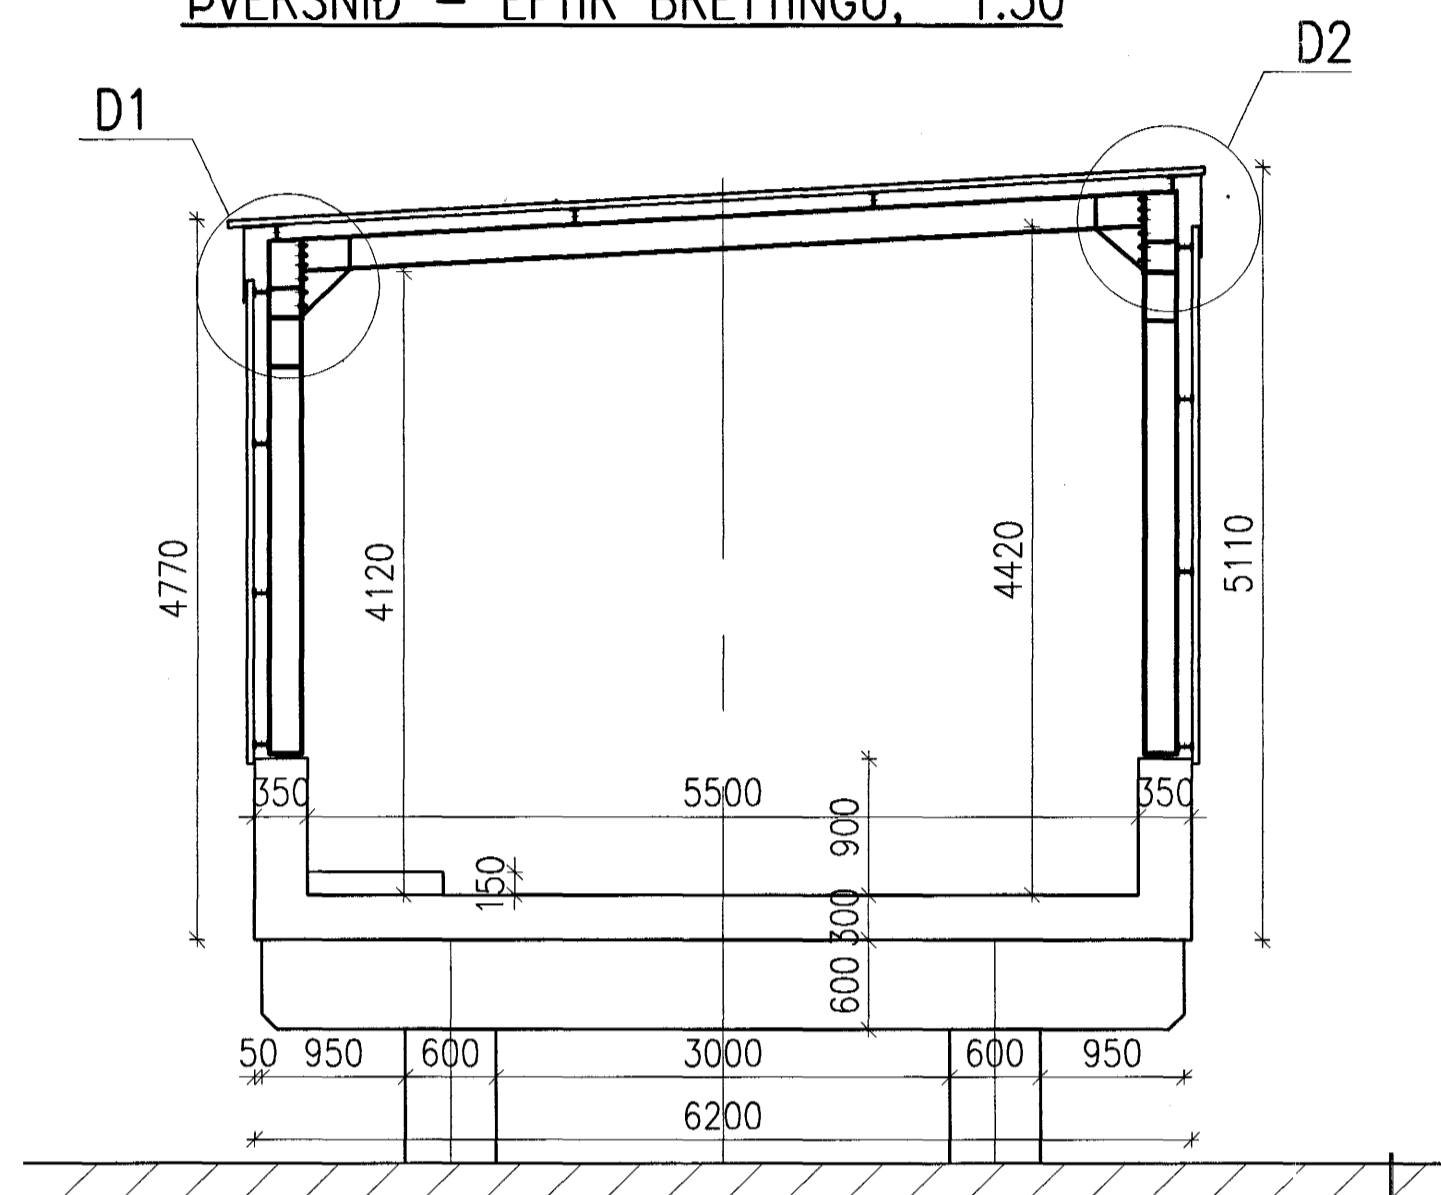

D1 BREYTTUR GÓLFHALLI, 1:100

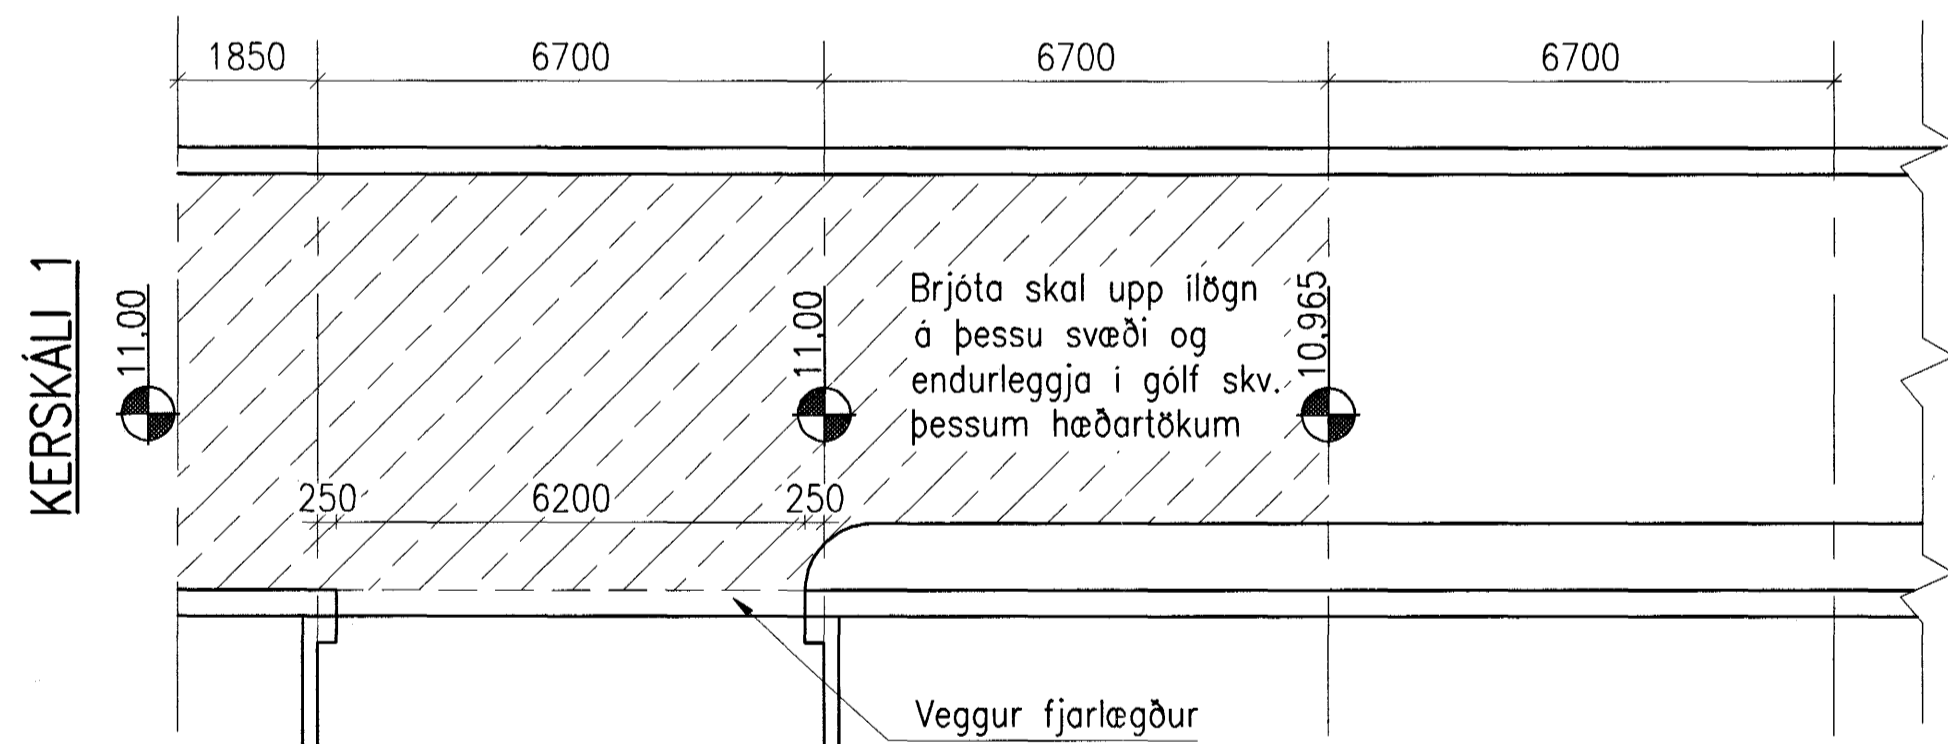

Byggingafrúnnir Hafnarfjörður
 Afgreitt þann
 23 JUNI 2004
 HÓ

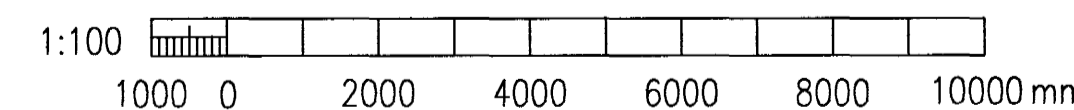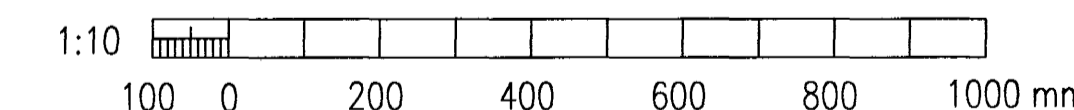

Skýringar:
 Explanations:

This drawing is the property of the ICELANDIC ALUMINIUM CO. LTD. and handed out for personal use only. It may neither be copied nor made available to others without permission of the ICELANDIC ALUMINIUM CO. LTD. The receiver is liable for any misuse.

Fjöldi stykkja Number of pieces	Hlutur Object	Atriði Item	Efni Material	eo.:stk Weight (kg)	total í heild Total weight	Athugasemdir Remarks
IV III II I	ÖKURAMPI NORÐUR ÚR KERSKÁLA 1					Málfróði Scale
	HÆKKUN ÞAKS					Stærð frumteikn. Format of orig. A1
	Snið					Útönn.-Eq.type-Eq.no.
	Verkfræðistofa Sigurðar Thorgeirsson hf. Áttúla 4, 104 Reykjavík, Sími 565 5000 Fax 565 5010				Dr.no. of suppl. / Tekinnir. vertið 99.110-2.13	Breyt./Rev.
	Teknað Drawn	NI JÚNÍ 1999	Yfirfarið Checked	Sambýkt / Approved		
	ICELANDIC ALUMINIUM CO. LTD. Straumsvík, IS-220 Hafnarfjörður, Iceland				Dr.no. of ISAL / Tekn. nr. ISAL 164 449	Breyt./Rev.
	Teknað Drawn		Yfirfarið Checked	Sambýkt / Approved		

Tilv. teikningar nr. ISAL Ref. drawing no. of ISAL
 Samsetn. teikningar nr. ISAL Assembly drawing no. of ISAL