


Sneiðing A - A 1: 50

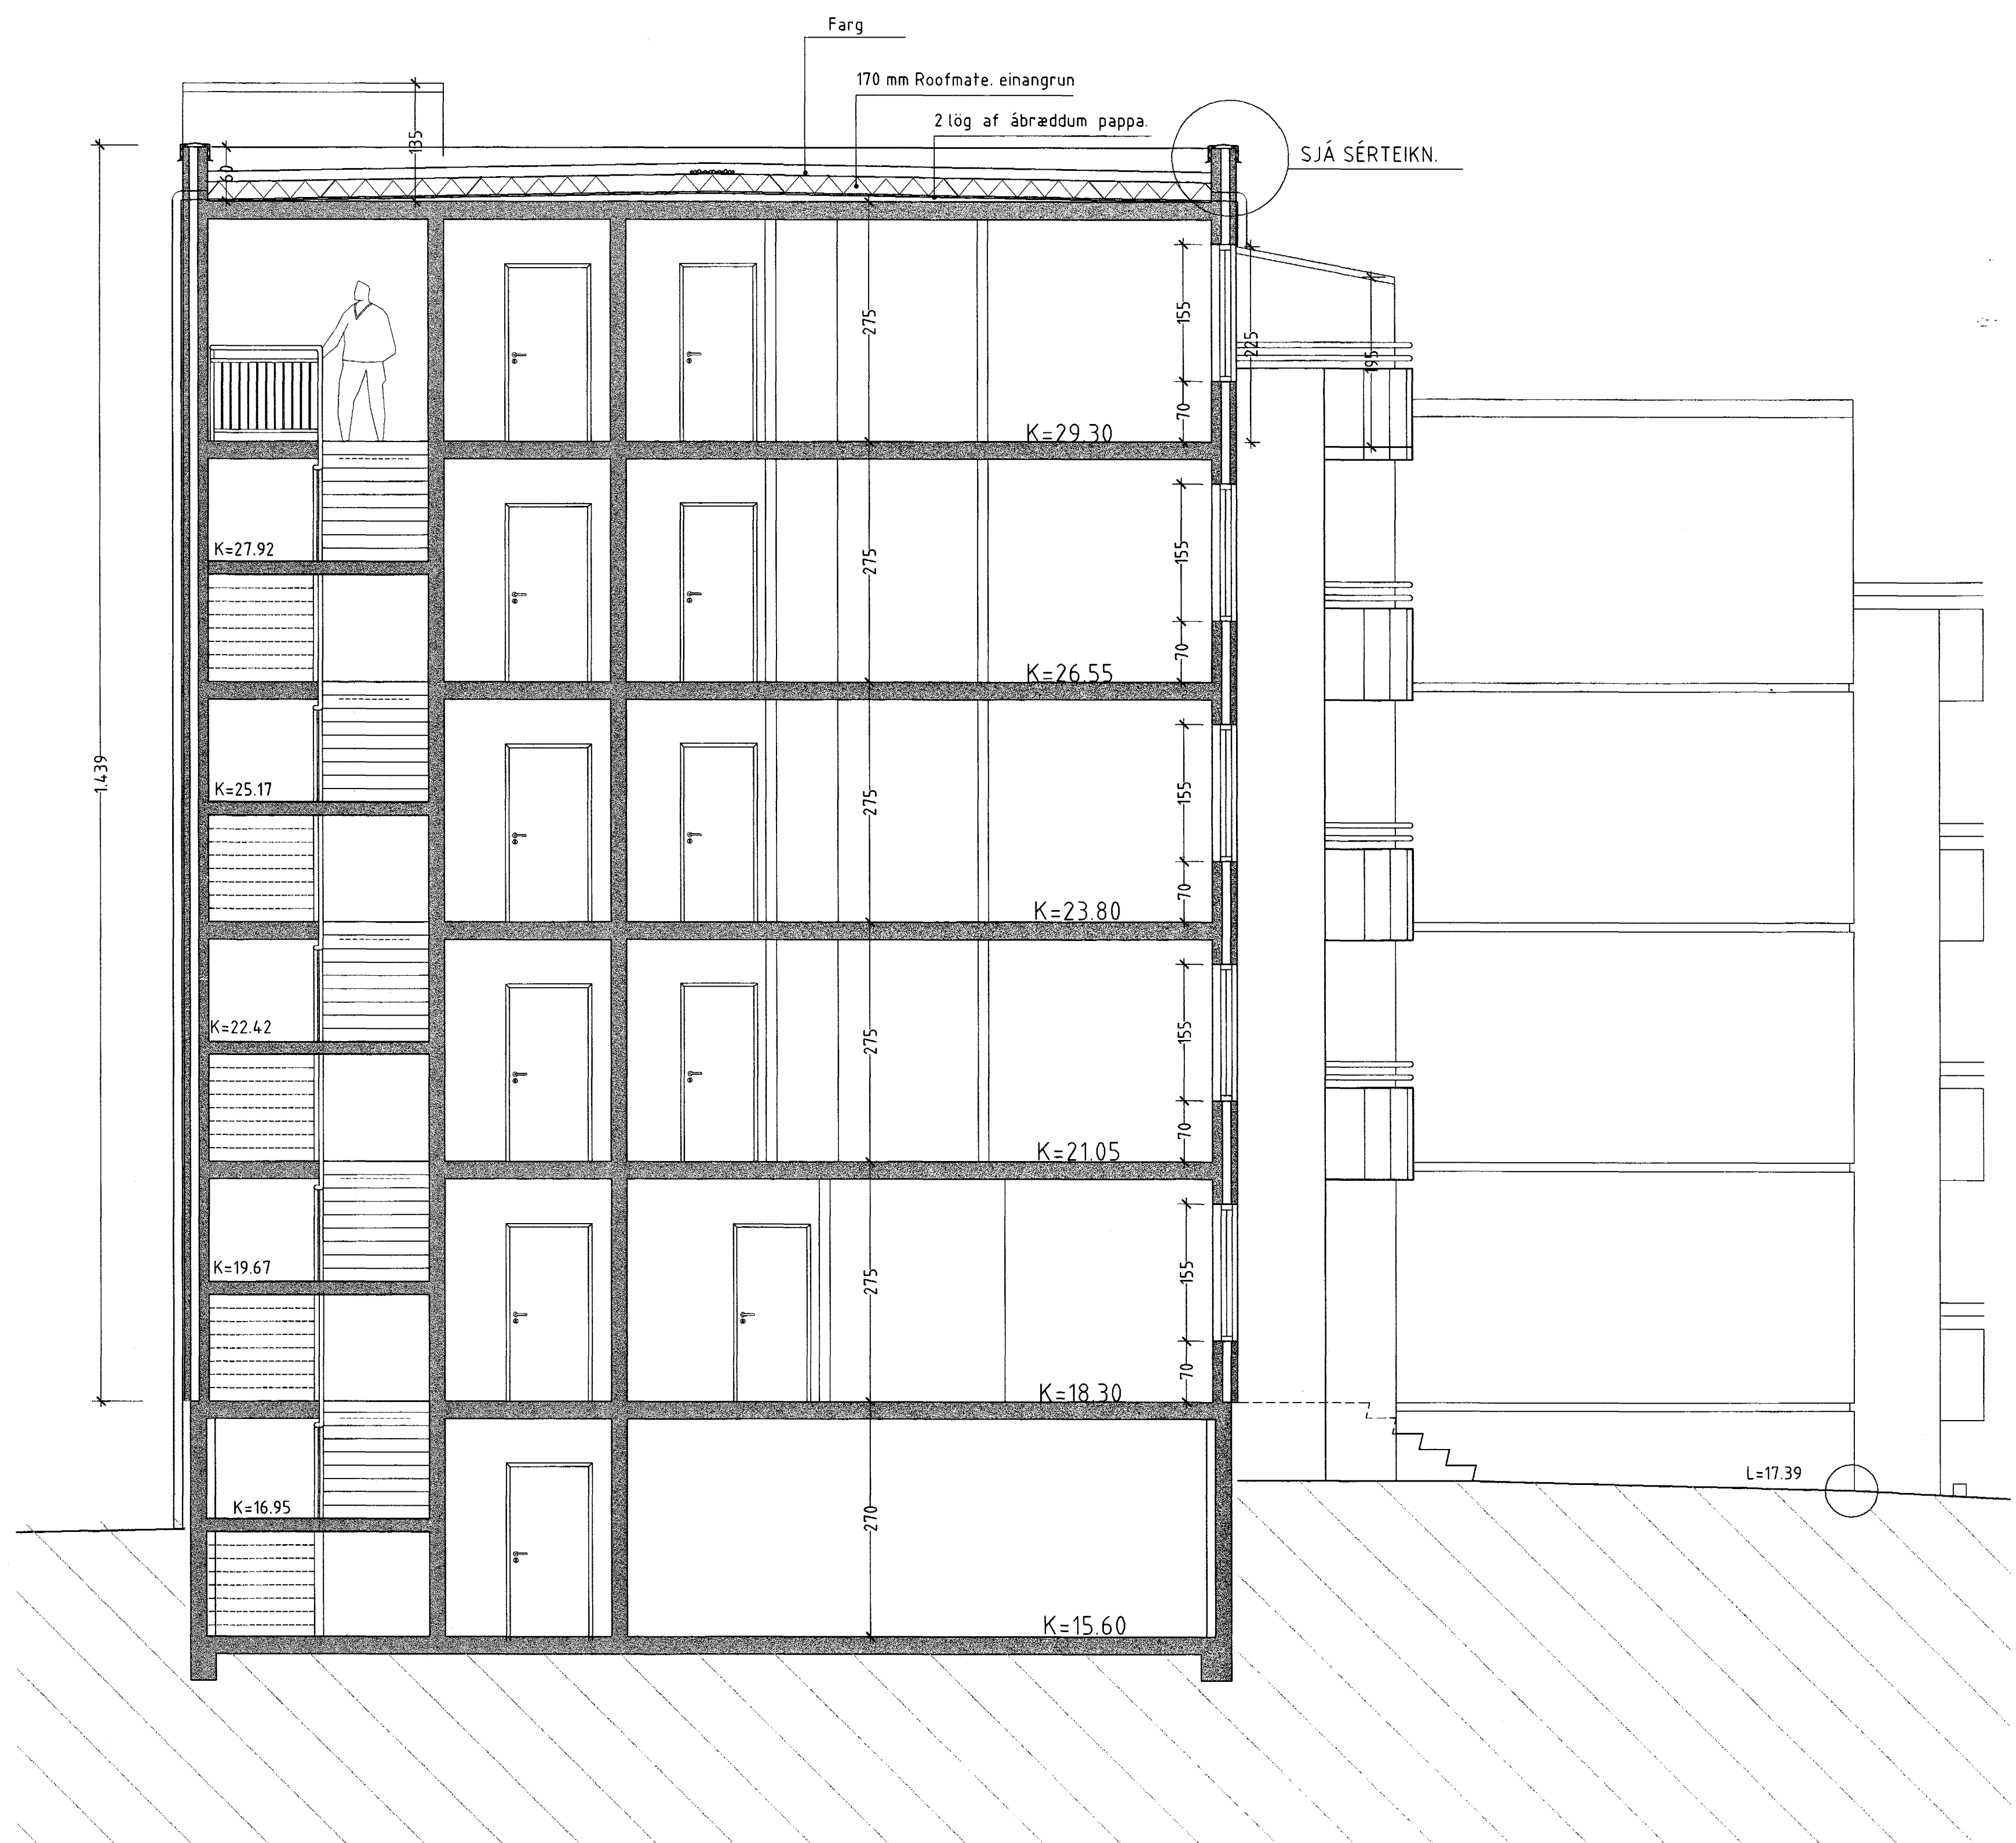

Sneiðing B - B 1: 50

Samþykkt þann  
15 SEPT. 2004  
Byggingafultrúinn / Hafnarfirir  
Fh. Sigurbjartur Halldórsson

25.-08.-2004 : 17 mm "ROOFMATE" einangrun á þak

Berjavellir 6 Hafnarfirði. Sneiðingar.

VERK. NR. 260	DAGS. 25.-2.-2003	MÁL. 150
TEIKN. NR. 205	BREYTT. 25.-8.-2004	

**JÓN GUÐMUNDSSON** ARKITEKT *Jón Guðmundsson*  
VINNUSTOFA SUBURLANDSBRÁUT 16 REYKJAVÍK ÍMÍ 562 5058

Jón Guðmundsson, arkitekt, Suburlandsbraut, 16 26.8.2004, 09:53:00, jg001.dwg