

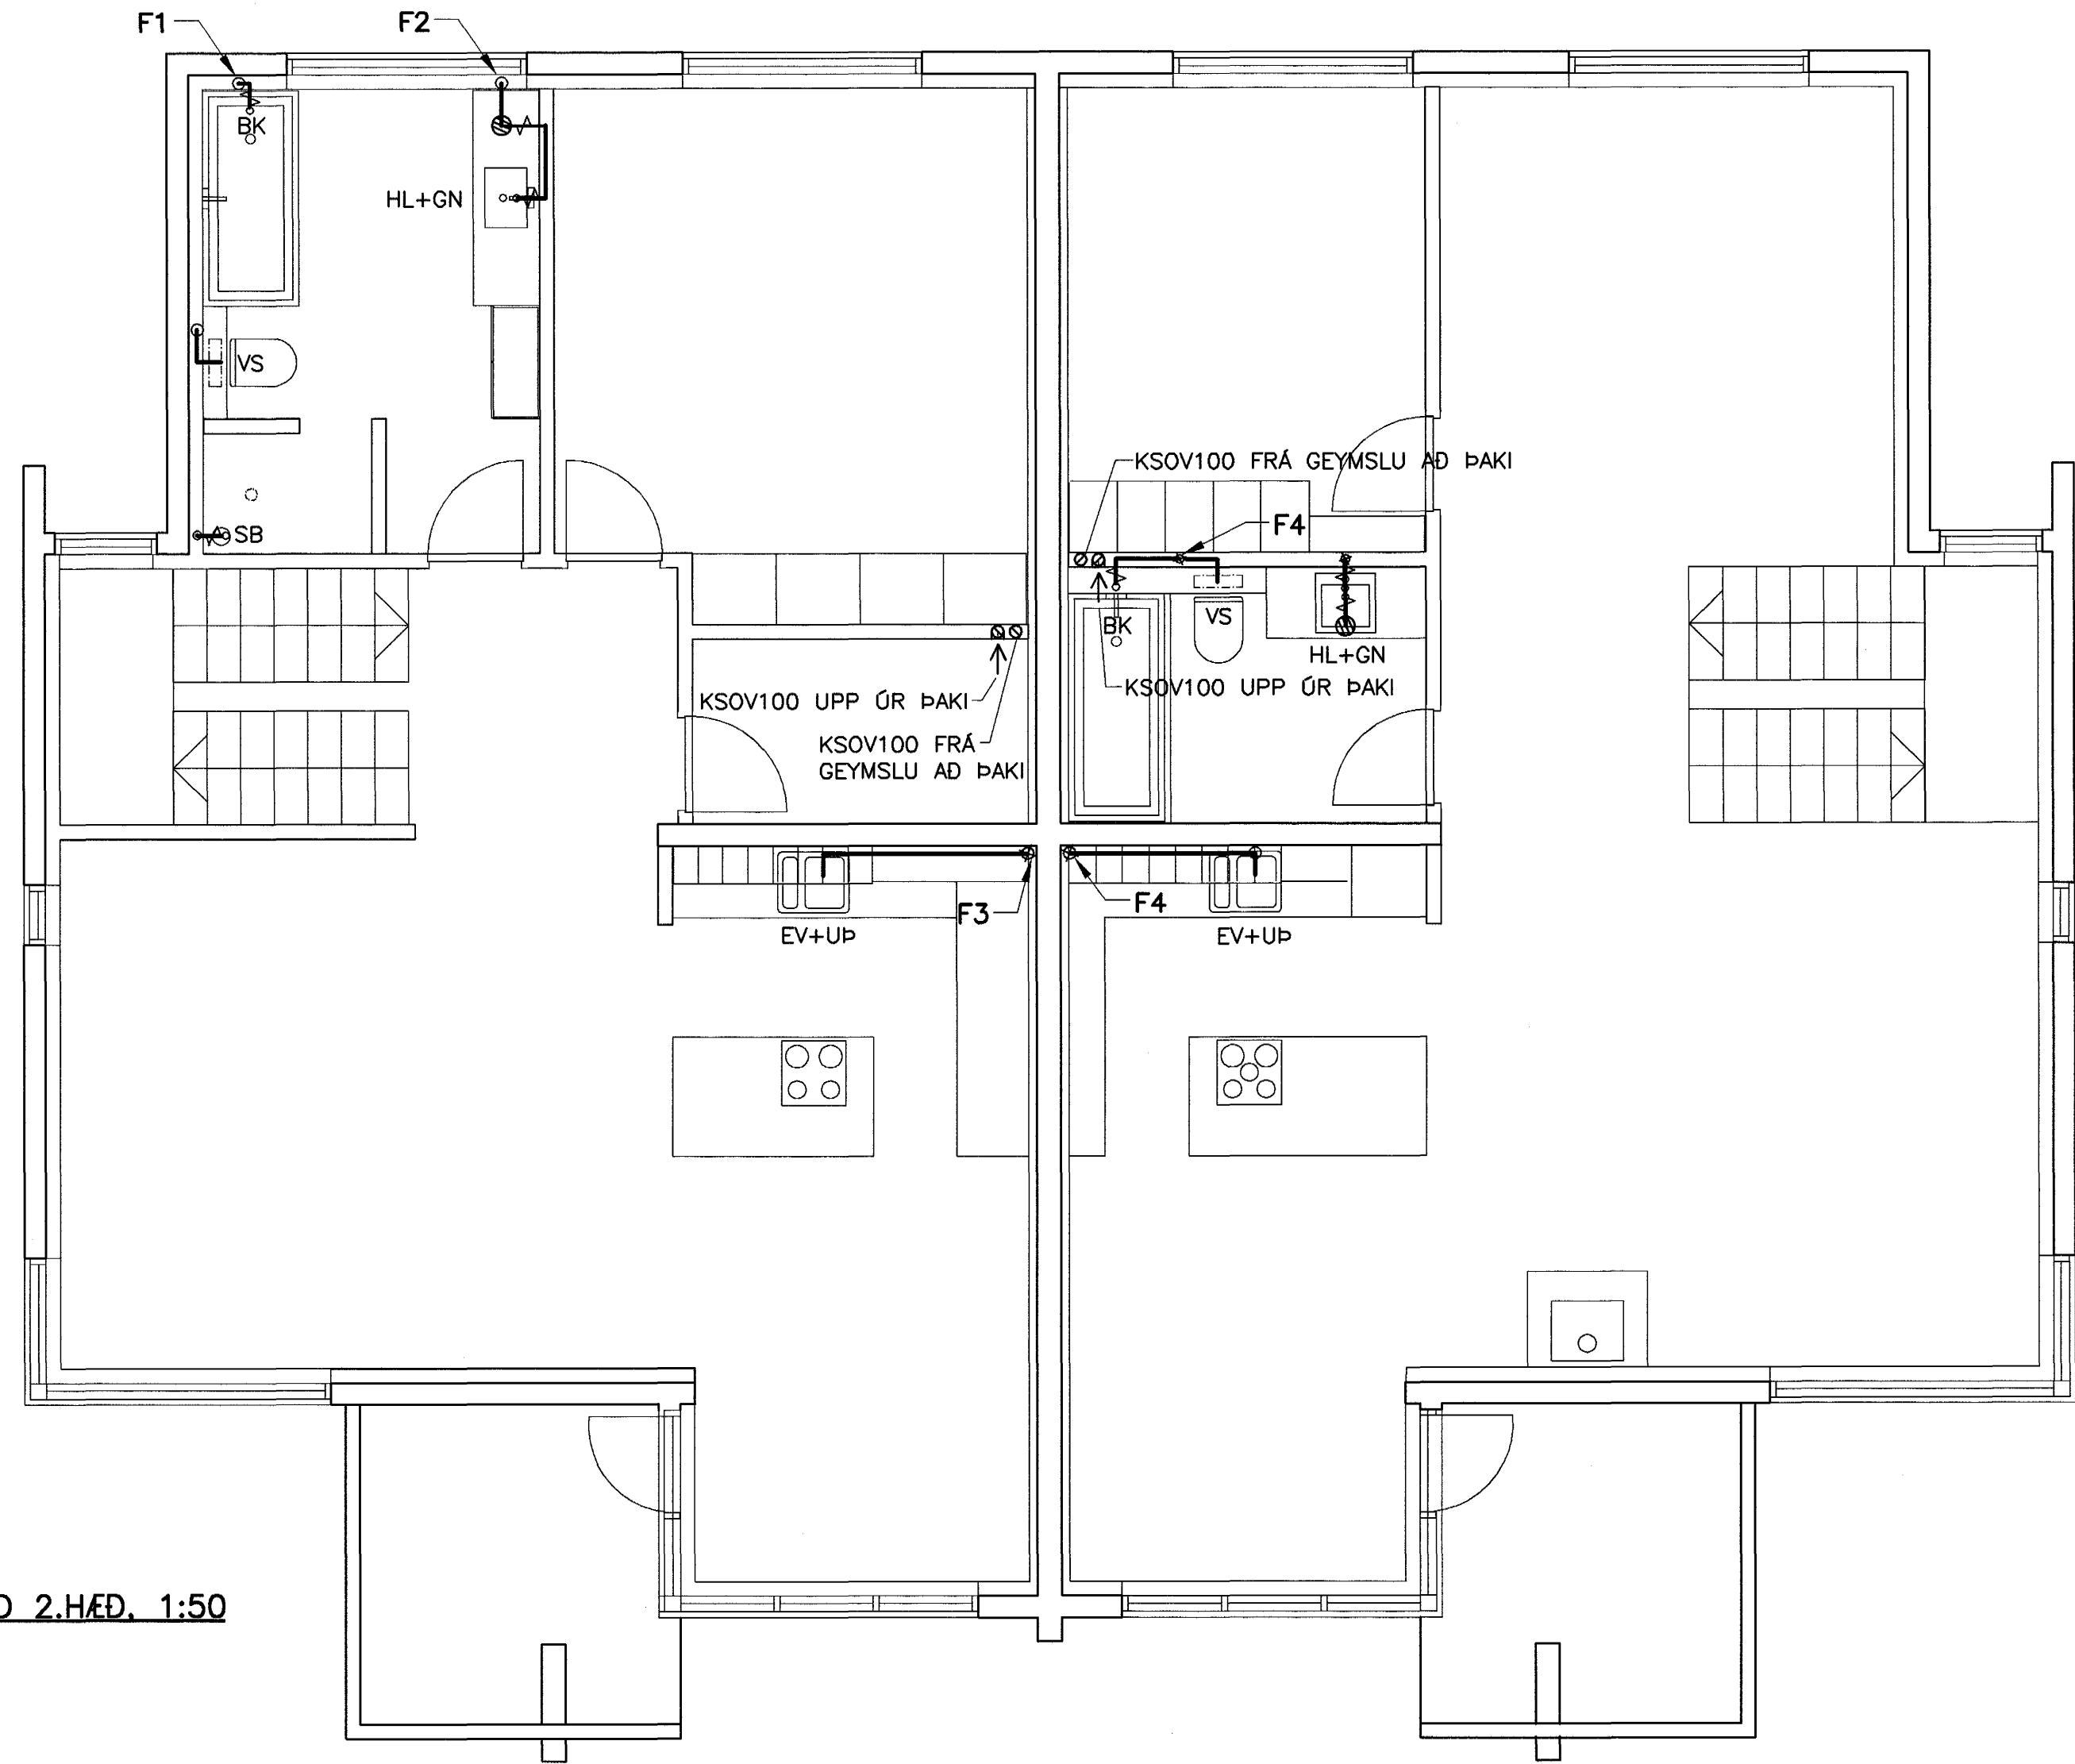




DAGS:	NR:	BREYTINGAR:	SAMB:
04.10.04	△	LÖGNUM BREYTT V/BREYTTS INNRA SKIPULAGS	

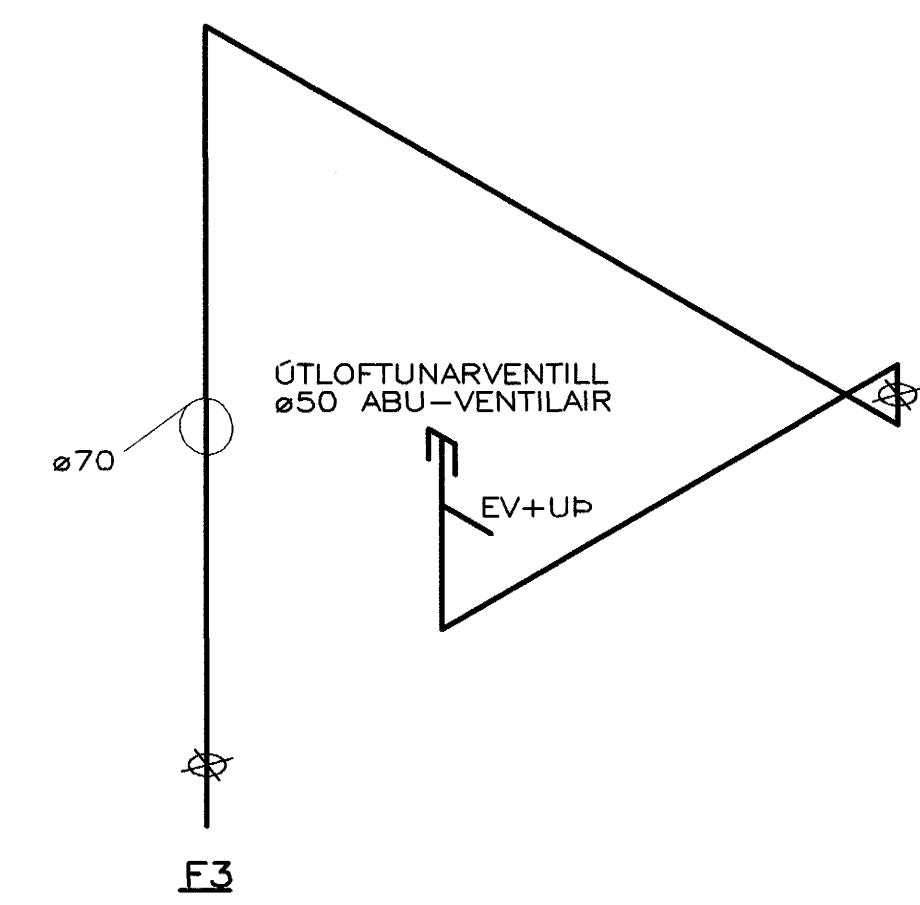

GRUNNMYND 2.HÆD. 1:50

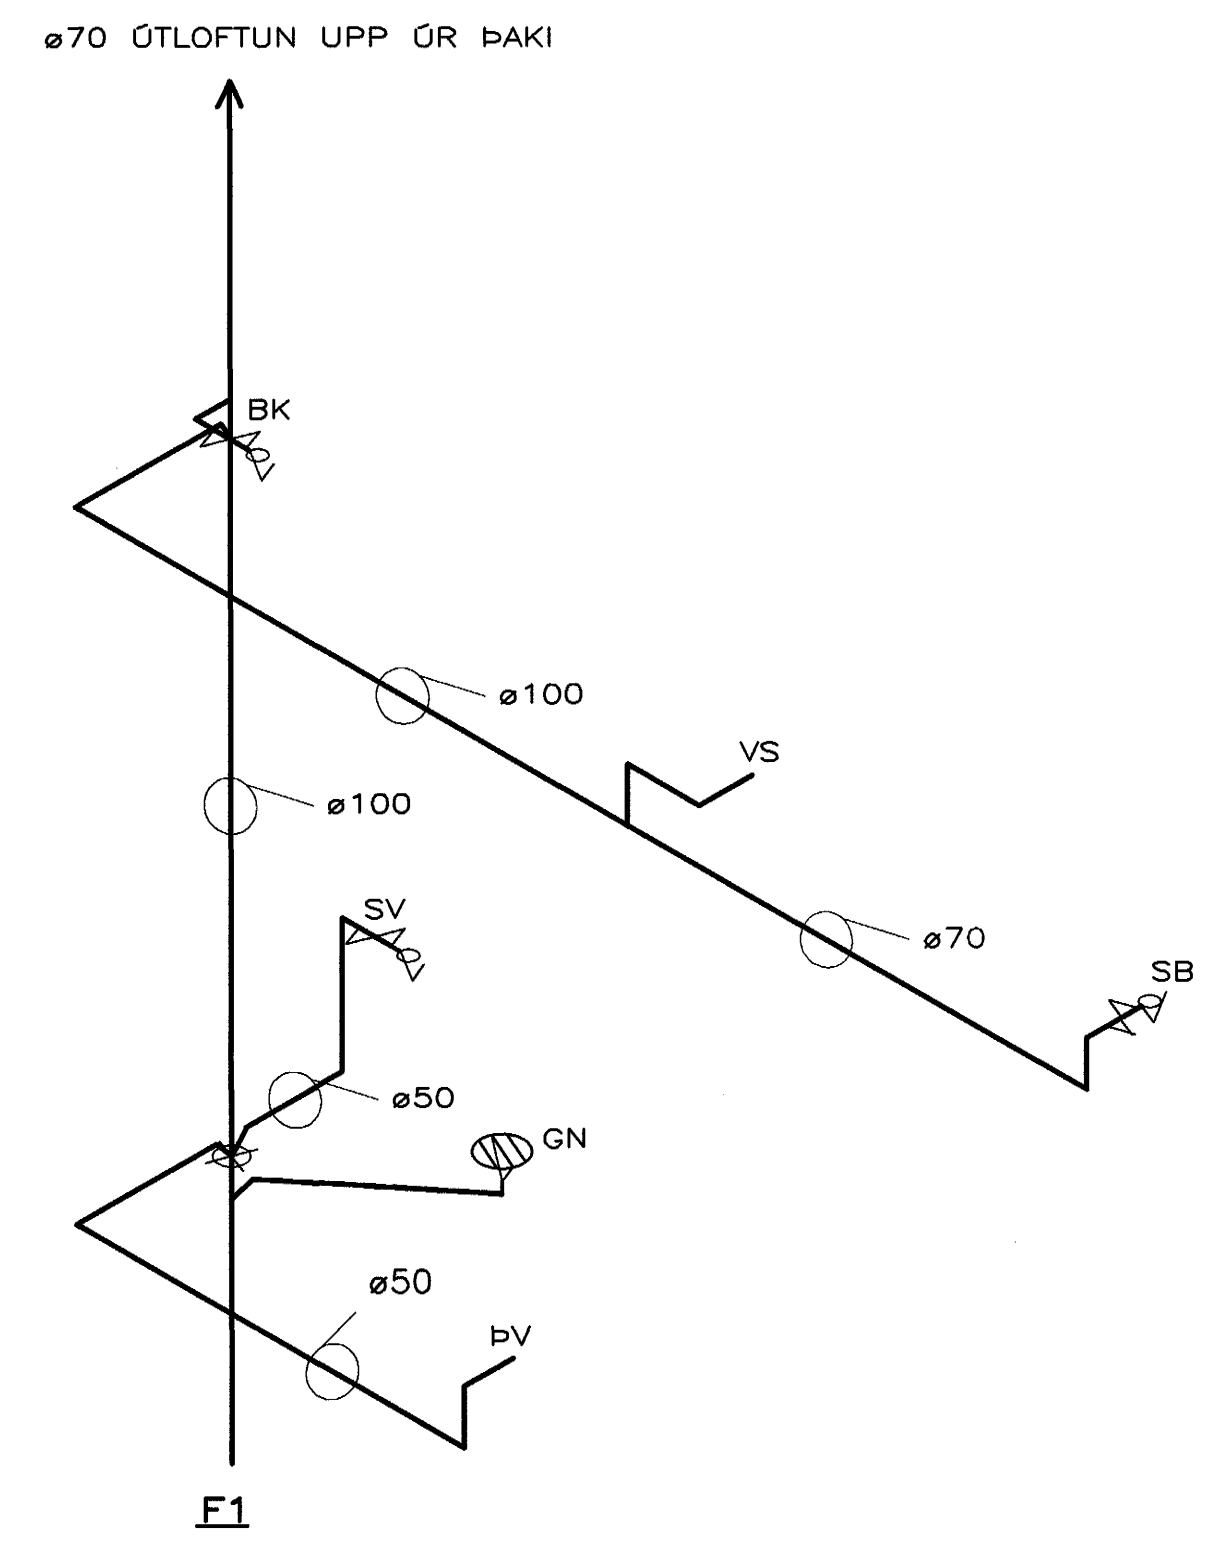

FALLSTAMMAR 1:20

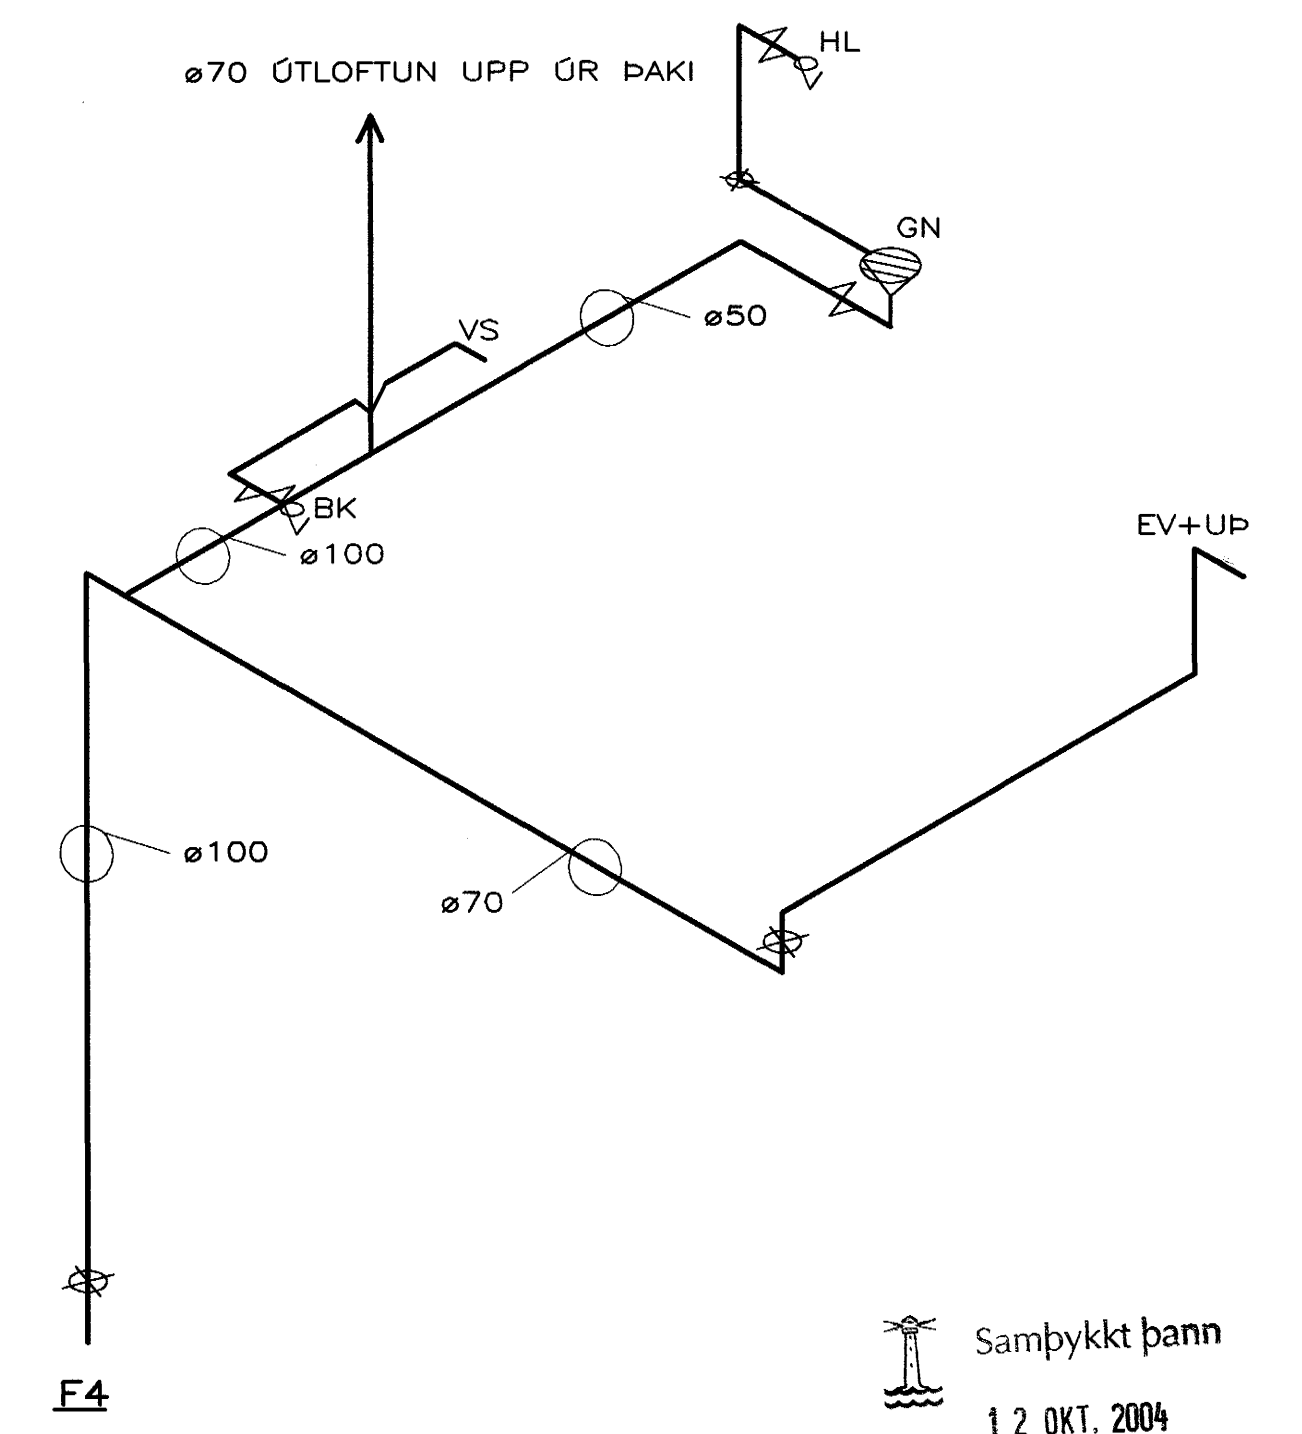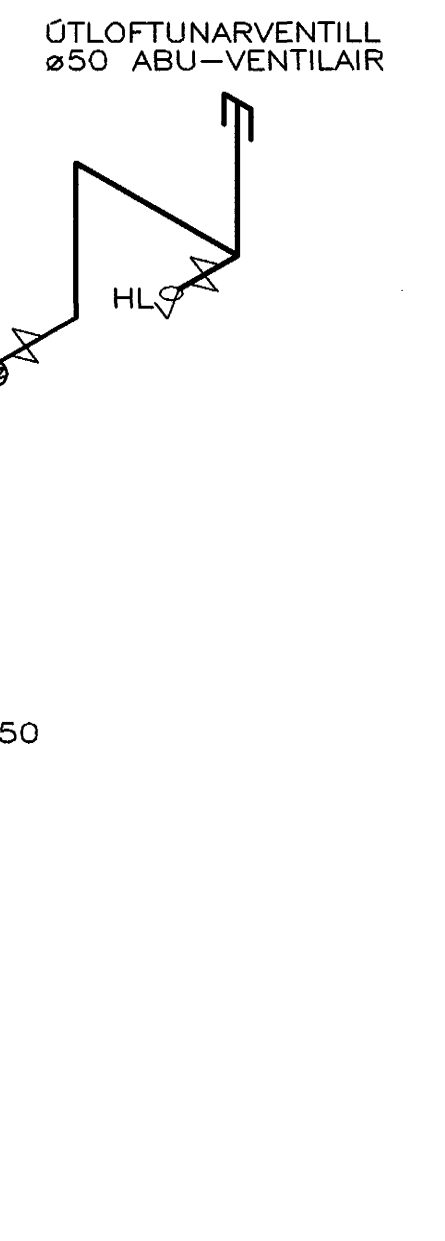

Samþykkt þann
12 OKT. 2004
Byggingafulltrúinn í Hafnarfirði
Eh. Sigurbjartur Halldórsson

Móttaki:
Samb.: 5.10.04

SKÝRINGAR SJÁ TEIKN 311

VERKFRÉÐIÞJÓNUSTAN EHF

DRÖMUR:	04.36	DATE:	
STYPT HÖS		TEIKNINGAR:	321
FRÁVEITU- OG LOFTREISIKERFI	Jón Guðmundsson 280255-4329	DRÖMUR:	L2
2.HÆD GRUNNMYND OG FALLSTAMMAR		SKÝRINGAR:	321

0 1000 2000 3000 4000 5000
1:50 mm