

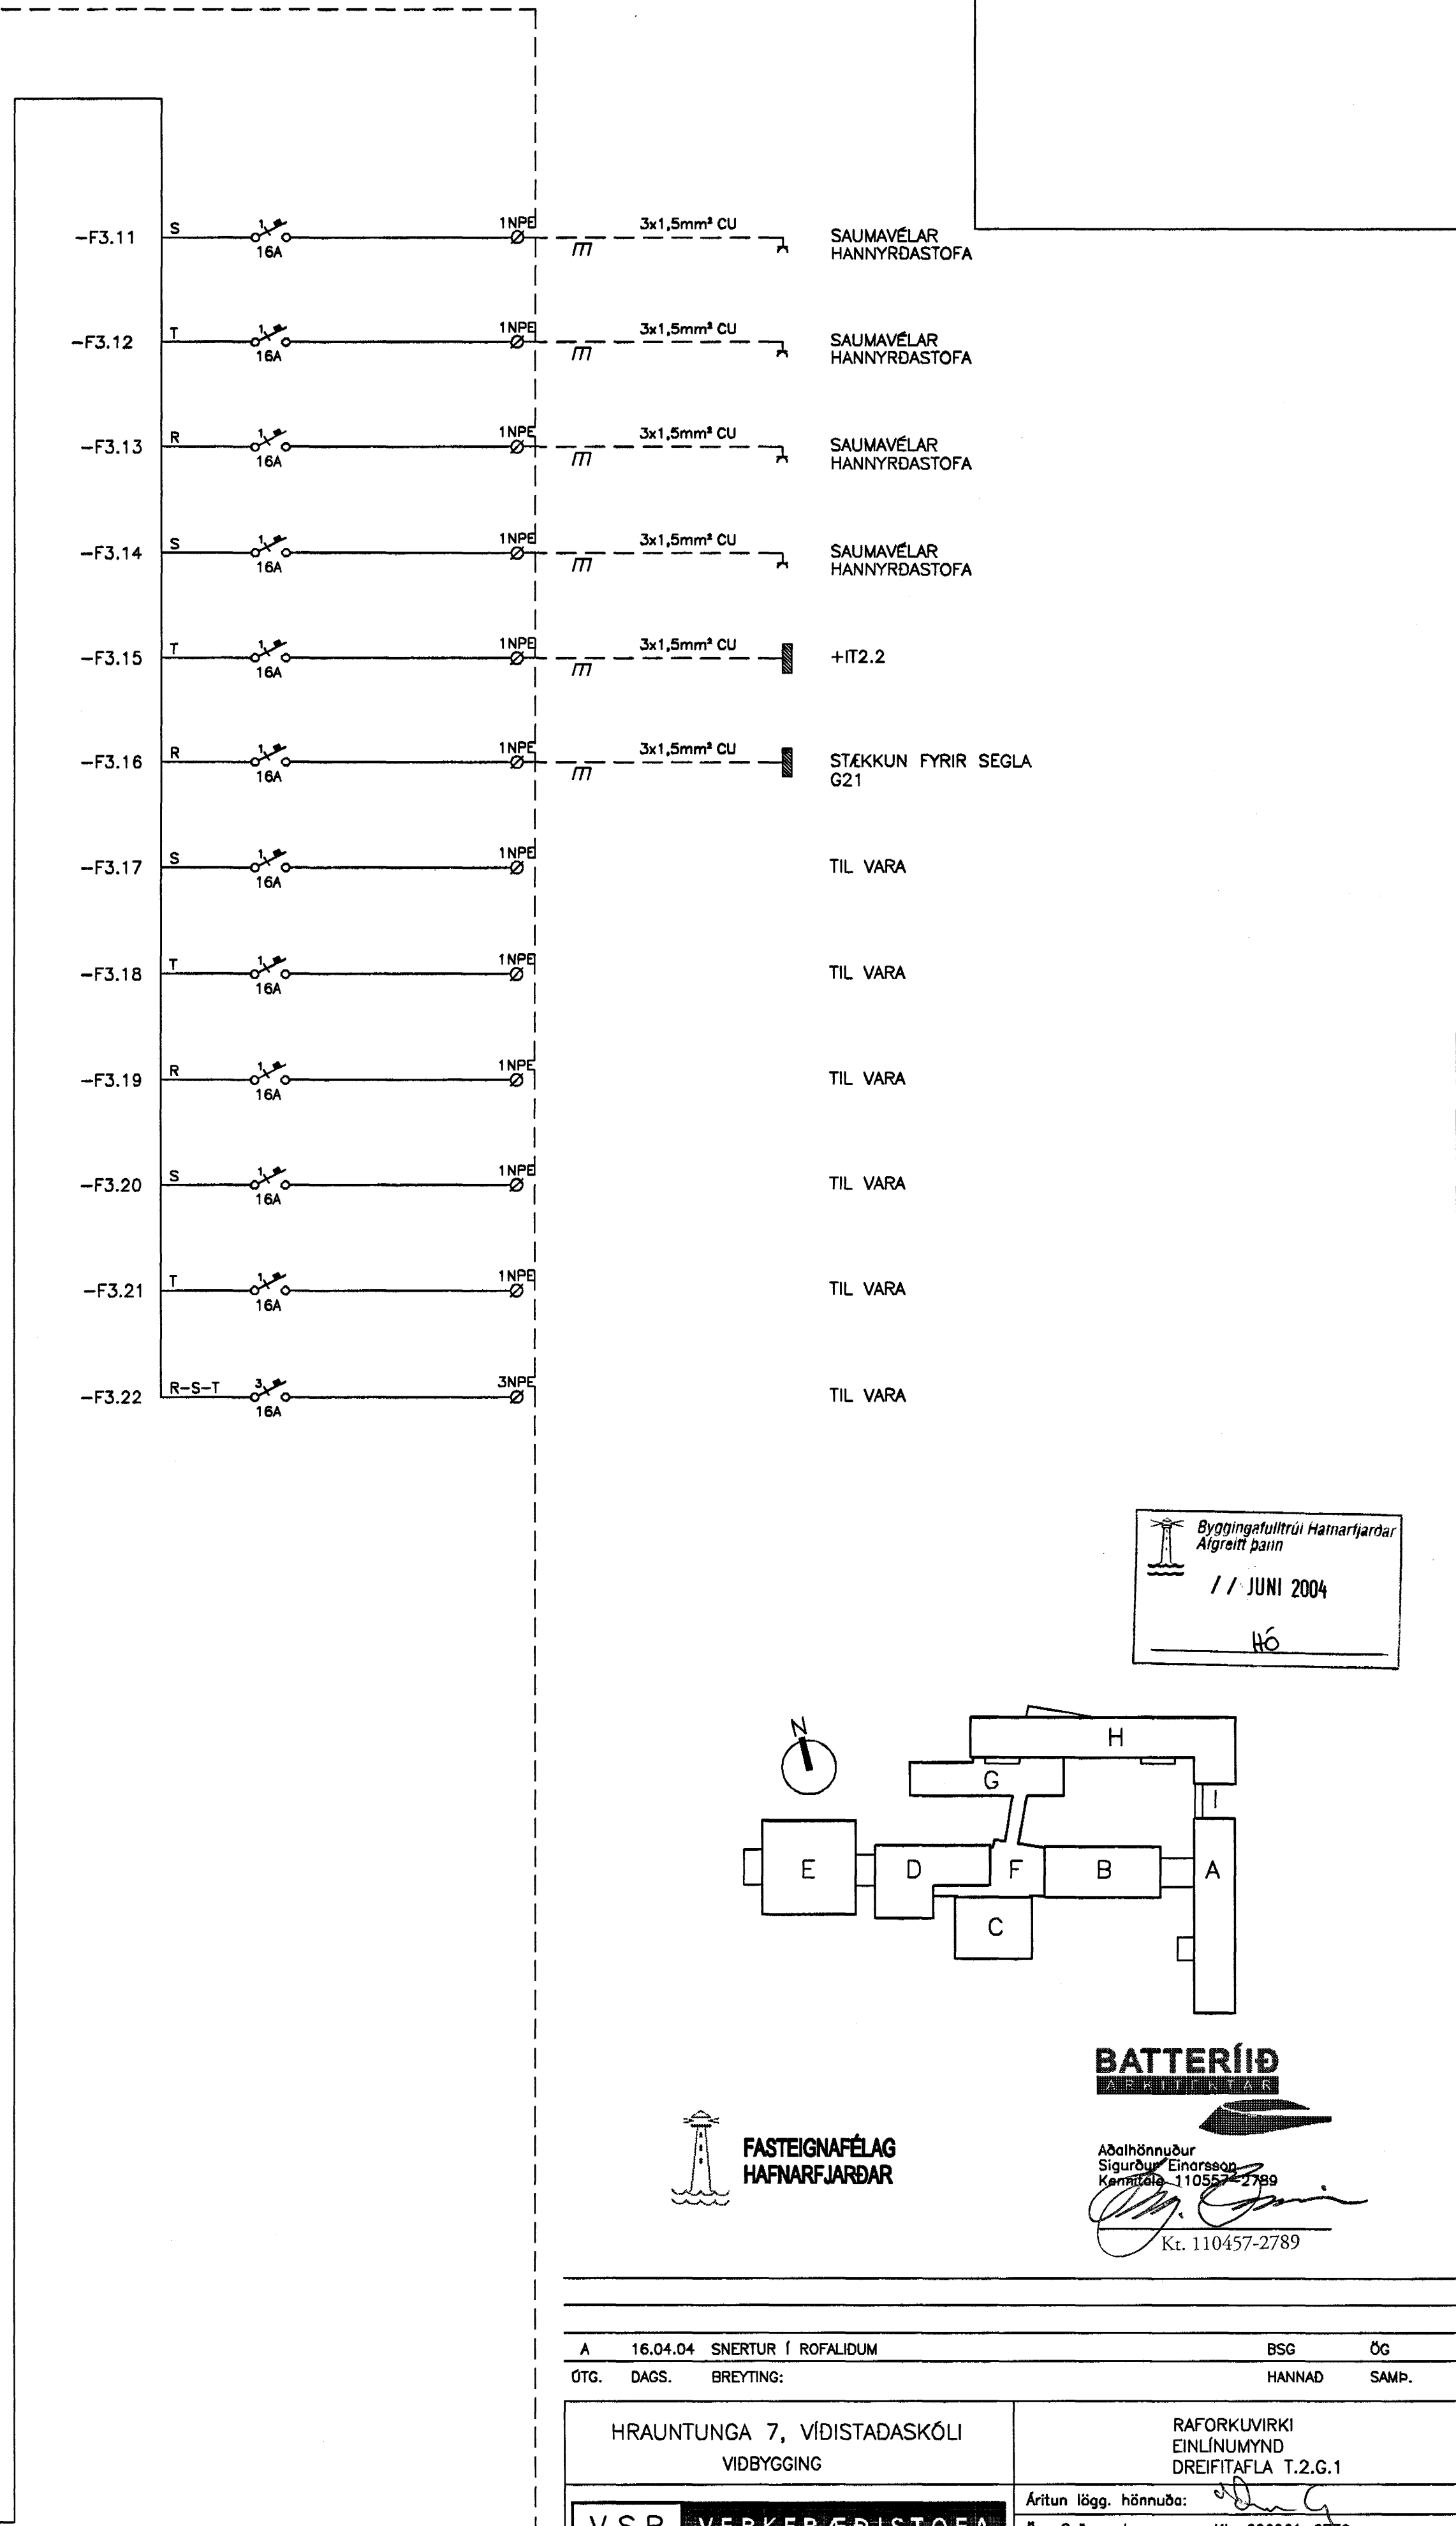
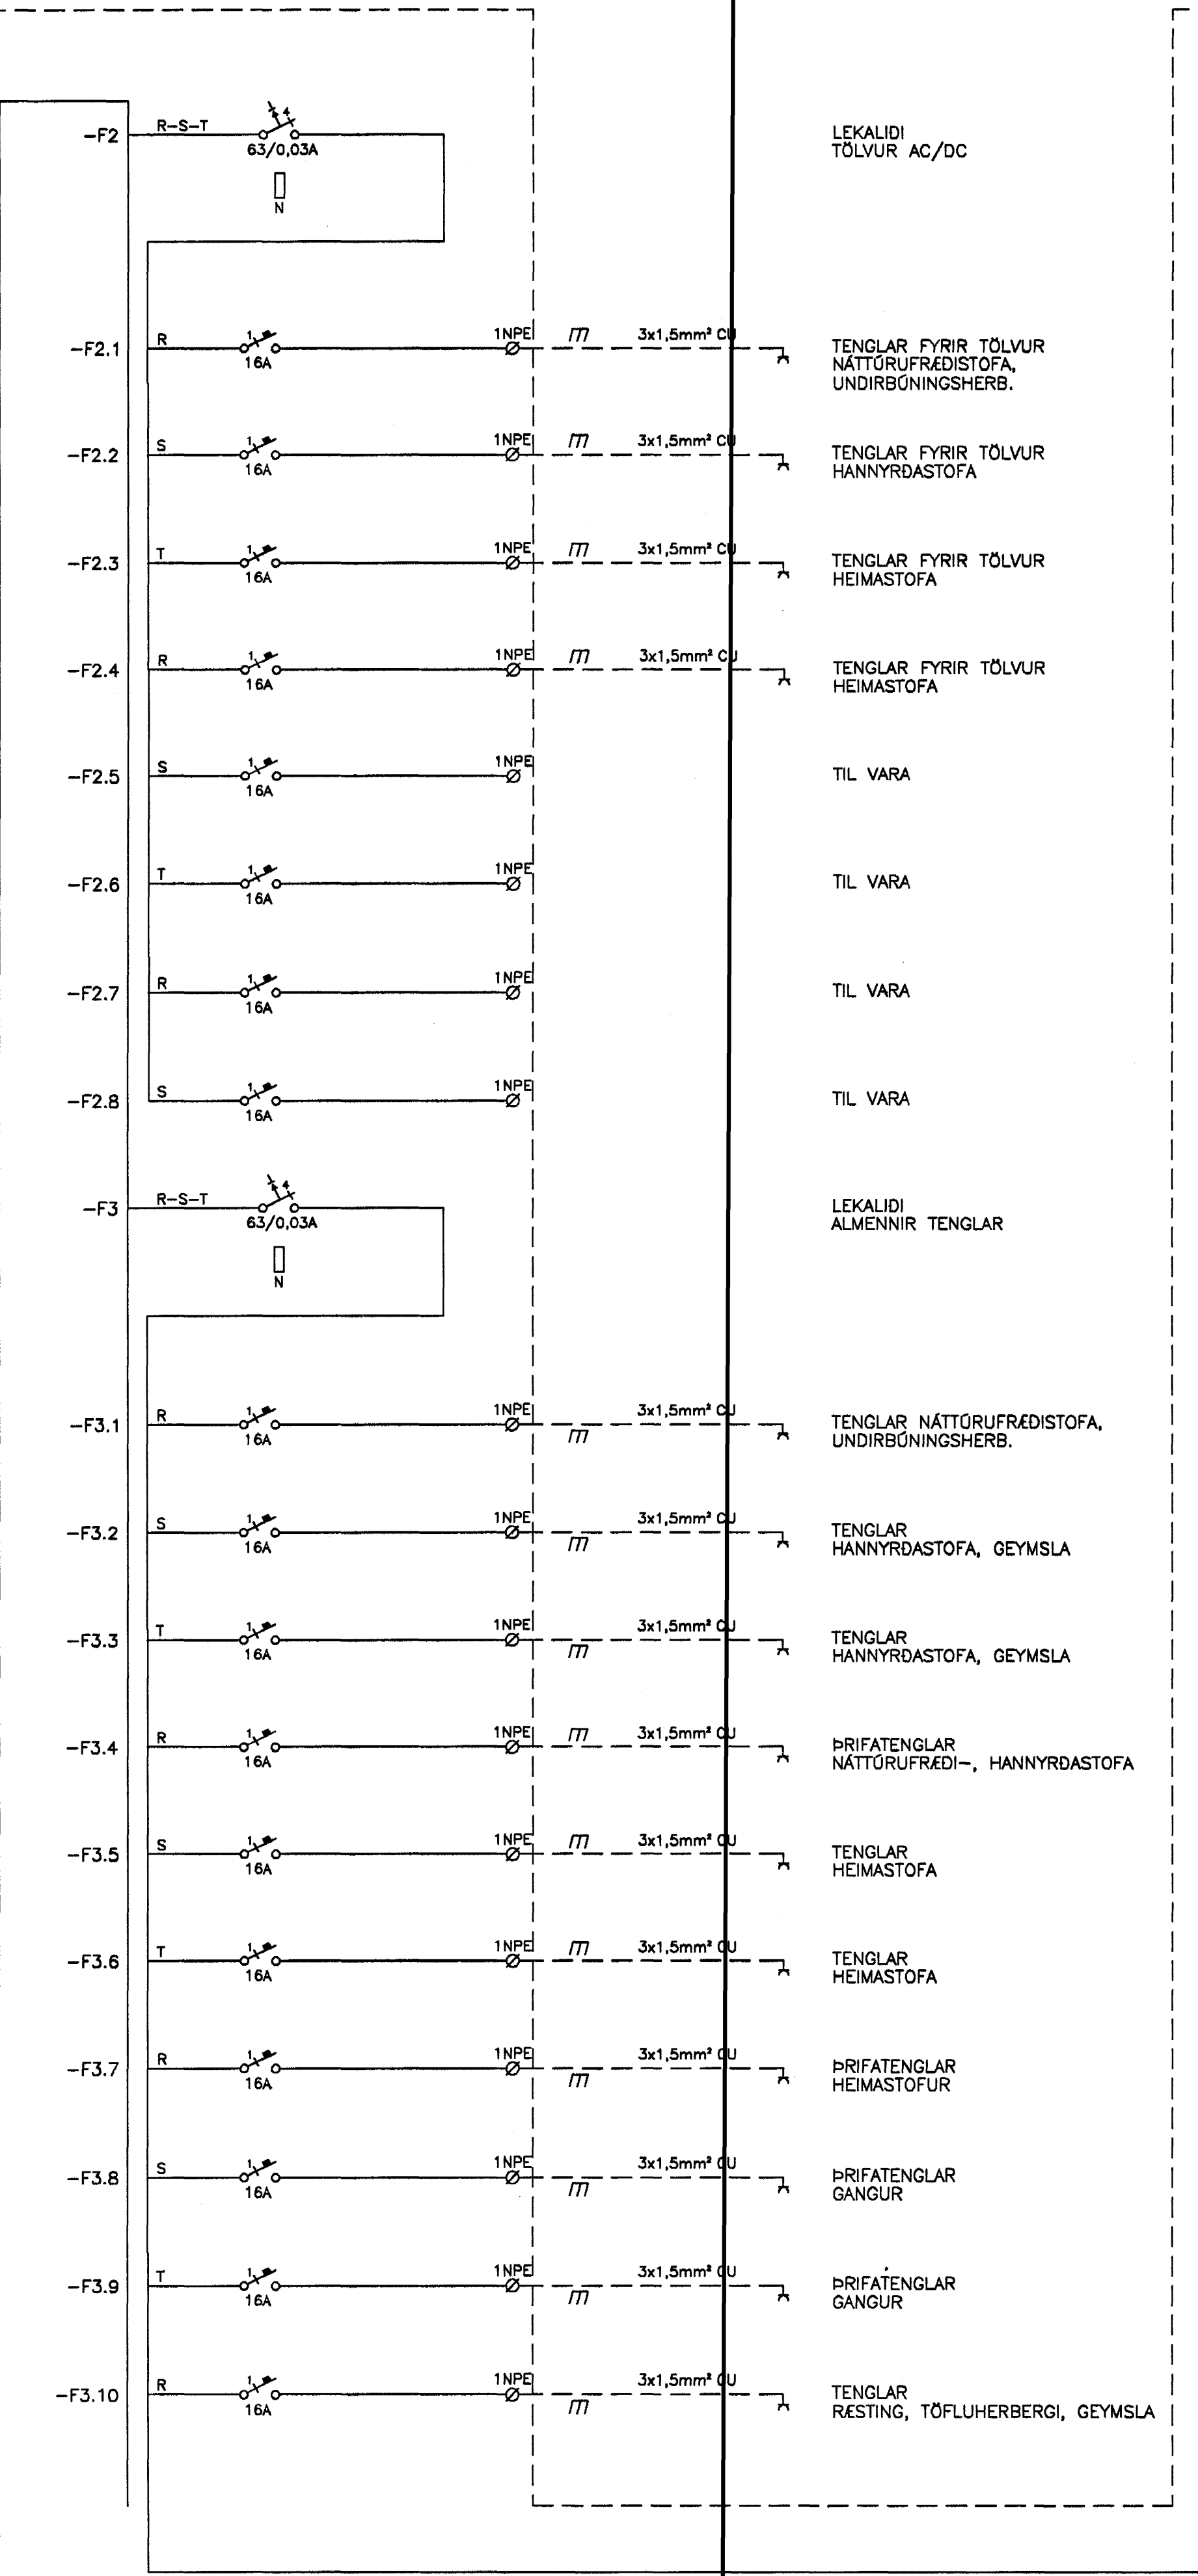


TAFLA T.2.G.1

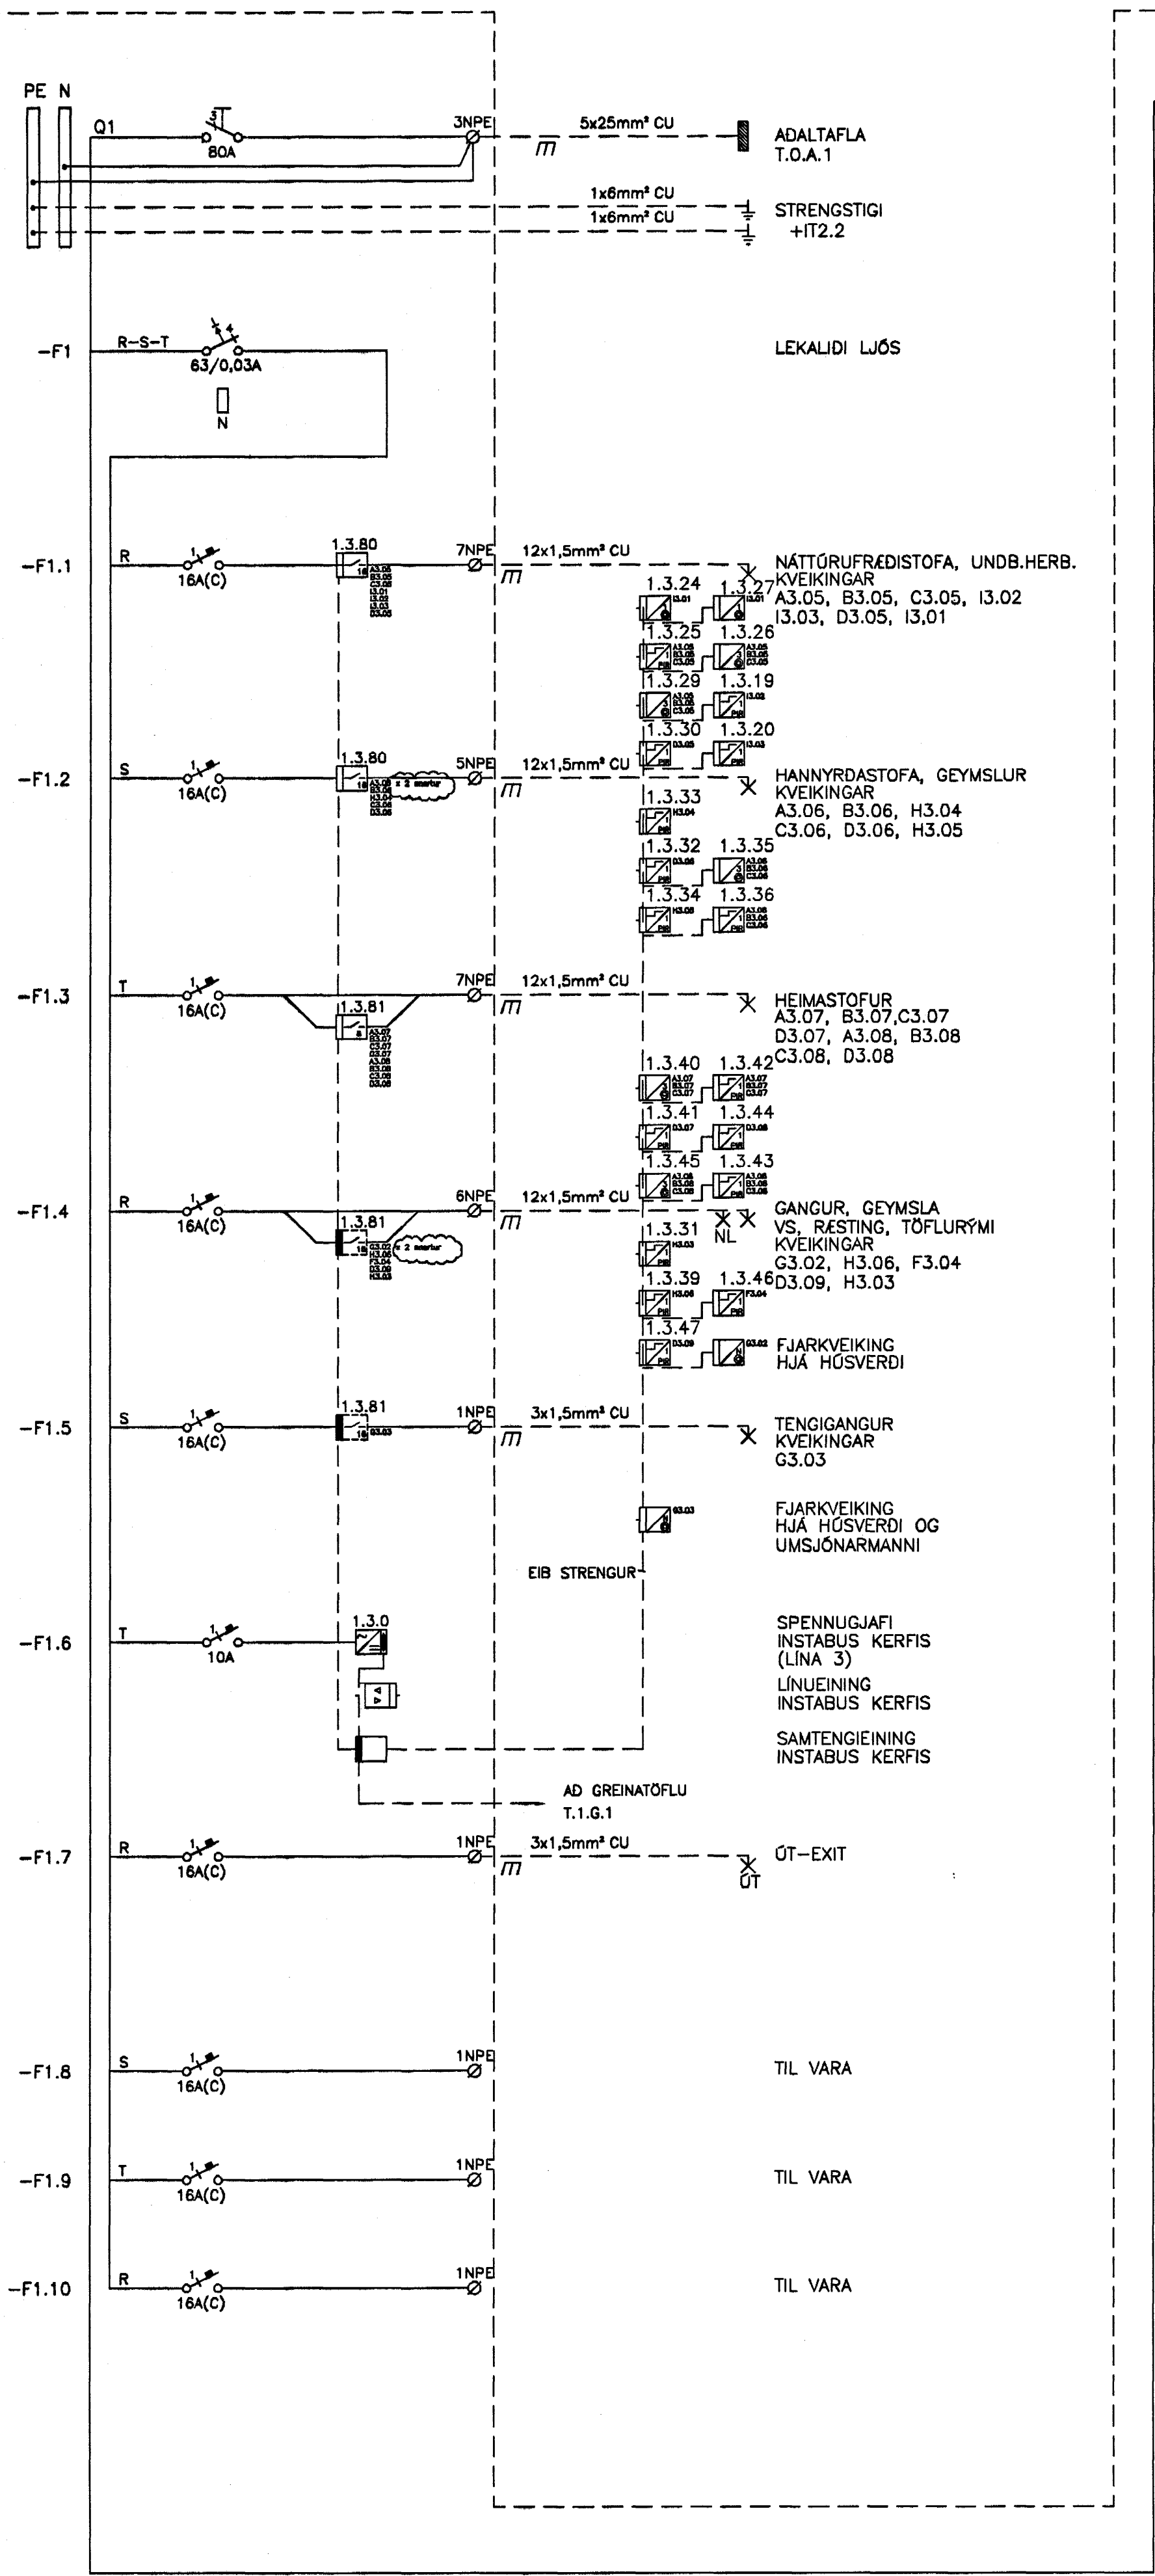

Algreitt þann
// JUNI 2004
HG

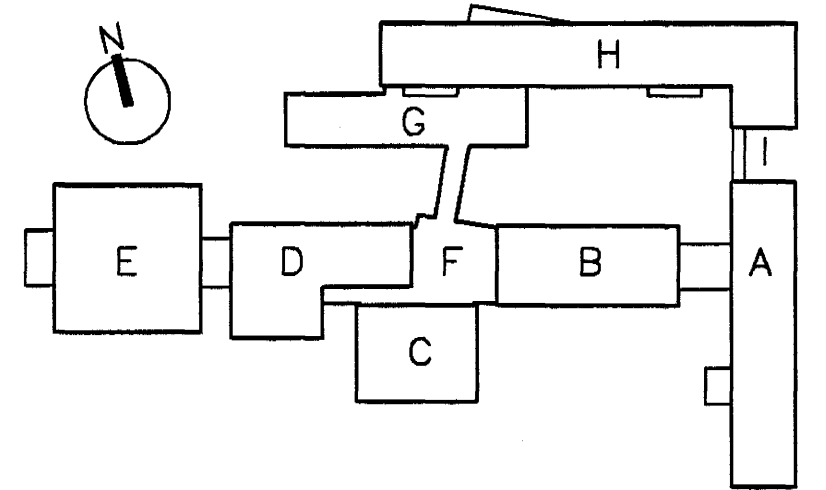

FASTEIGNAFÉLAG HAFNARFJARÐAR

BATTERÍÐ

Kennitala: 110557-2789
Kt. 110457-2789

A	16.04.04	SNERTUR Í ROFALIDUM	BSG	ÖG
ÖTG.	DAGS.	BREYTING:	HANNAÐ	SAMP.
VSB VERKFRÆÐISTOFA		Áritun lögg. hönnuða: Örn Guðmundsson Kt.: 220961-2739		
BEIARHVALNI 20*220 HAFNARFJÖRDUR Helmstaða: www.vsb.is • Netfang: vsb@vab.is Sími 585-8600 Fax 585-8610 • Kt. 710796-2889		Hannað: BSG	Teiknað: BSG	
FRV		Mál: 1:50	Yfirfarið:	
		Dags:	Nr: 02830-R02B-A	