

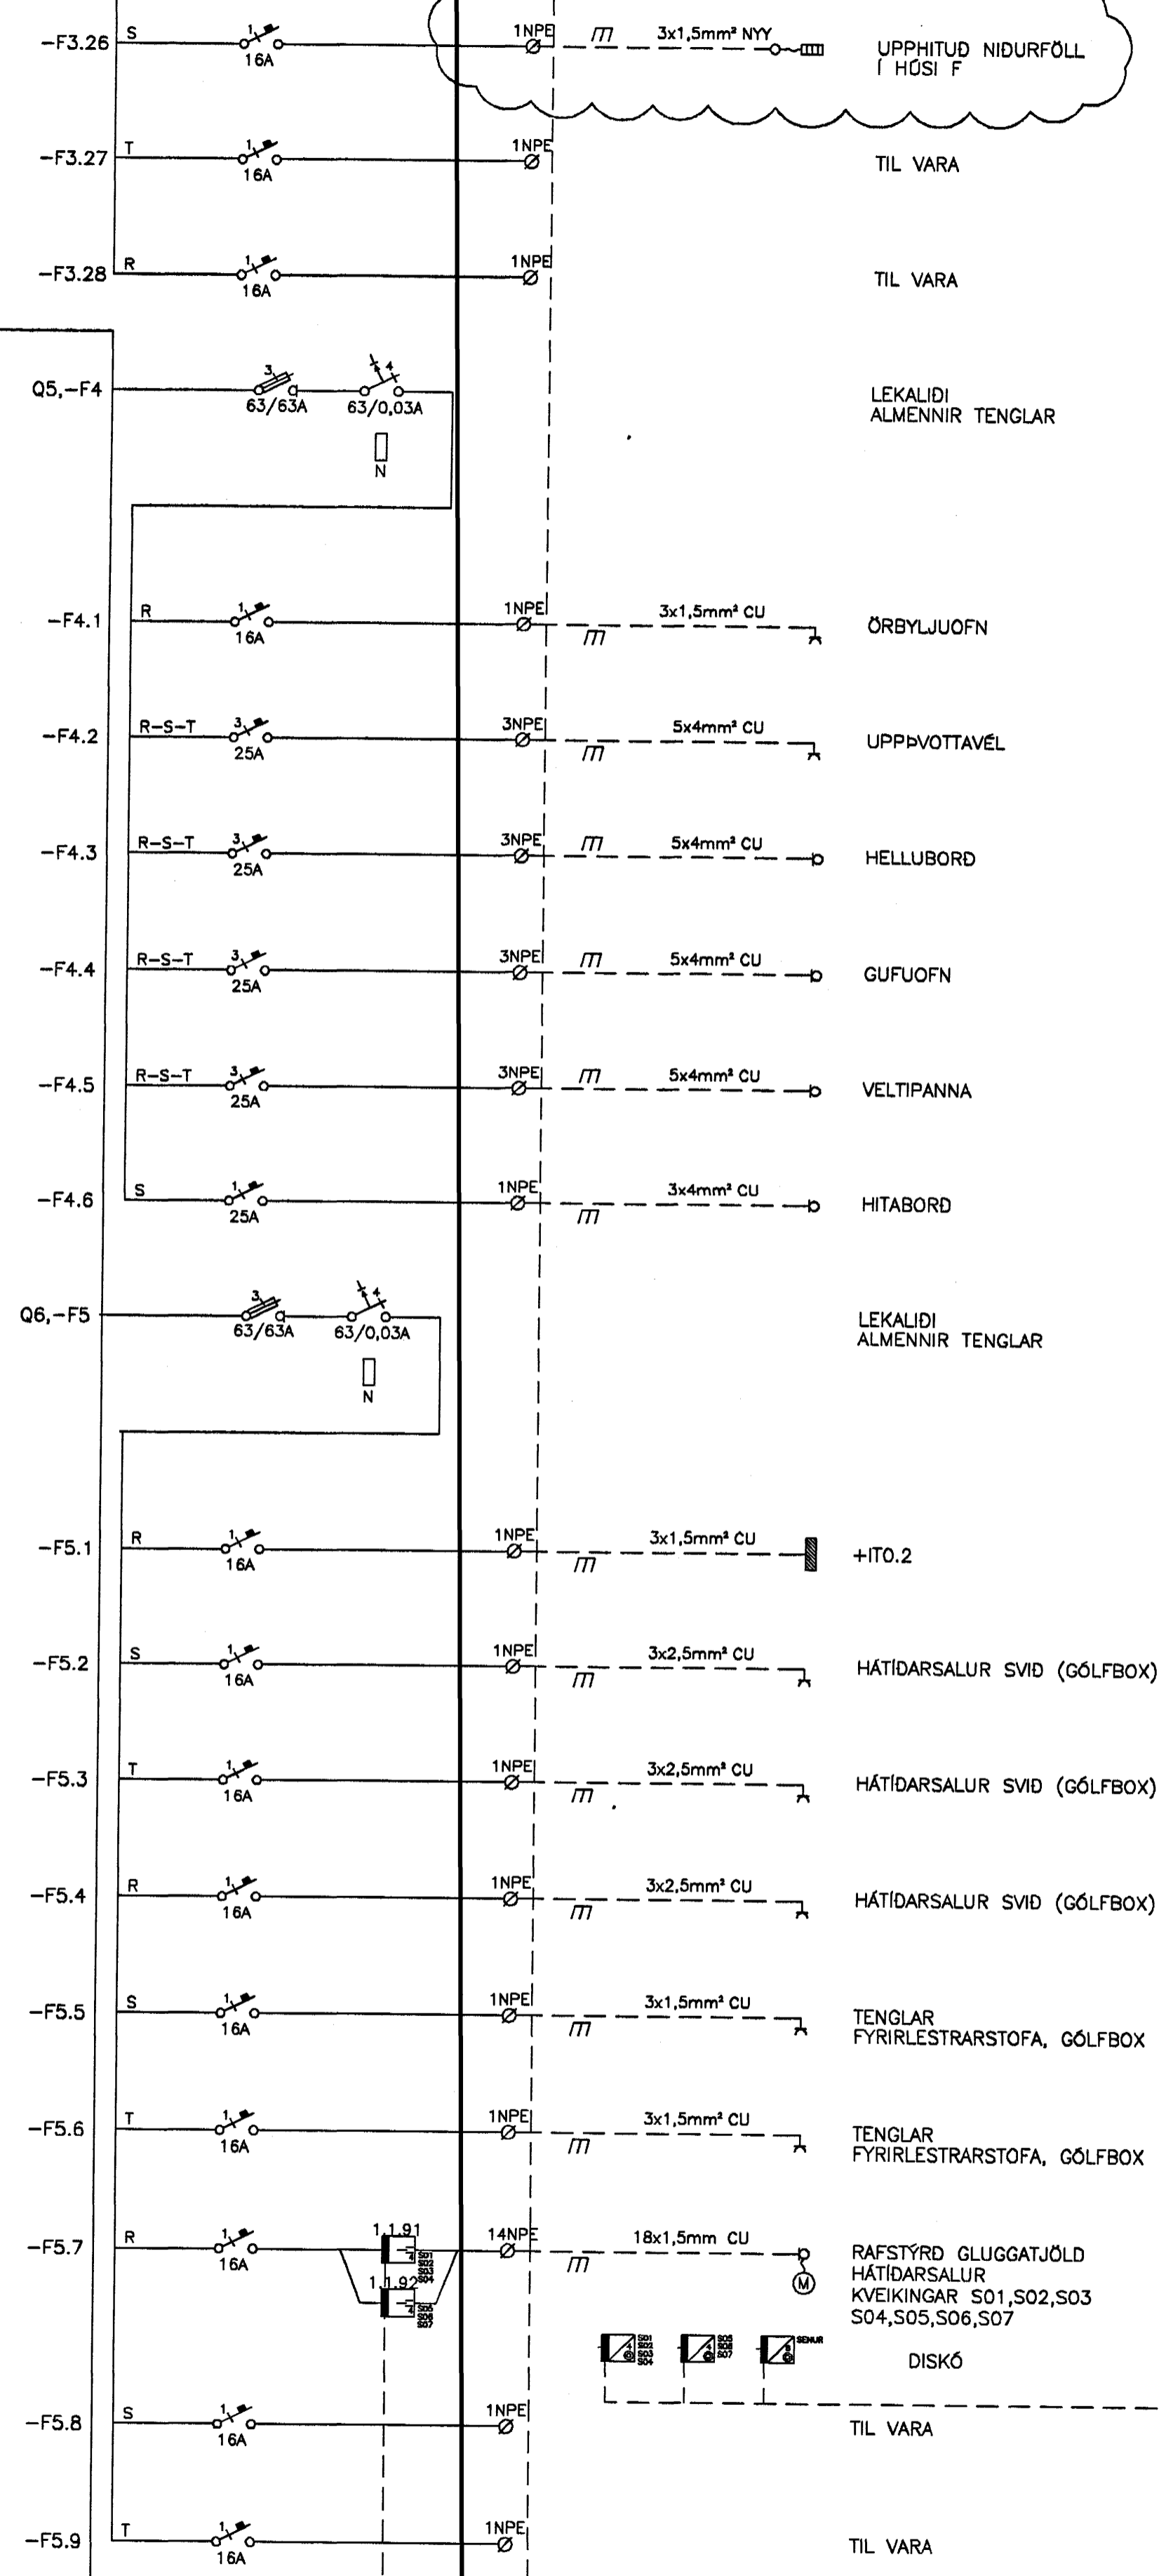


TAFLA T.O.G.1

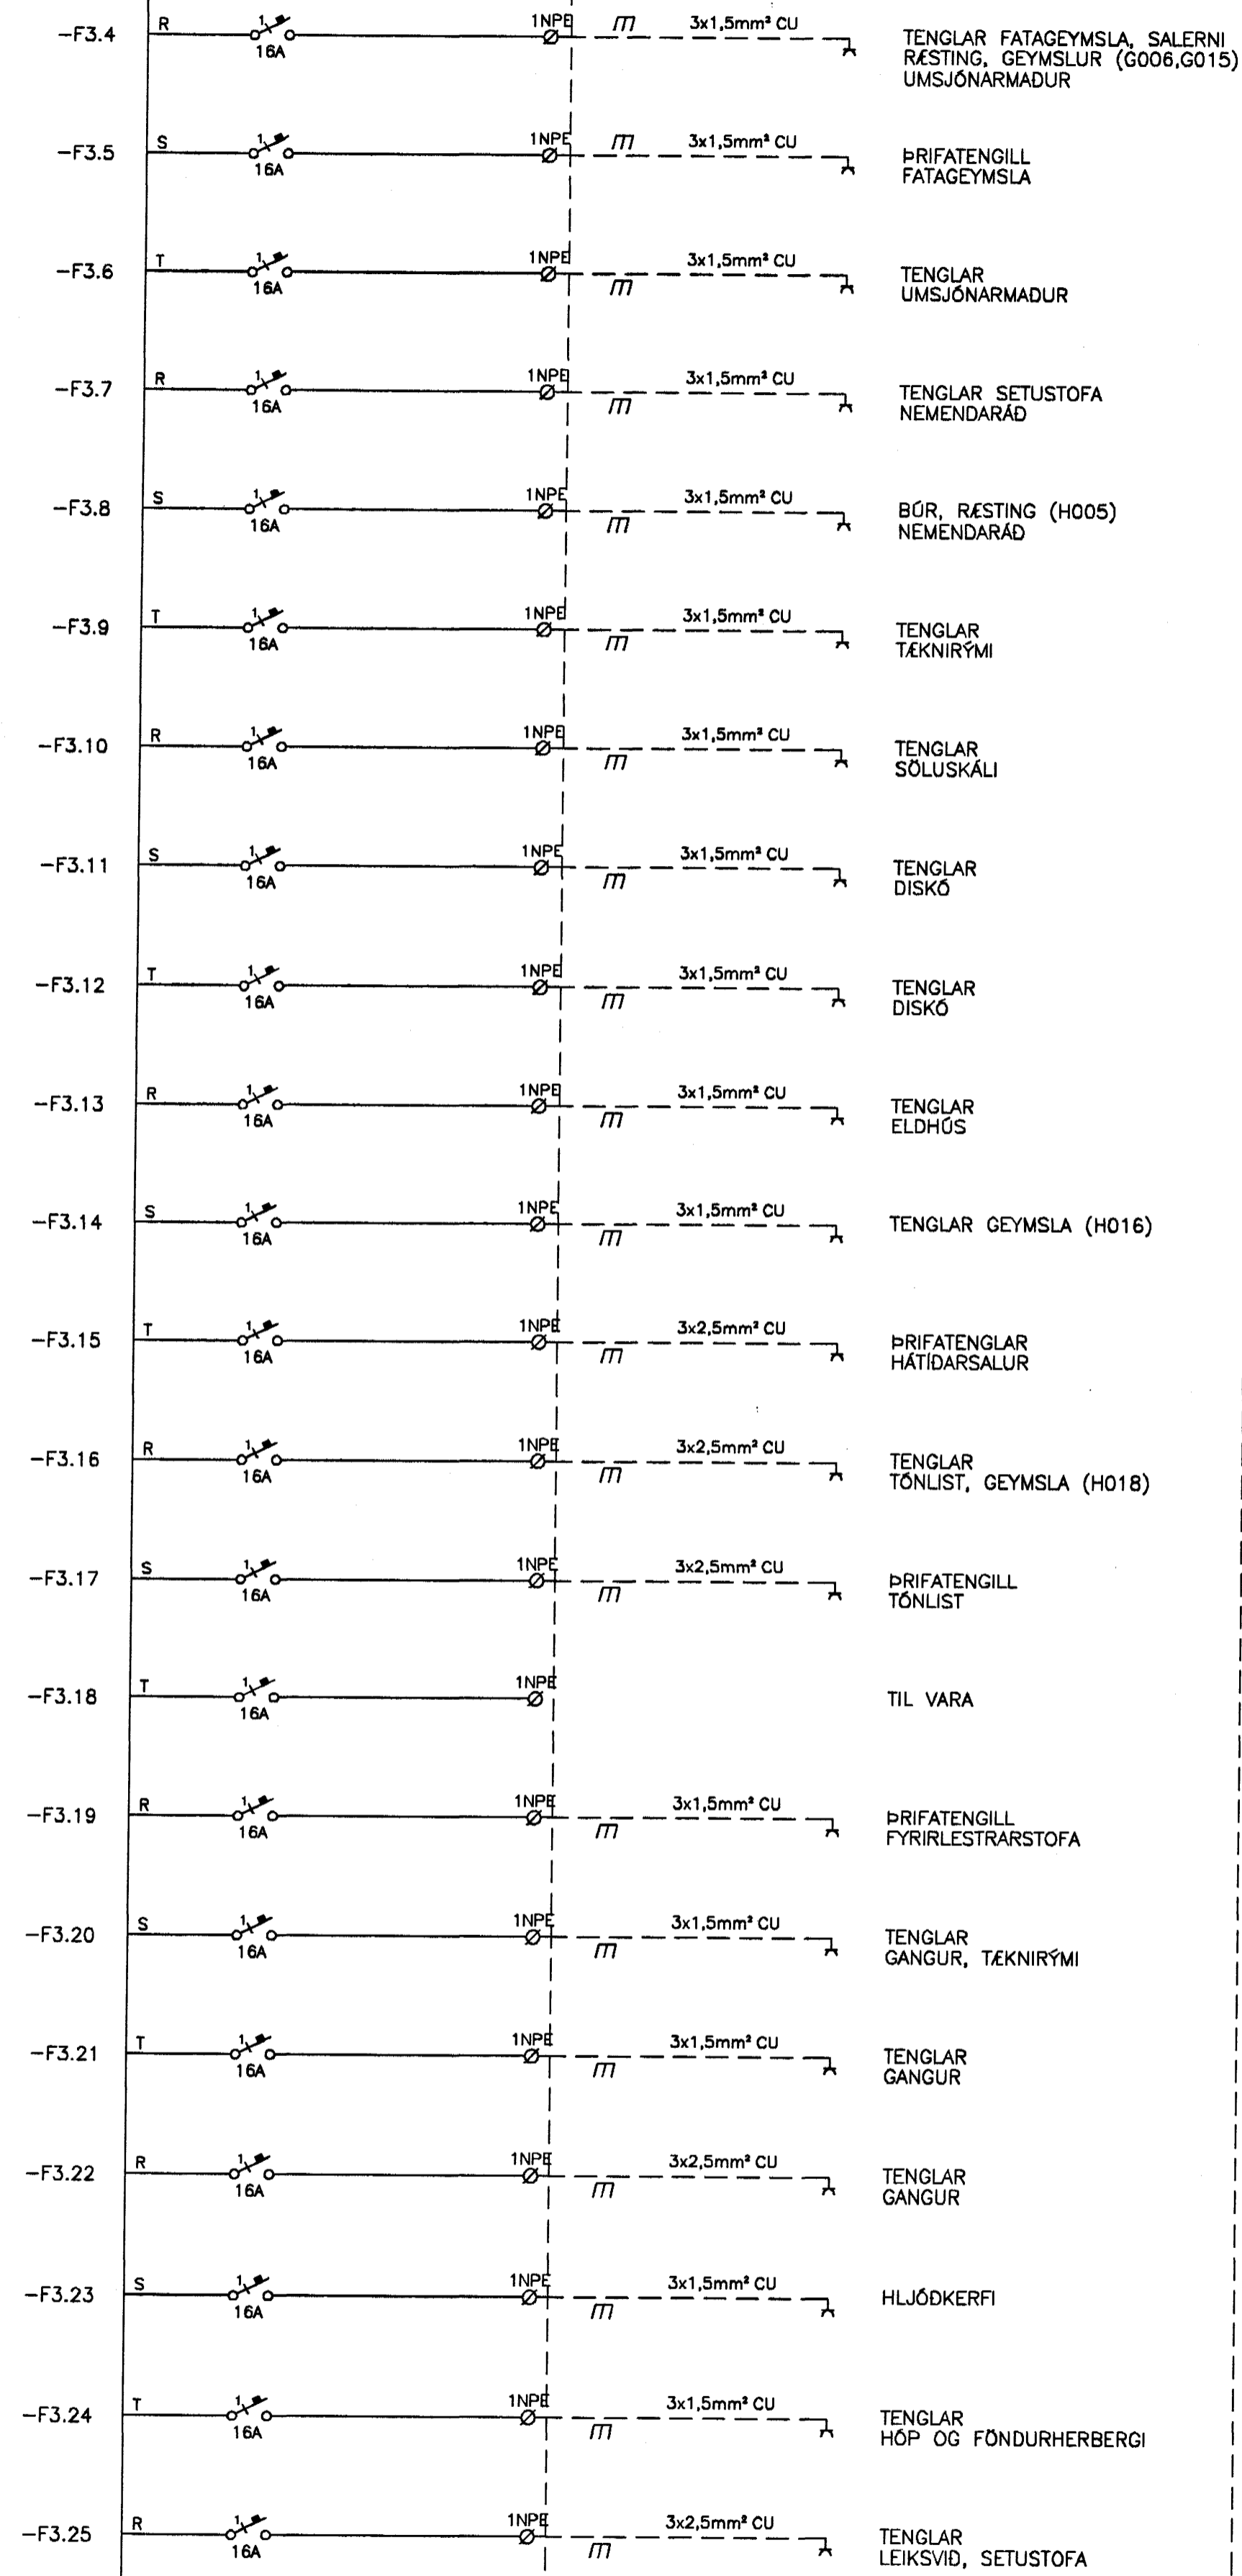

Byggingalutfrui Hafnarfjarðar  
Algrönt Mann  
// JUNI 2004  
HÓ

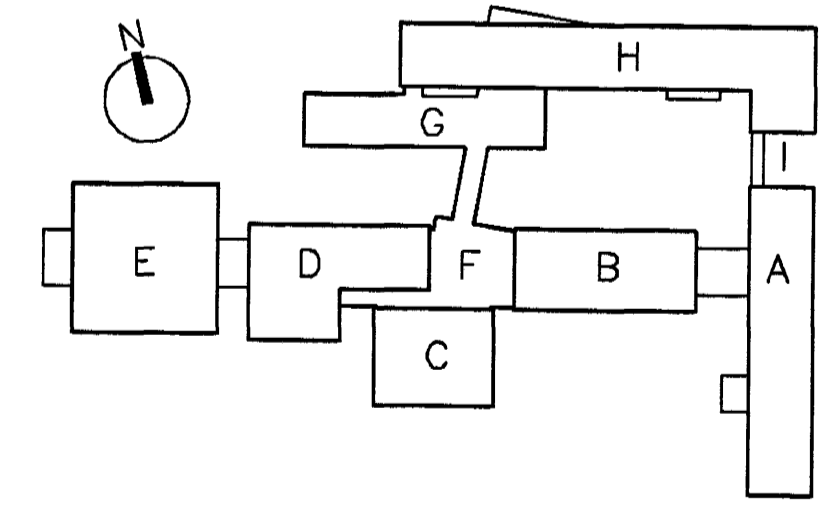

FASTEIGNAFÉLAG  
HAFNARFJARÐAR

**BATTERIÐ**

Abólsháttur  
Sigurbjörn Einarsson  
Kerfið nr. 110557-2789  
Kt. 110457-2789

B	12.03.04	RAFHITUD NIDURFOLL	LL	KGJ
A	16.01.04	FJÖLGUN GREINA, EIB SENUROFI	BSG	KGJ
ÓTG.	DAGS.	BREYTING:	HANNAD	SAMP.

HRAUNTUNGA 7, VÍDISTADASKÓLI VIDBYGGING	RAFORKLIVIRKI EINLÍNUMYND DREIFITAFLA T.O.G.1
--	---

<b>VSB VERKFRÆÐISTOFA</b>	Áritun lögg. hönnuða: Órn Guðmundsson Kt.: 220961-2739
---------------------------	---

BEJARHRAUNI 20+220 HAFNARFJÖRÐUR Heimasíða: www.vsb.is • Netfang: vsb@vsb.is Sími 565-8600 Fax 565-8610 • Kt. 710796-2899	Hannað: BSG	Teiknað: BSG
	Máli: 1:50	Yfirfarið:
Dags: 14.03.2003	Nr: 02830-R016-B	