


| DAGS:    | NR: | BREYTINGAR:                             | SAMB.: |
|----------|-----|---|--------|
| 02.04.03 | △   | HITAKERFI BREYTT OR OFNAKERFI I GOLFHTA |        |
|          |     |   |        |
|          |     |   |        |

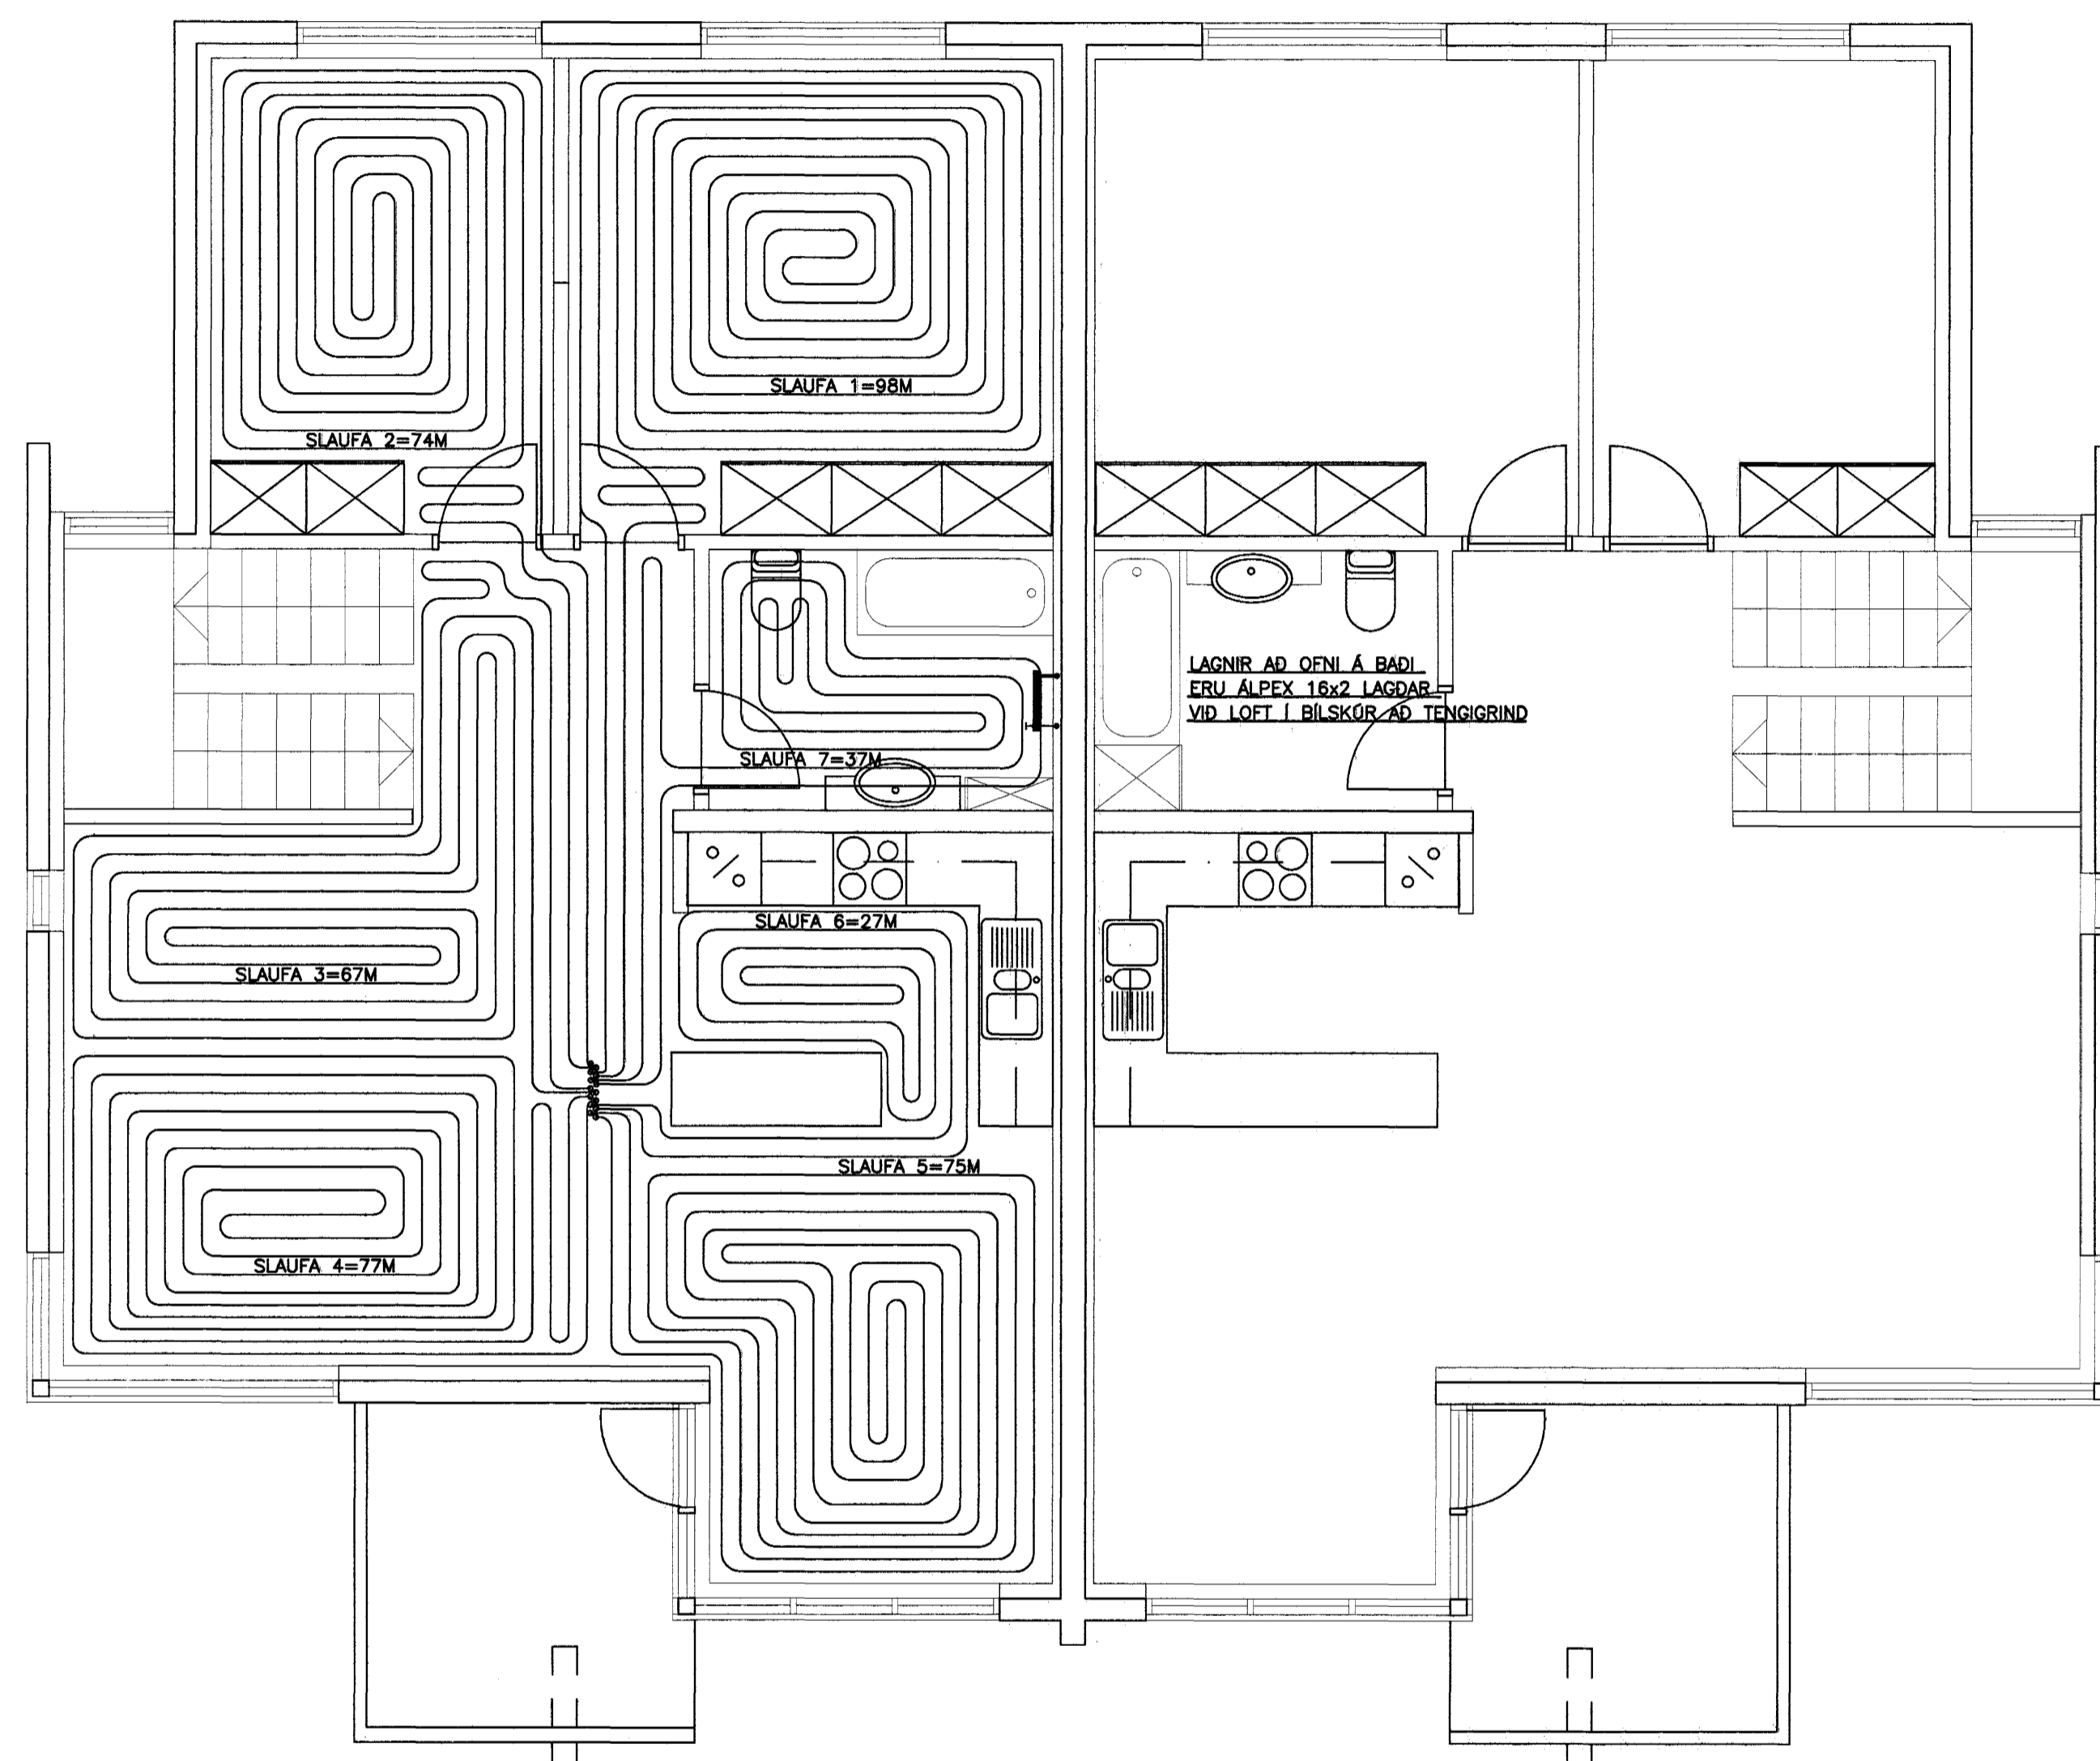

STÆRD GÓLFGEISLALAGNA ER 16x2

GÓFLAGNIR ERU LAGDAR MED 150 MM MILIBILI MED BÉTTINGU 100 MM VID VID GLUGGA SJÁ TEIKNINGU

GRUNNMYND GÓLFHTALAGNA 1:50

Byggingafræði Hálfarjörðar  
Alfreit Þann  
07 APR. 2004  
VFS.

Móttaki: RISK  
Samb. 70404  
Hm

VERKFRÆÐIÞJÓNUSTAN EHF



|                                 |                                |          |
|---------------------------------|--------------------------------|----------|
| REYNIHÁMMUR 3a<br>HAFNARFJÖRDUR | 03.25                          | 02.04.04 |
| HITAKERFI:                      | STEYPT HÖS                     | 521      |
| GRUNNMYND:                      | Jón Guðmundsson<br>280255-4329 | L1       |
| 2. HEB                          |                                | 1:50     |
| 511                             |                                |          |