



ADALTAFLA T.O.A.1

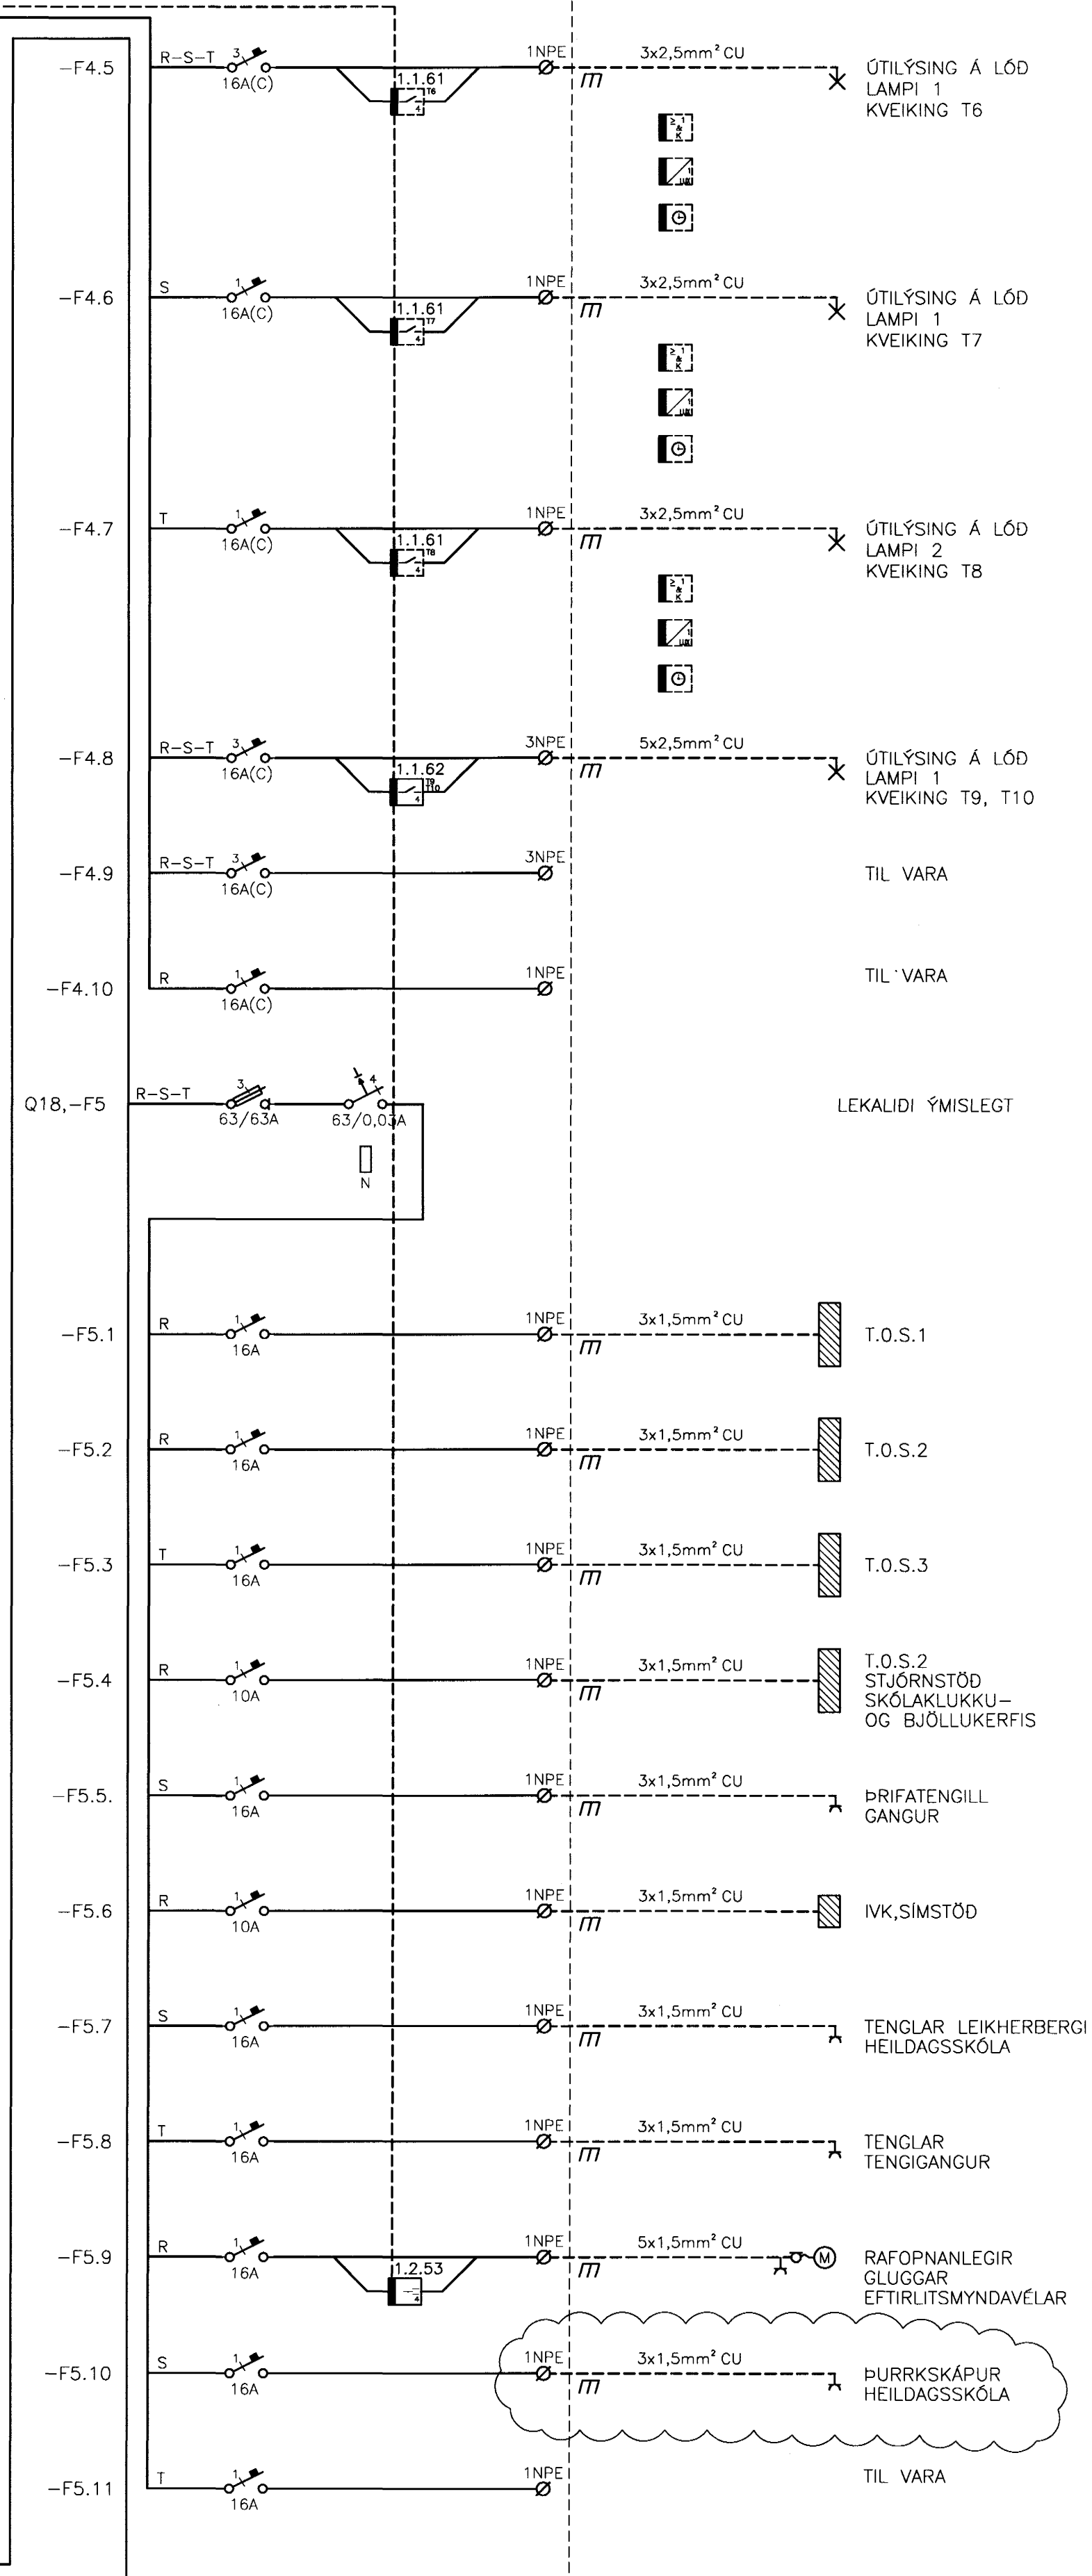

SJÁ TEIKN. B2-R1-VE0-002

15/7/03 DC 071070-5069

A 26.03.03 BREYTING VEGNA ÞURRSKAPS		JJ	LL
BR.	DAGS.	BREYTING	REIKN. TEIKN.

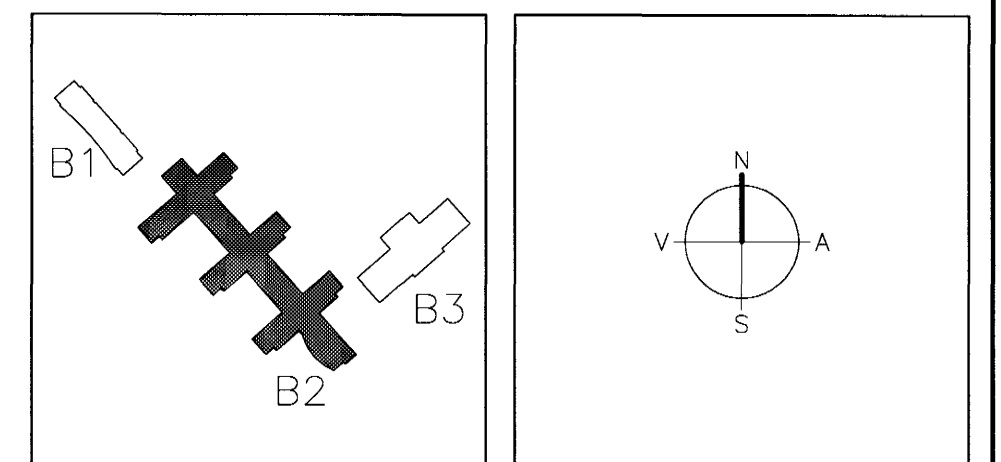

ARKITEKTAR
BERGSTADASTRÆTI 10, RVK.
sími:551-1460, netfang:arkitekt@ishoff.is

FINNUR BJÖRGVINSSON
HILMAR ÞÓR BJÖRNSSON
SIGRÍÐUR ÓLAFSDÓTTIR

LANDMÓTUN.
EINAR E. SÆMUNDSEN
INGIBJÖRG KRISTJÁNSDÓTTIR
MARGRÉT SIGURDARDÓTTIR

NYBYLAVEGUR 6 - 200 KÖPAVOGUR - Sími: 554 5300 - Fax: 554 5300 - Netfang: landmotun@landmotun.is

VSÓ RÁÐGJÖF

BORGARTÚN 20, 105 REYKJAVÍK, Sími: 585-9000, Símbreyf: 585-9010, Netfang: vs@vs.is

SÓLVANGSVEGUR 4
LÆKJARSKÓLI

RAFORKUVRKI	HANNAÐ/TEIKN.	JJ/LL
EINLÍNUNYND	ATH. <i>[Signature]</i>	
ADALTAFLA KJALLARA	SAMÞYKKT	
T.O.A.1	KT. <i>[Signature]</i>	110806-7780

KVARNR.	TEIKN. NR.	BR.
00258	B2-R1-VE0-003	A