



DREIFITAFLA T.O.G.1

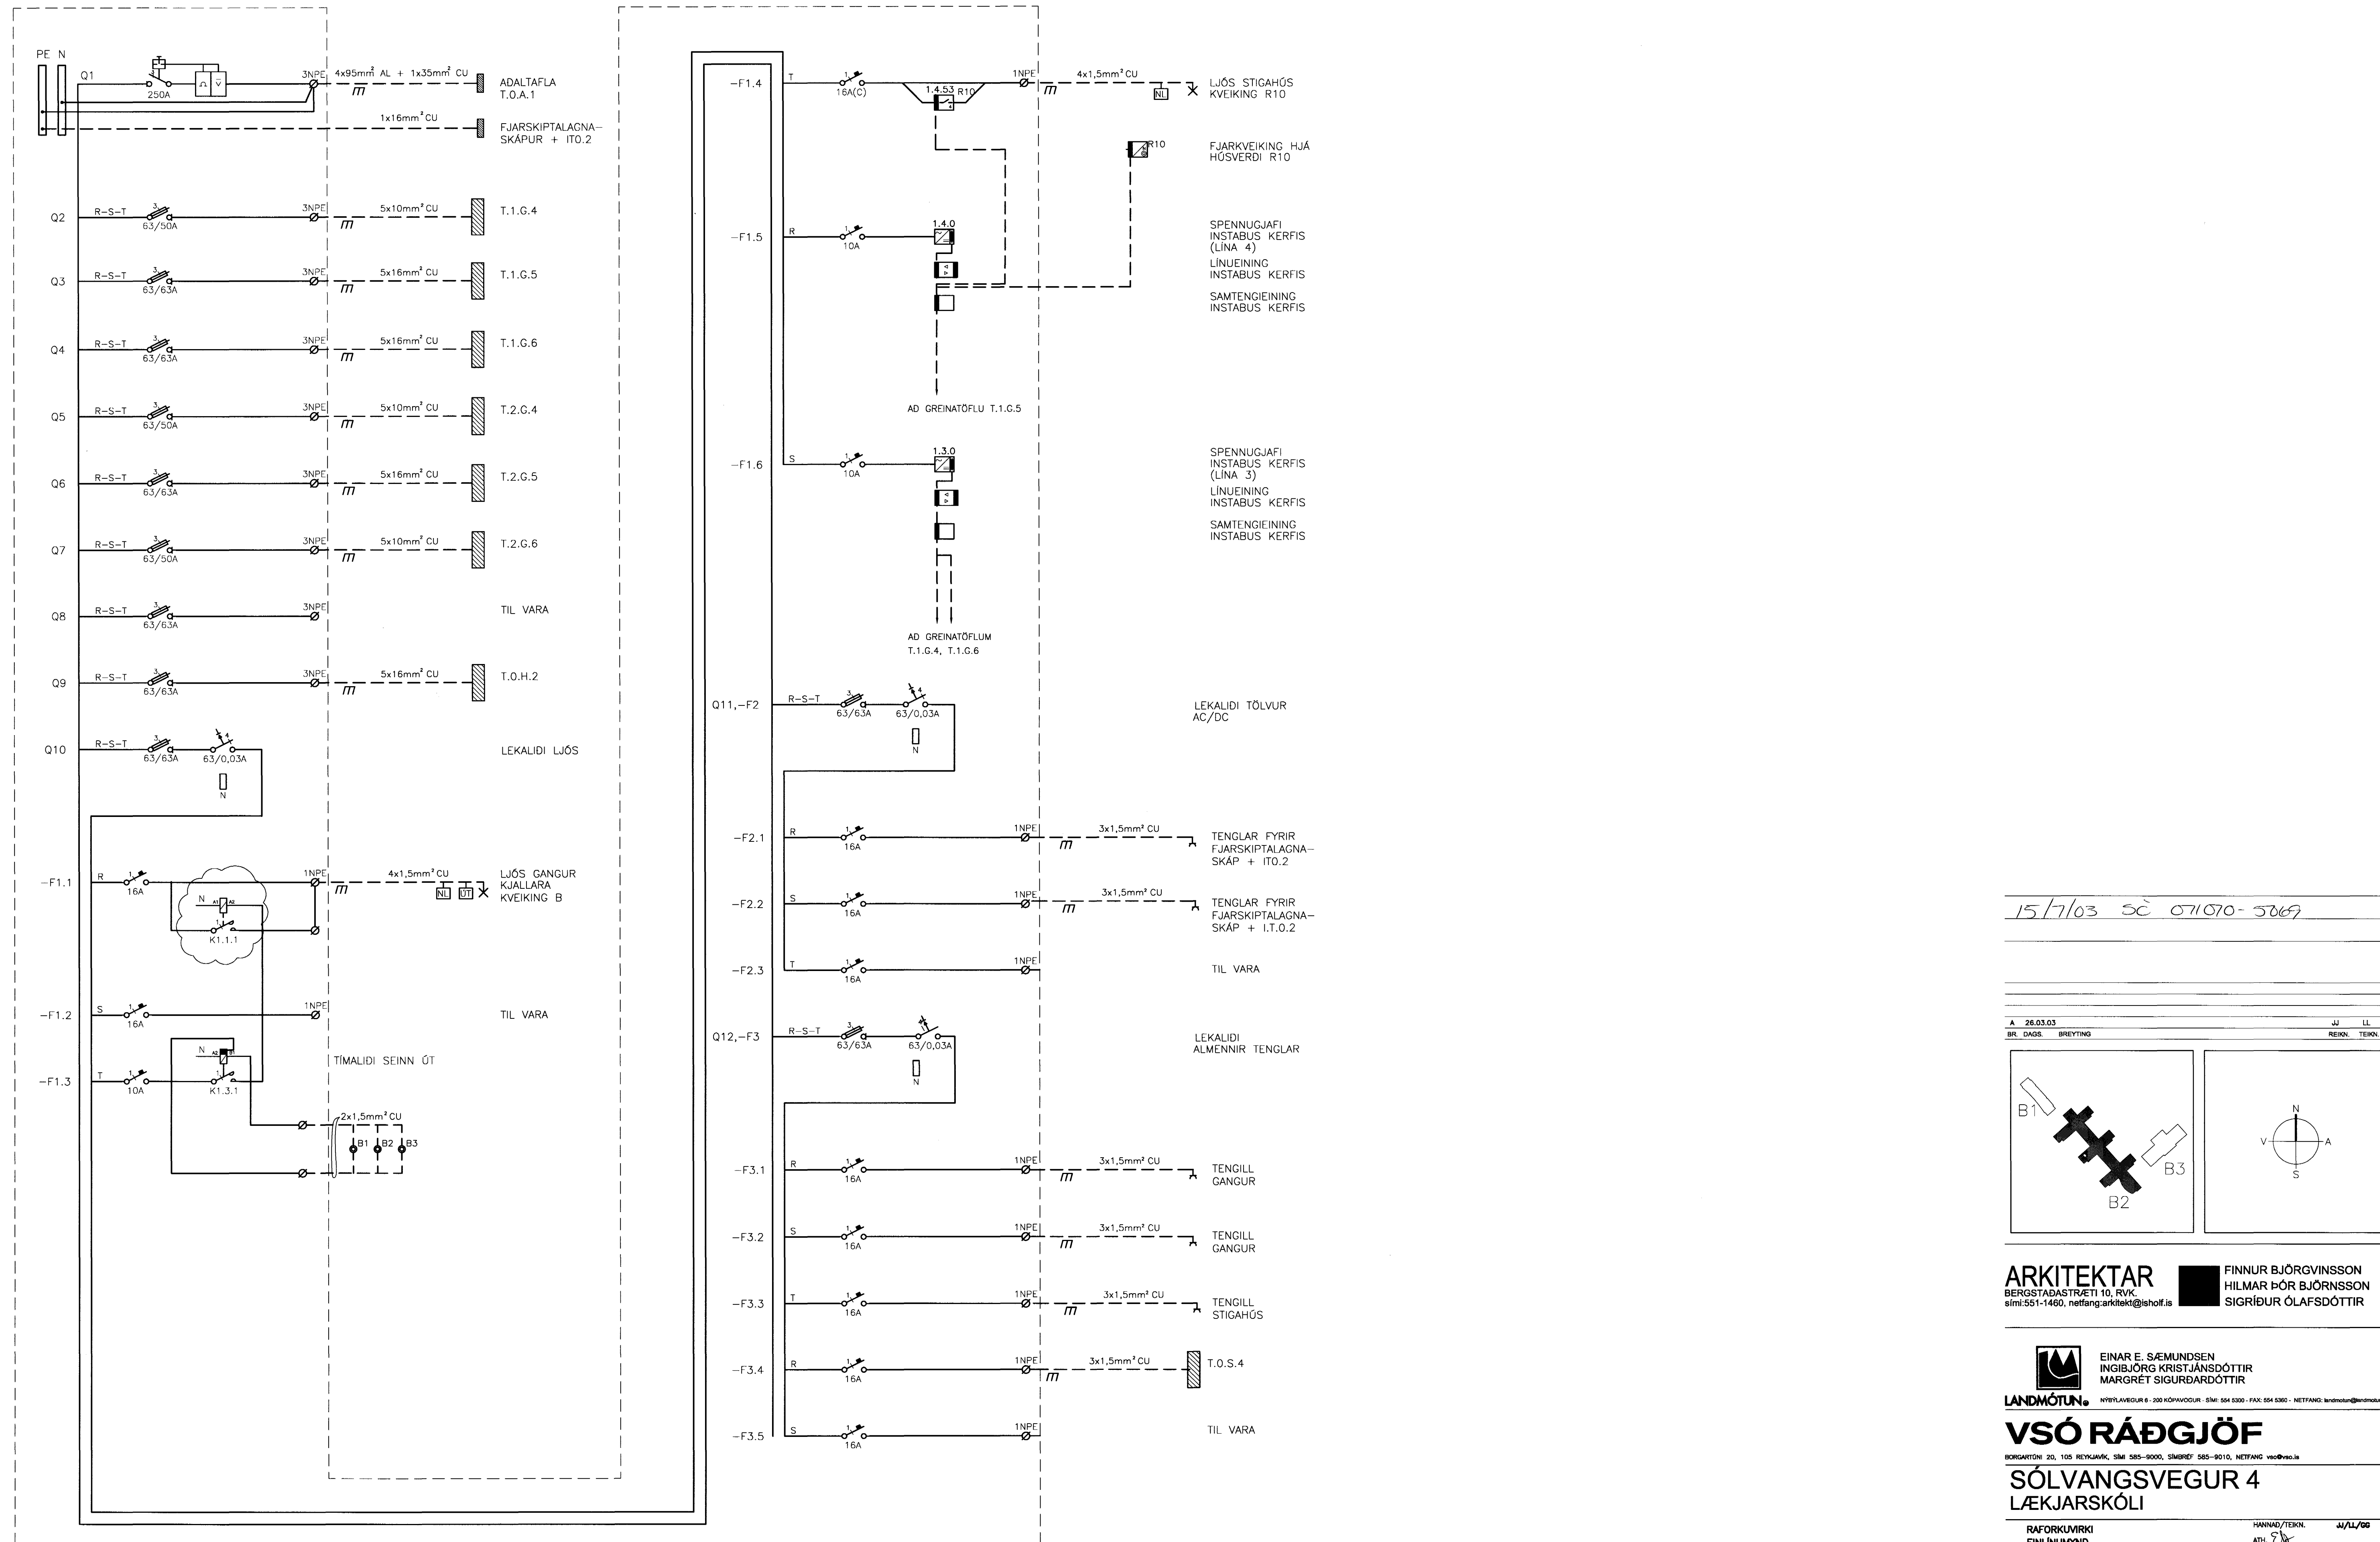

15/7/03 SC 071070-5069

A	26.03.03				
BR.	DAGS.	BREYTING		REIKN.	TEIKN.

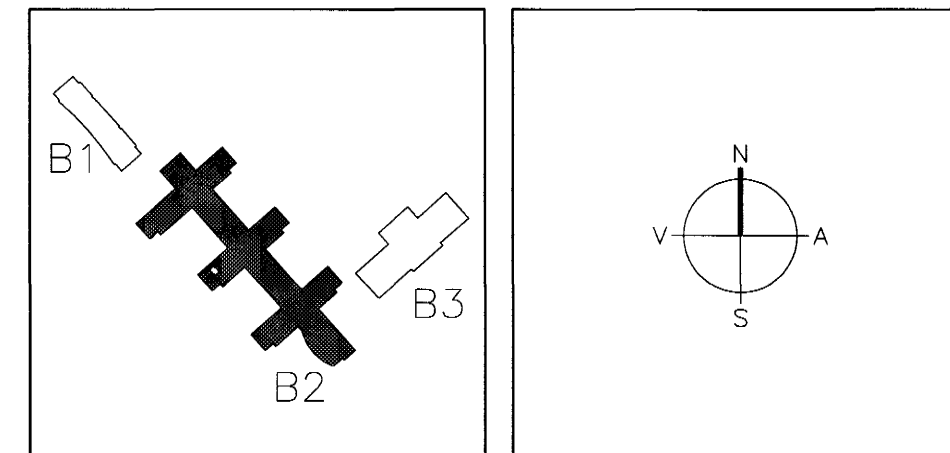

ARKITEKTAR
 BERGSTADASTRÆTI 10, RVK.
 sími: 551-1460, netfang: arkitekt@ishoff.is

FINNUR BJÖRGVINSSON
HILMAR ÞÓR BJÖRNSSON
SIGRÍÐUR ÓLAFSDÓTTIR

LANDMÖTUN.
 NYBÍLAVEÐUR 8 - 200 KÓPAVOGUR. Sími: 554 5300 - Faxe: 554 5362 - Netfang: landmotun@landmotun.is

EINAR E. SÆMUNDSEN
INGIBJÖRG KRISTJÁNSDÓTTIR
MARGRÉT SIGURDARDÓTTIR

VSÓ RÁÐGJÖF
 BORGARTÚNI 20, 105 REYKJAVÍK. Sími: 585-9000, Símbreyti: 585-9010, Netfang: vs@vs.is

SÓLVANGSVEGUR 4
LÆKJARSKÓLI

RAFORKUWIRKI	HANNAÐ/TEIKN.	JJ/LL/06
EINLIÐNUMYND	ATH.	
DREIFITAFLA KJALLARA	SAMÞYKKT	
T.O.G.1	KT.	110856-7789
KVARDI	REYKJAVÍK	15.08.2002
VERKNR.	TEIKN. NR.	
00258	B2-R1-VE0-004	A