



DREIFITAFLA T.O.G.2

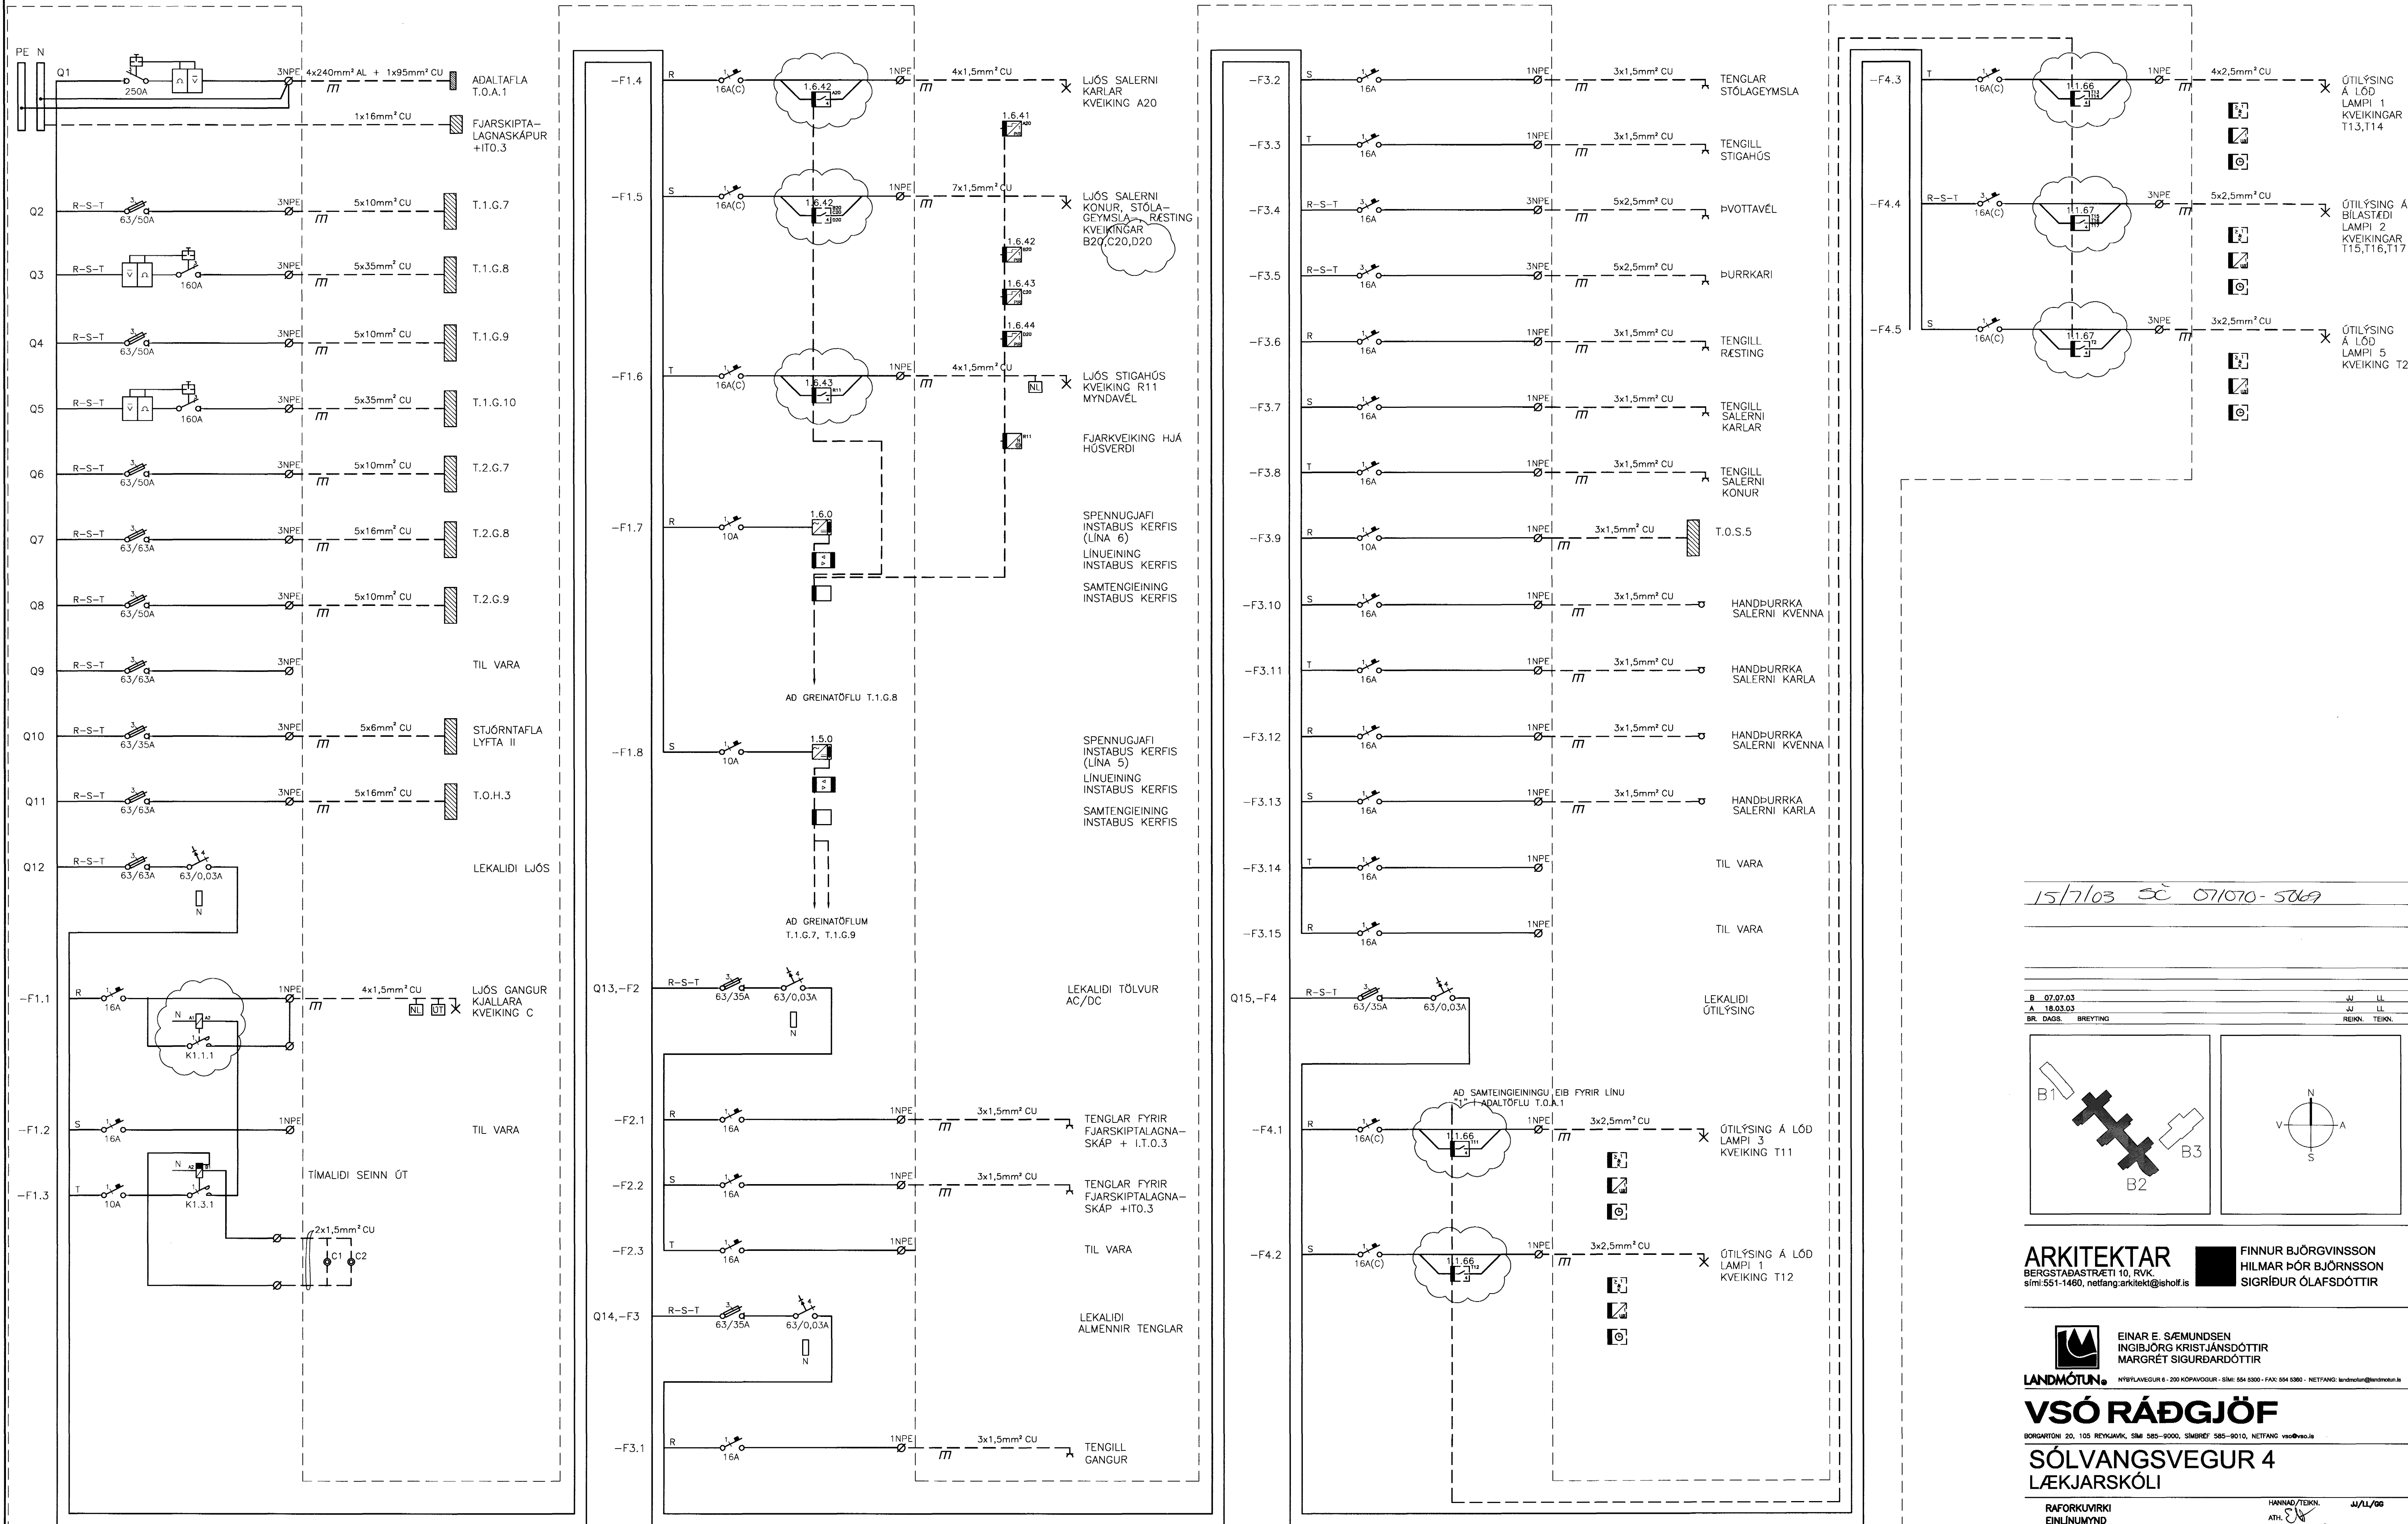

15/7/03 SC 071070-5069

B	07.07.03	JJ	LL
A	18.03.03	JJ	LL
BR.	DAGS.	ÞREYTING	REIKN. TEIKN.

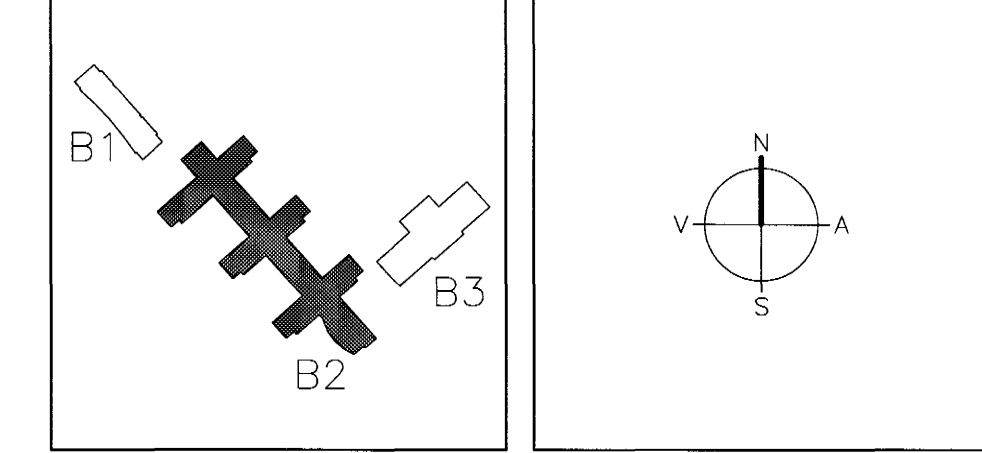

ARKITEKTAR
BERGSTADASTRÆTI 10, RVK
sími:551-1480, netfang:arkitekti@ishof.is

FINNUR BJÖRGVINSSON
HILMAR ÞÓR BJÖRNSSON
SIGRÍÐUR ÓLAFSDÓTTIR

LANDMÖTUN. EINAR E. SÆMUNDSEN
INGIBJÖRG KRISTJÁNSDÓTTIR
MARGRÉT SIGURDARDÓTTIR

NYBYLVAEGUR 6 · 200 KÓPAVOGUR · Sími 554 9300 · FAX 554 9360 · NETFANG: landmotun@landmotun.is

VSÓ RÁDGJÖF
BORGARTOWN 20, 105 REYKJAVÍK, Sími 585-9000, Símbret 585-9010, NETFANG vs@vso.is

SÓLVANGSVEGUR 4
LÆKJARSKÓLI

RAFORKUVRKI
EINLÍNUMYND
DREIFITAFLA KJALLARA
T.O.G.2

HANNA/TEIKN. JJ/LL/06
ATH. C
SAMÞRKT
KT. 110856-7789
REYKJAVÍK
18.05.2002

KVARNR. VERKNR. BR.

00258 B2-R1-VE0-005 B