



TAFLA T.1.G.2

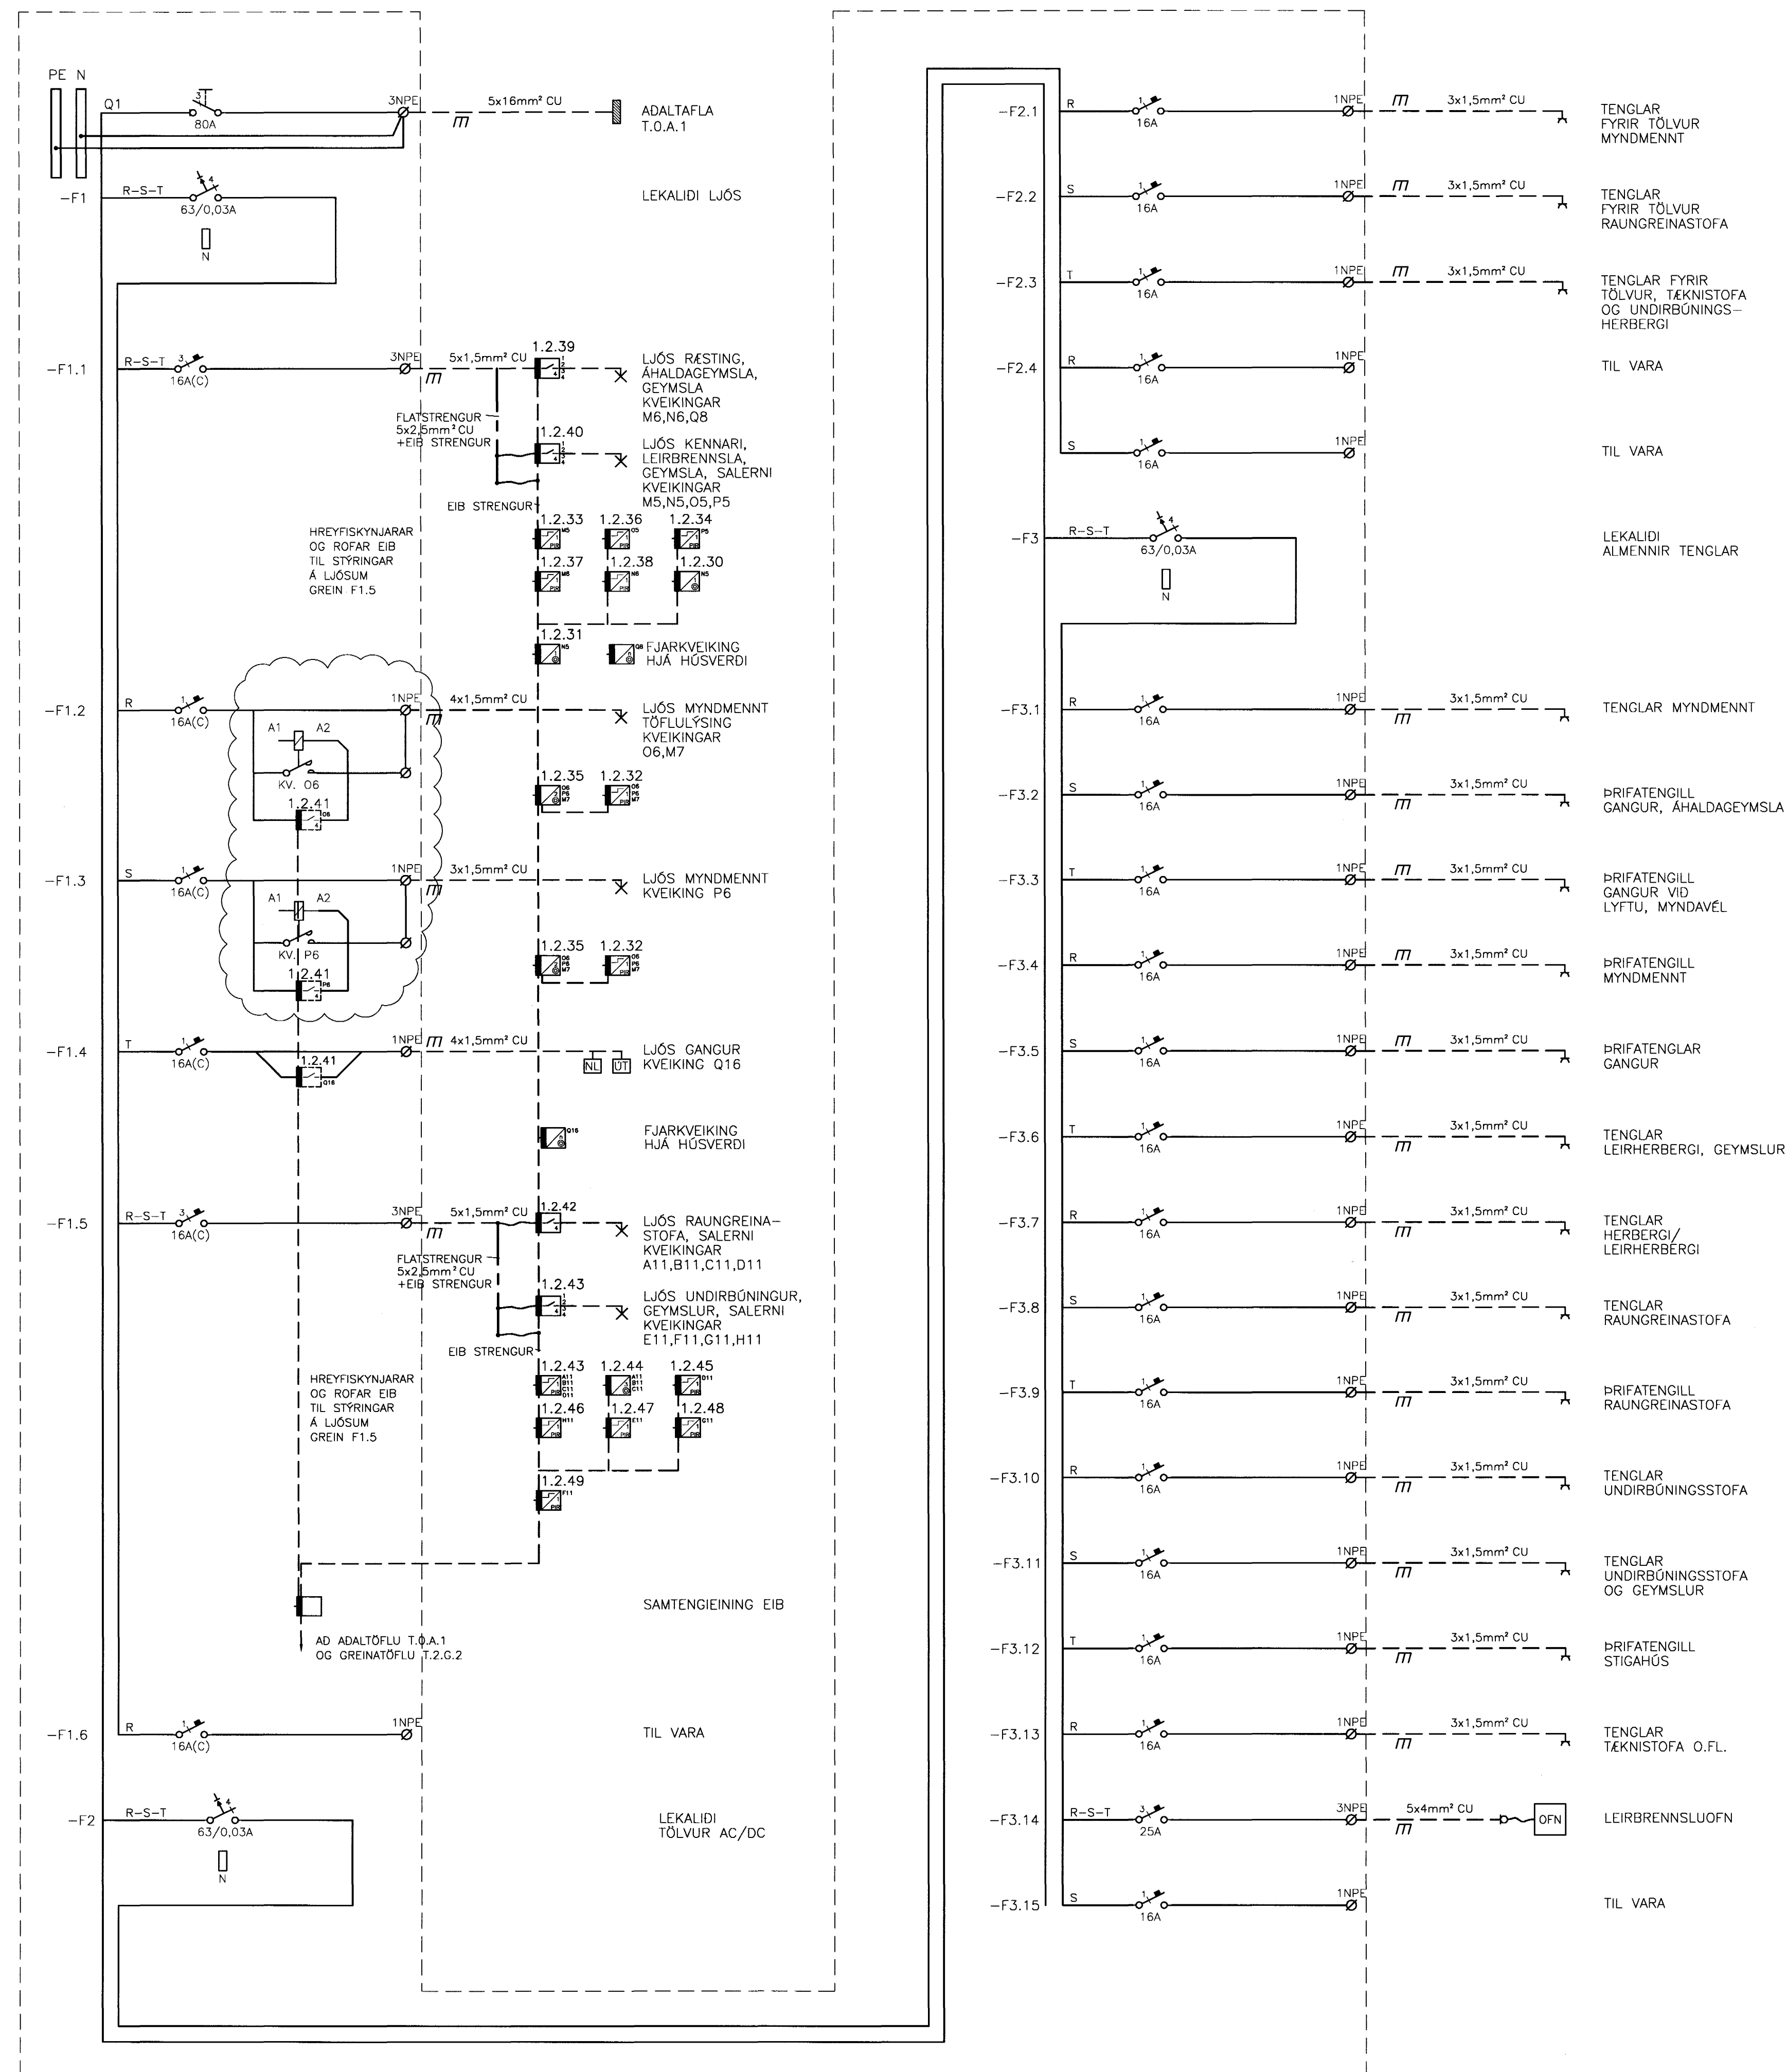

15/7/03 SC 071070-5069

A 07.07.03 VIBBÓT SPÖLURÓFAR 16A-230V JJ LL
BR. DAGS. BREYTING REIN. TEIN.

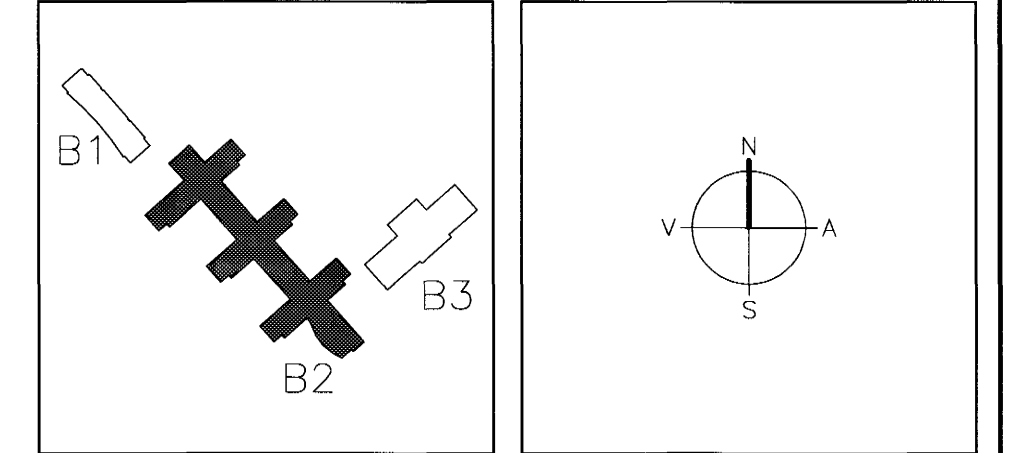

ARKITEKTAR FINNUR BJÖRGVINSSON
BERGSTADASTRÆTI 10, RVK. HILMAR ÞÓR BJÖRNSSON
sími:551-1460, netfang:arkitekt@isholf.is SIGRÍÐUR ÓLAFSDÓTTIR

LANDMÖTUN. EINAR E. SÆMUNDSEN
INGIBJÖRG KRISTJÁNSDÓTTIR
MARGRÉT SIGURDARDÓTTIR
HAFNAD/TEIN. SAMÞYKKT
NETFANG: landmotun@landmotun.is

VSÓ RÁÐGJÖF
BORGARTÚN 20, 105 REYKJAVÍK. Sími 585-9000, Símbreyf 585-9010, Netfang vs@vs.is
SÓLVANGSVEGUR 4
LÆKJASKÓLI

RAFORKLIVIRKI HANNAÐ/TEIN. JJ/LL
EINLÍNUNYND ATH. SK
GREINATAFLA 1. HÆÐ SAMÞYKKT SK
T.1.G.2 KT. 110856-7789
KVARDI REYKJAVÍK 15.06.2002
VERNR. TEINR. NR. BR. A
00258 B2-R1-VE1-002