

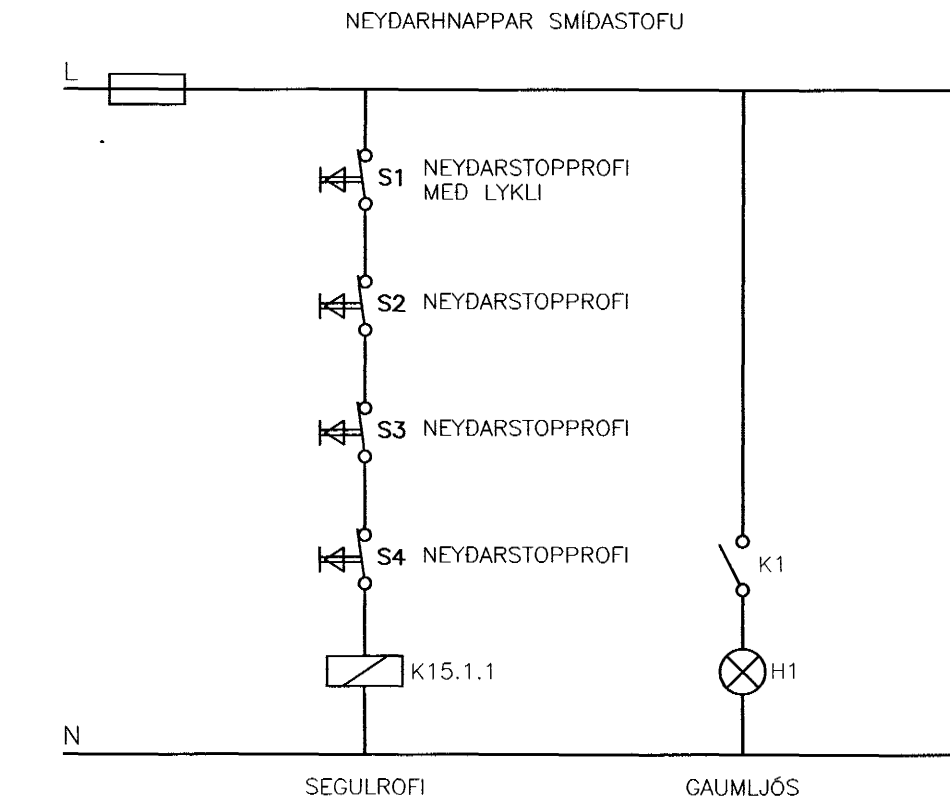


TAFLA T.1.G.3

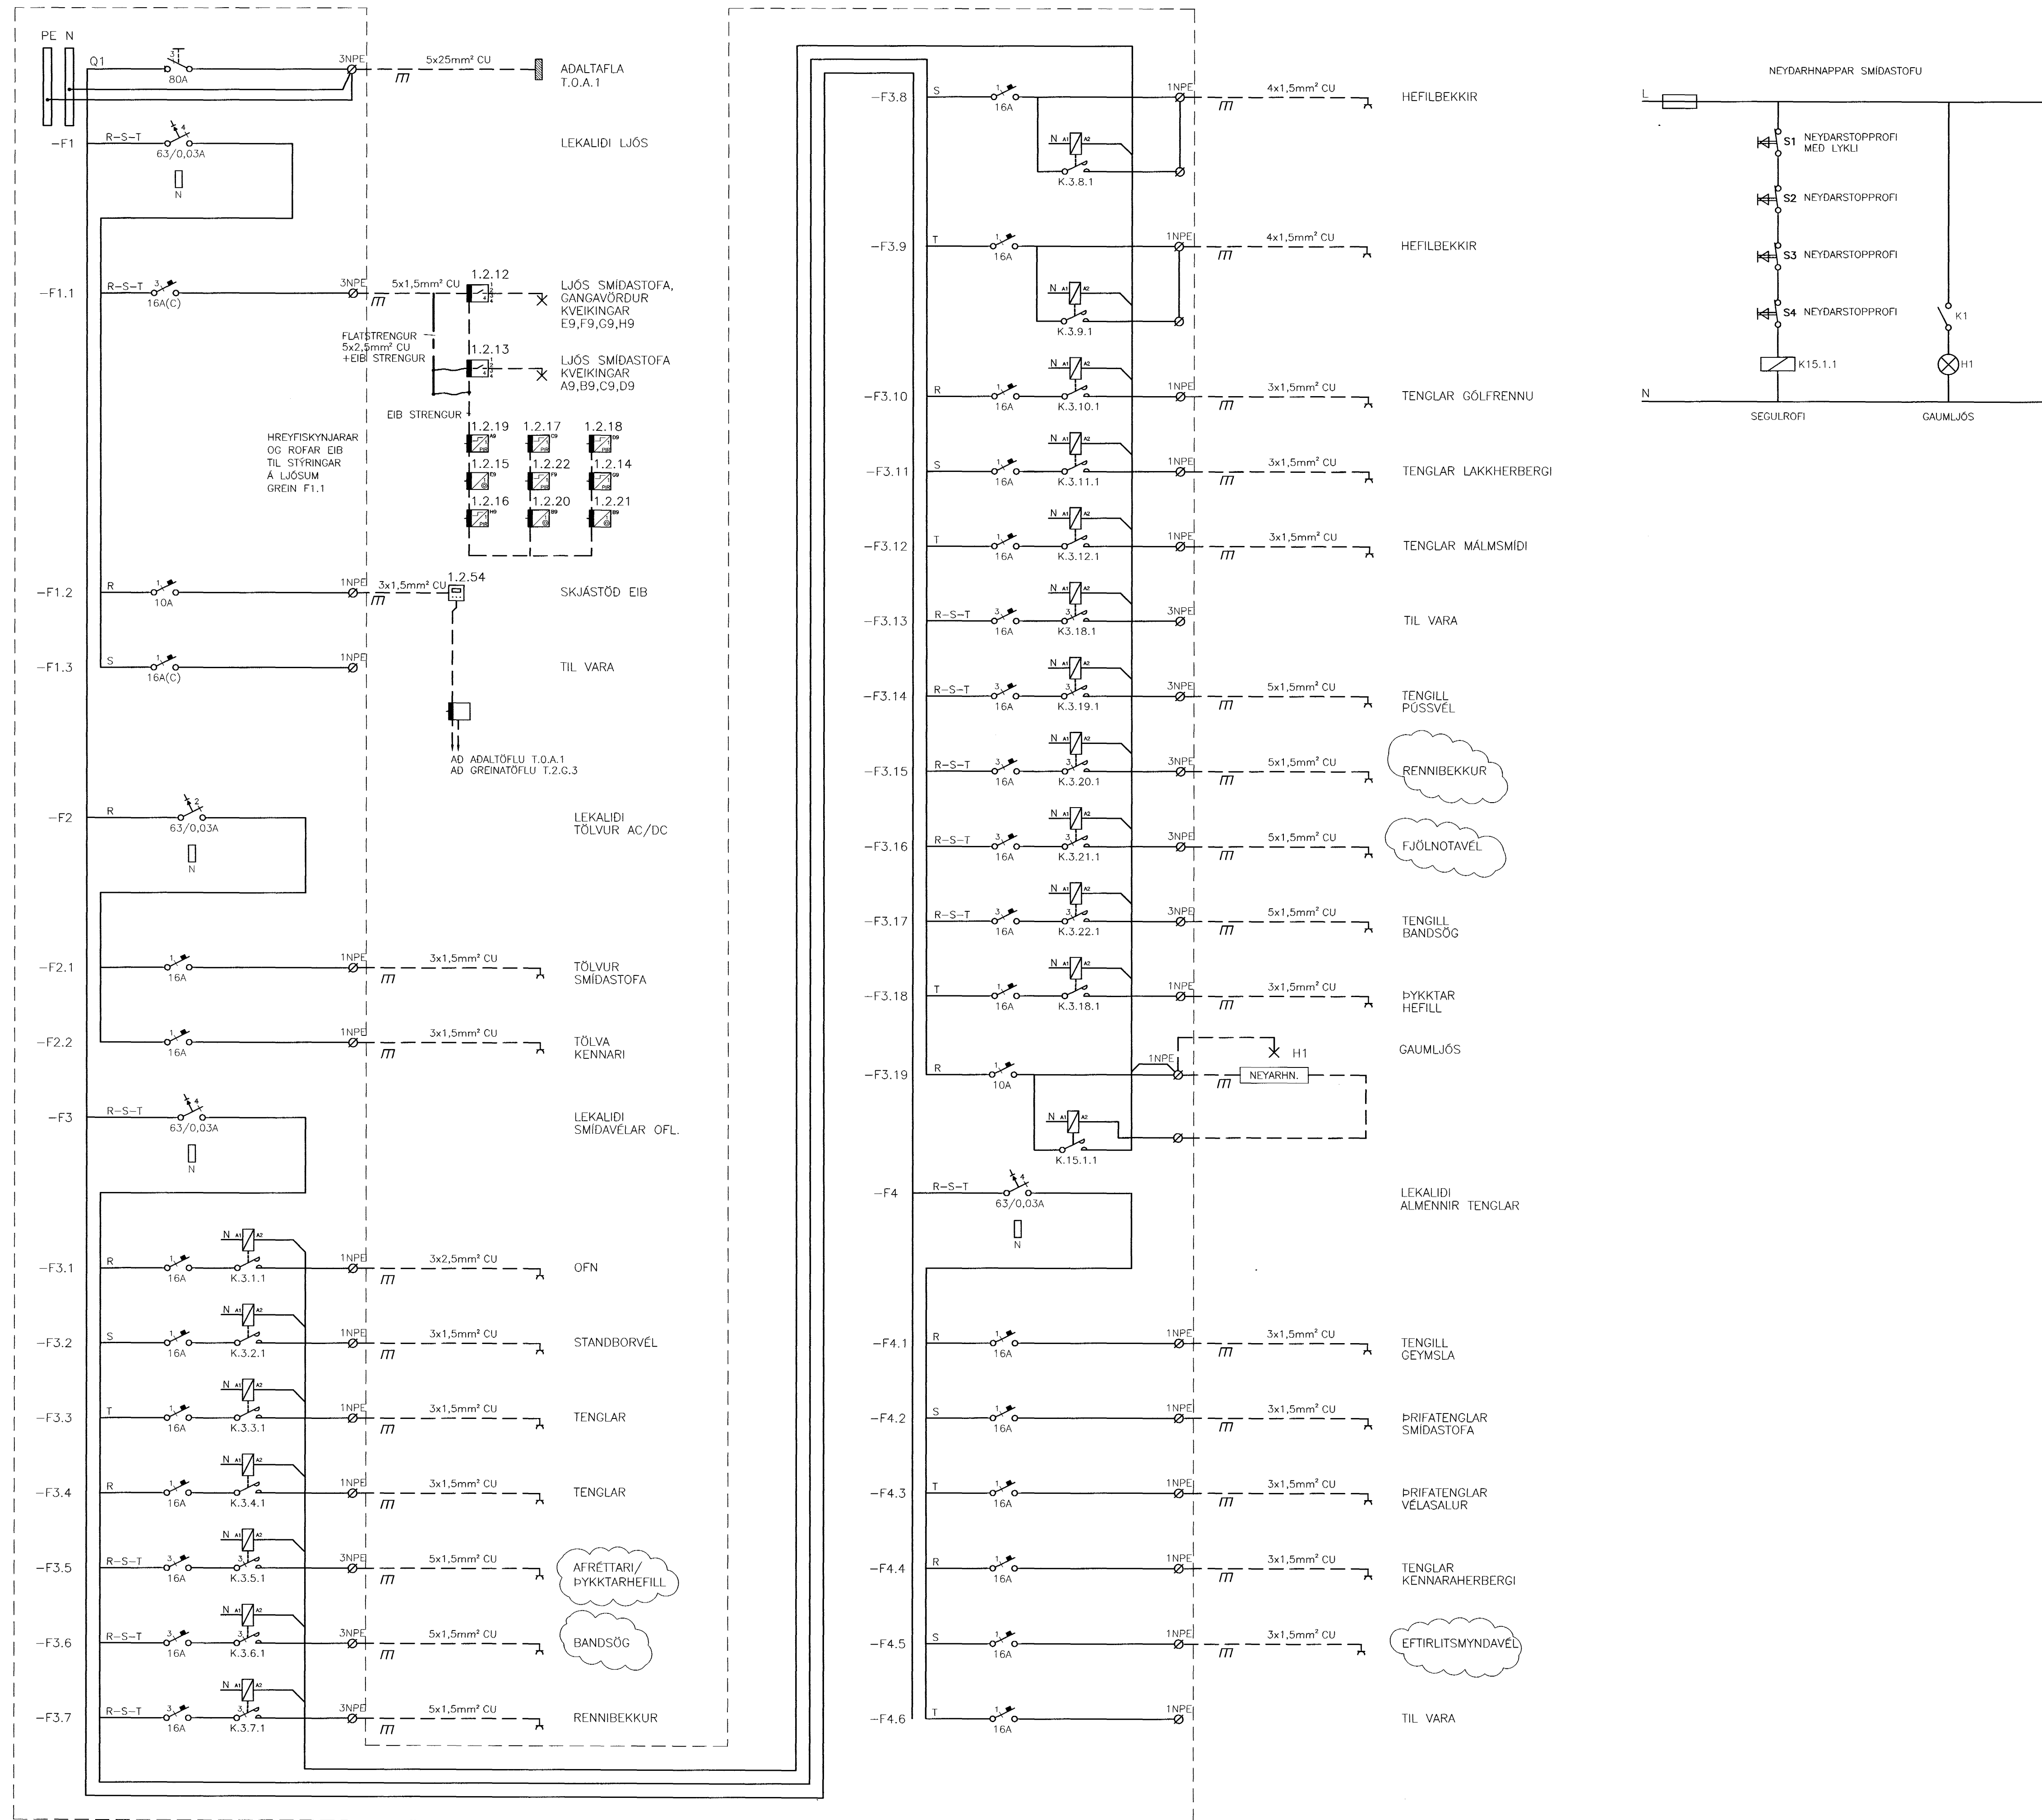

15/7/03 SÚ 071070-5067

A 07.07.03 STJÓRNENNING REYKLOGUR
BR. DAGS. BREYTING

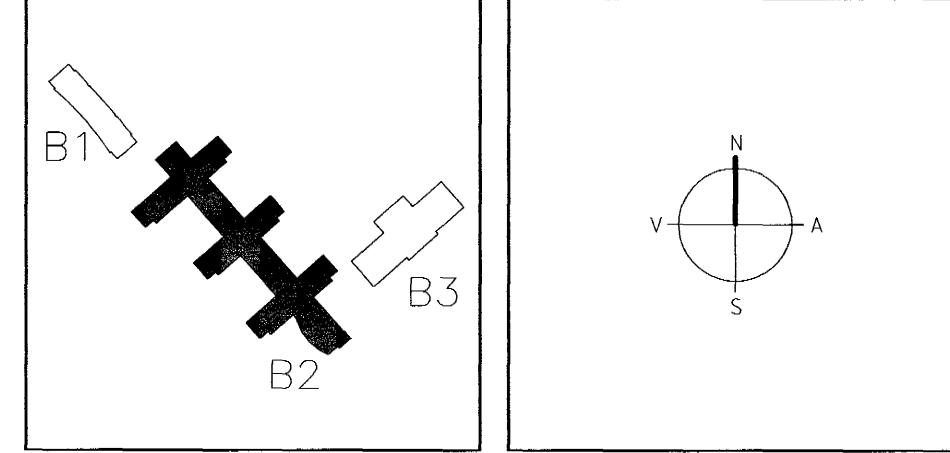

ARKITEKTAR
BERGSTADASTRÆTI 10, RVK
sími: 551-1460, netfang: arkitekt@ishoff.is

FINNUR BJÖRGVINSSON
HILMAR ÞÓR BJÖRNSSON
SIGRÍÐUR ÓLAFSDÓTTIR

LANDMÖTUN.
EINAR E. SÆMUNDSEN
INGIBJÖRG KRISTJÁNSDÓTTIR
MARGRÉT SIGURDÁRSDÓTTIR

VSÓ RÁÐGJÖF
BORÐARTÓMI 20, 105 REYKJAVÍK, Sími 585-9000, SMÍÐRYF 585-9010, NETFANG: landmotun@landmotun.is

SÓLVANGSVEGUR 4
LÆKJASKÓLI

RAFÖRNUMER
EINLIÐUMYND
GREINATAFLA 1. HÆÐ
T.1.G.3

HANNAÐ/TEK.N.
ATH. *SK*
SAMPYKKT
KT. *SÚ*
REYKJAVÍK
15.08.2002

KVARNR.
VERNRN.
00258

TEK.NR.
B2-R1-VE1-003

BR.
A