



TAFLA T.1.G.5

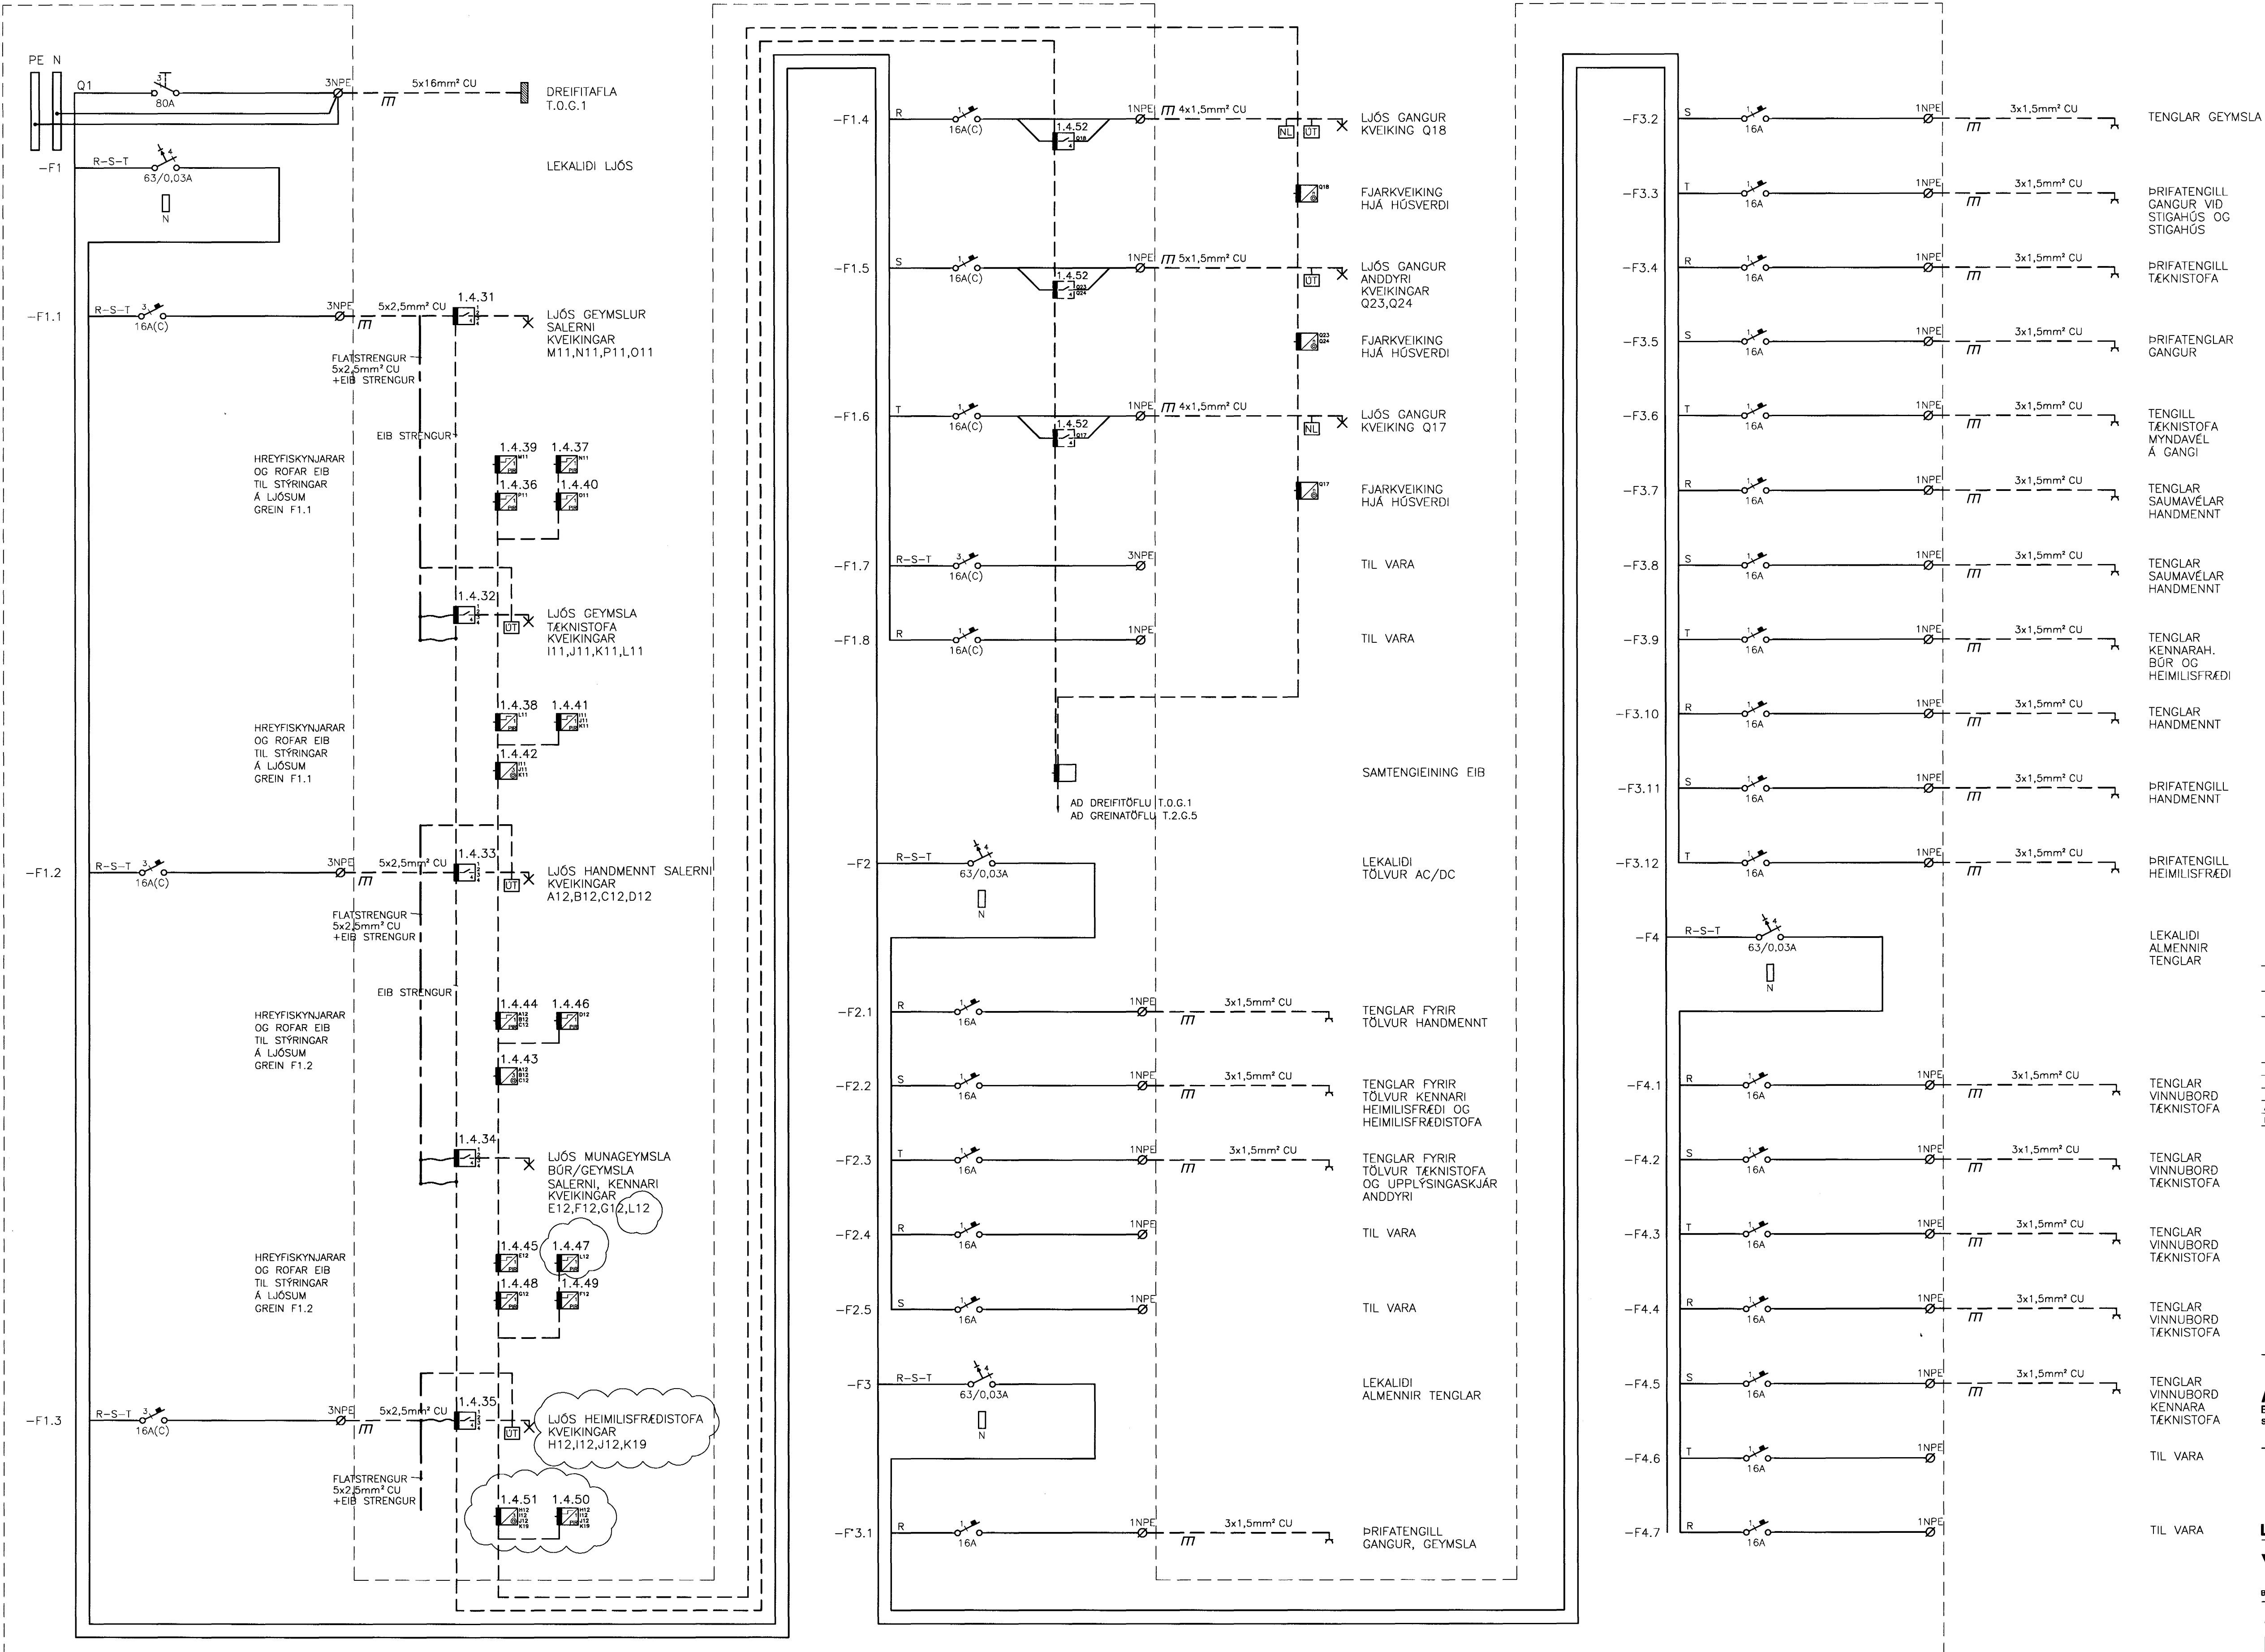

15/7/03 SC 071070-5069

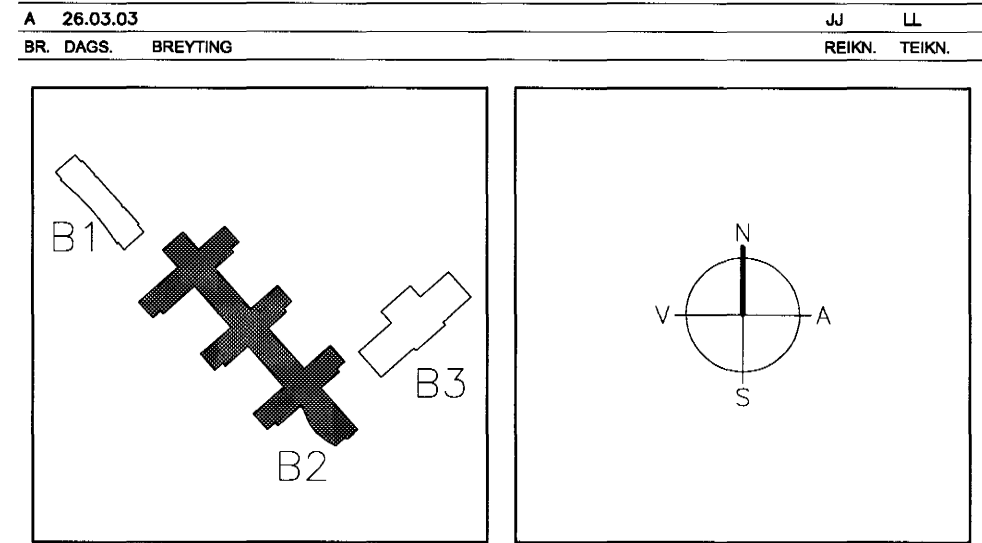

**ARKITEKTAR** BERGSTADASTRÆTI 10, RVK, sími:551-1460, netfang:arkitekt@shof.is

**FINNUR BJÖRGVINSSON** HILMAR ÞÓR BJÖRNSSON SIGRÍÐUR ÓLAFSDÓTTIR

**LANDMÖTUN.** EINAR E. SÆMUNDSEN INGIBJÖRG KRISTJÁNSDÓTTIR MARGRÉT SIGURDARDÓTTIR

NYRRAVEGUR 8 - 200 KÖPAVOGUR - Sími: 554 5300 - FAK: 554 5380 - NETFANG: landmotun@landmotun.is

**VSÓ RÁÐGJÖF**

BRATTARONI 20, 105 REYKJAVÍK, Sími: 585-9000, Símbref: 585-9010, Netfang: vsoradgjof.is

**SÓLVANGSVEGUR 4** LÆKJASKÓLI

RAFORKUMRKI ENILINUMYND GREINATAFLA 1. HED T.1.G.5

HANNAÐ/TEKNI 4/11/005

ATH: SJK SLP

SMÞYKKT

KT. 110806-7789

REYKJAVÍK

15.05.2002

VERNRN. 00258

TEKNI. NR. B2-R1-VE1-005

BR. A